


#1584

NW cor. of Rockford Colony Subd.

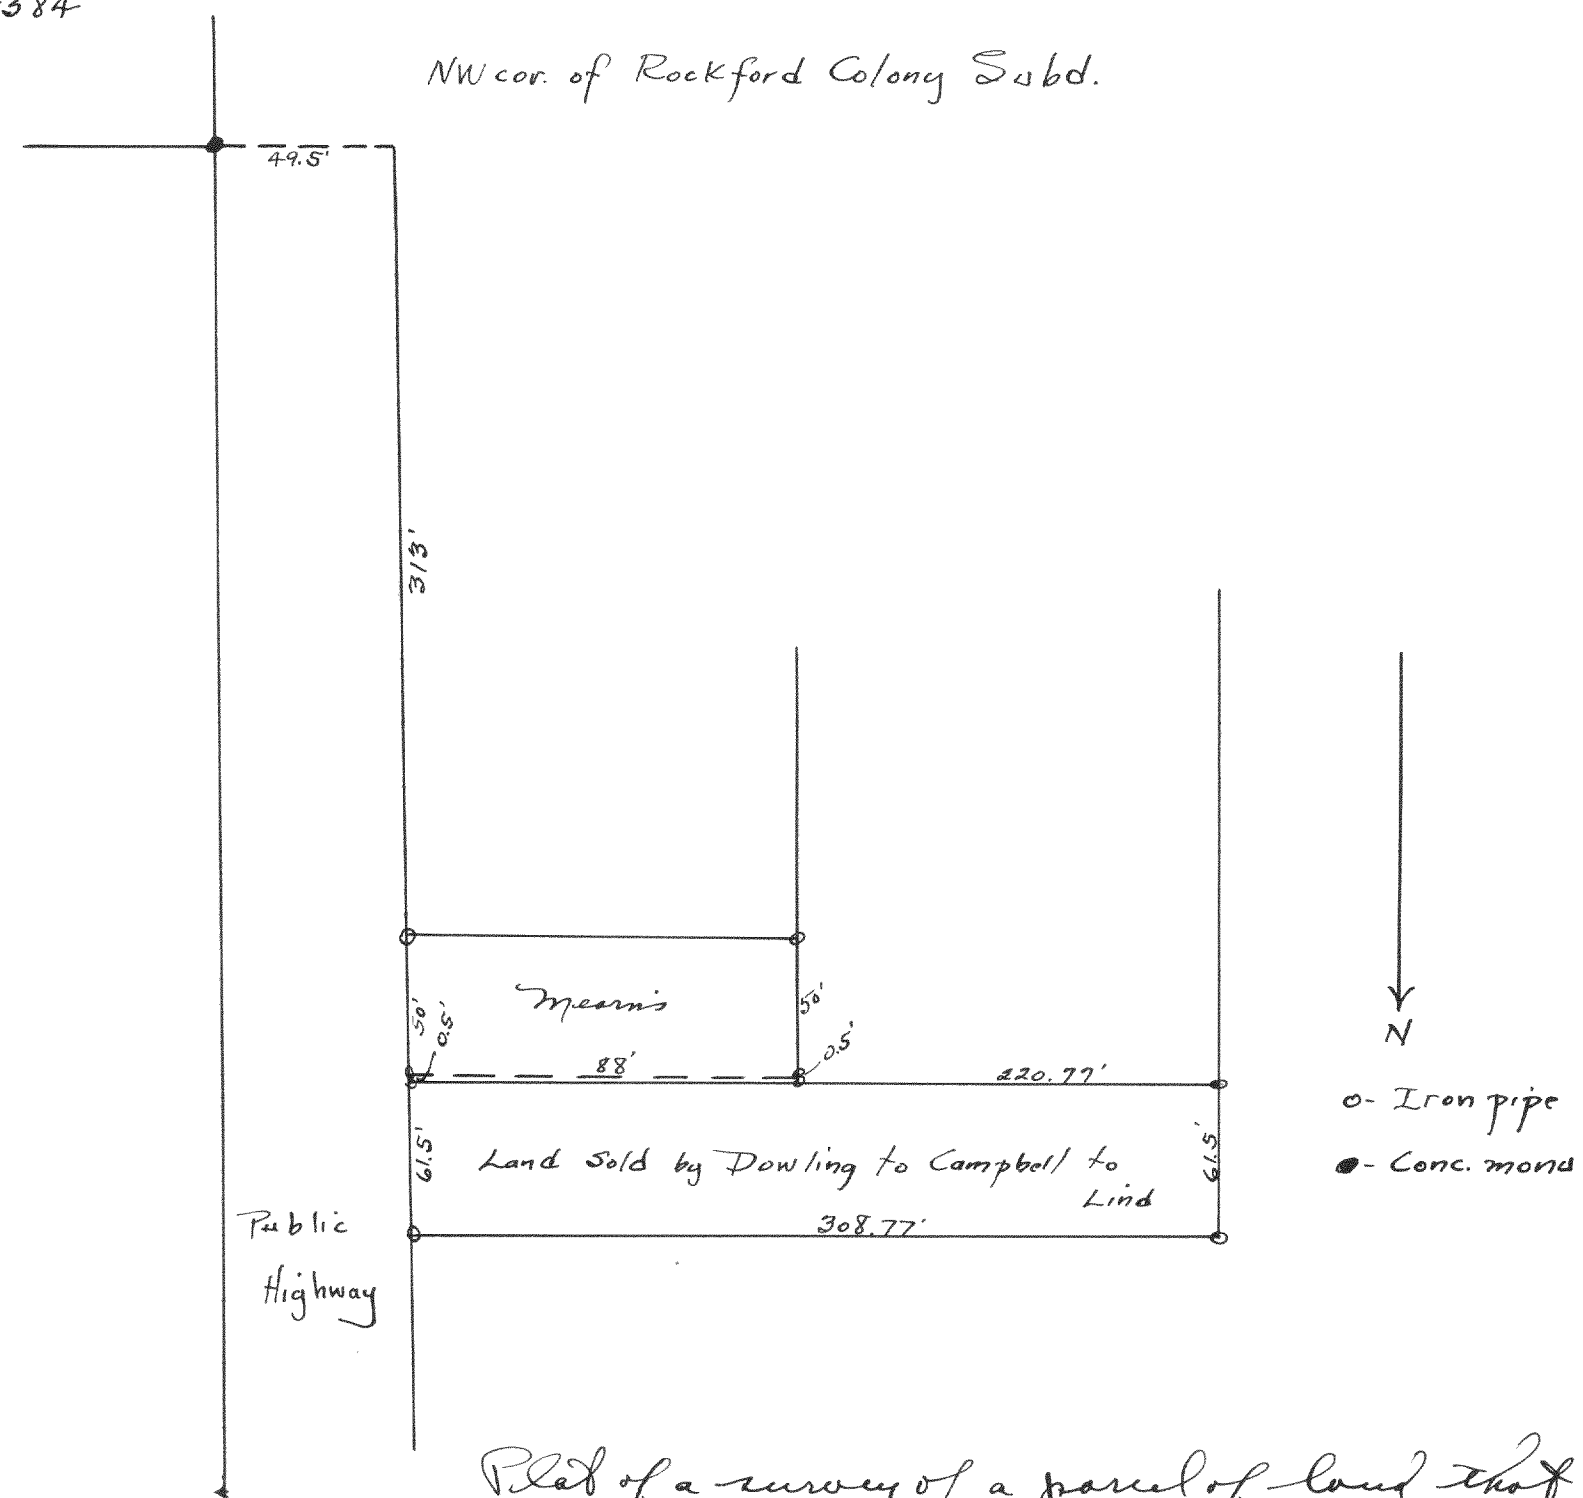


Plat of a survey of a parcel of land that
was sold by Bowling to Campbell and then
by Campbell to Lind.

March 15, 1945

Clayd L. Jensen
County Surveyor

#1585

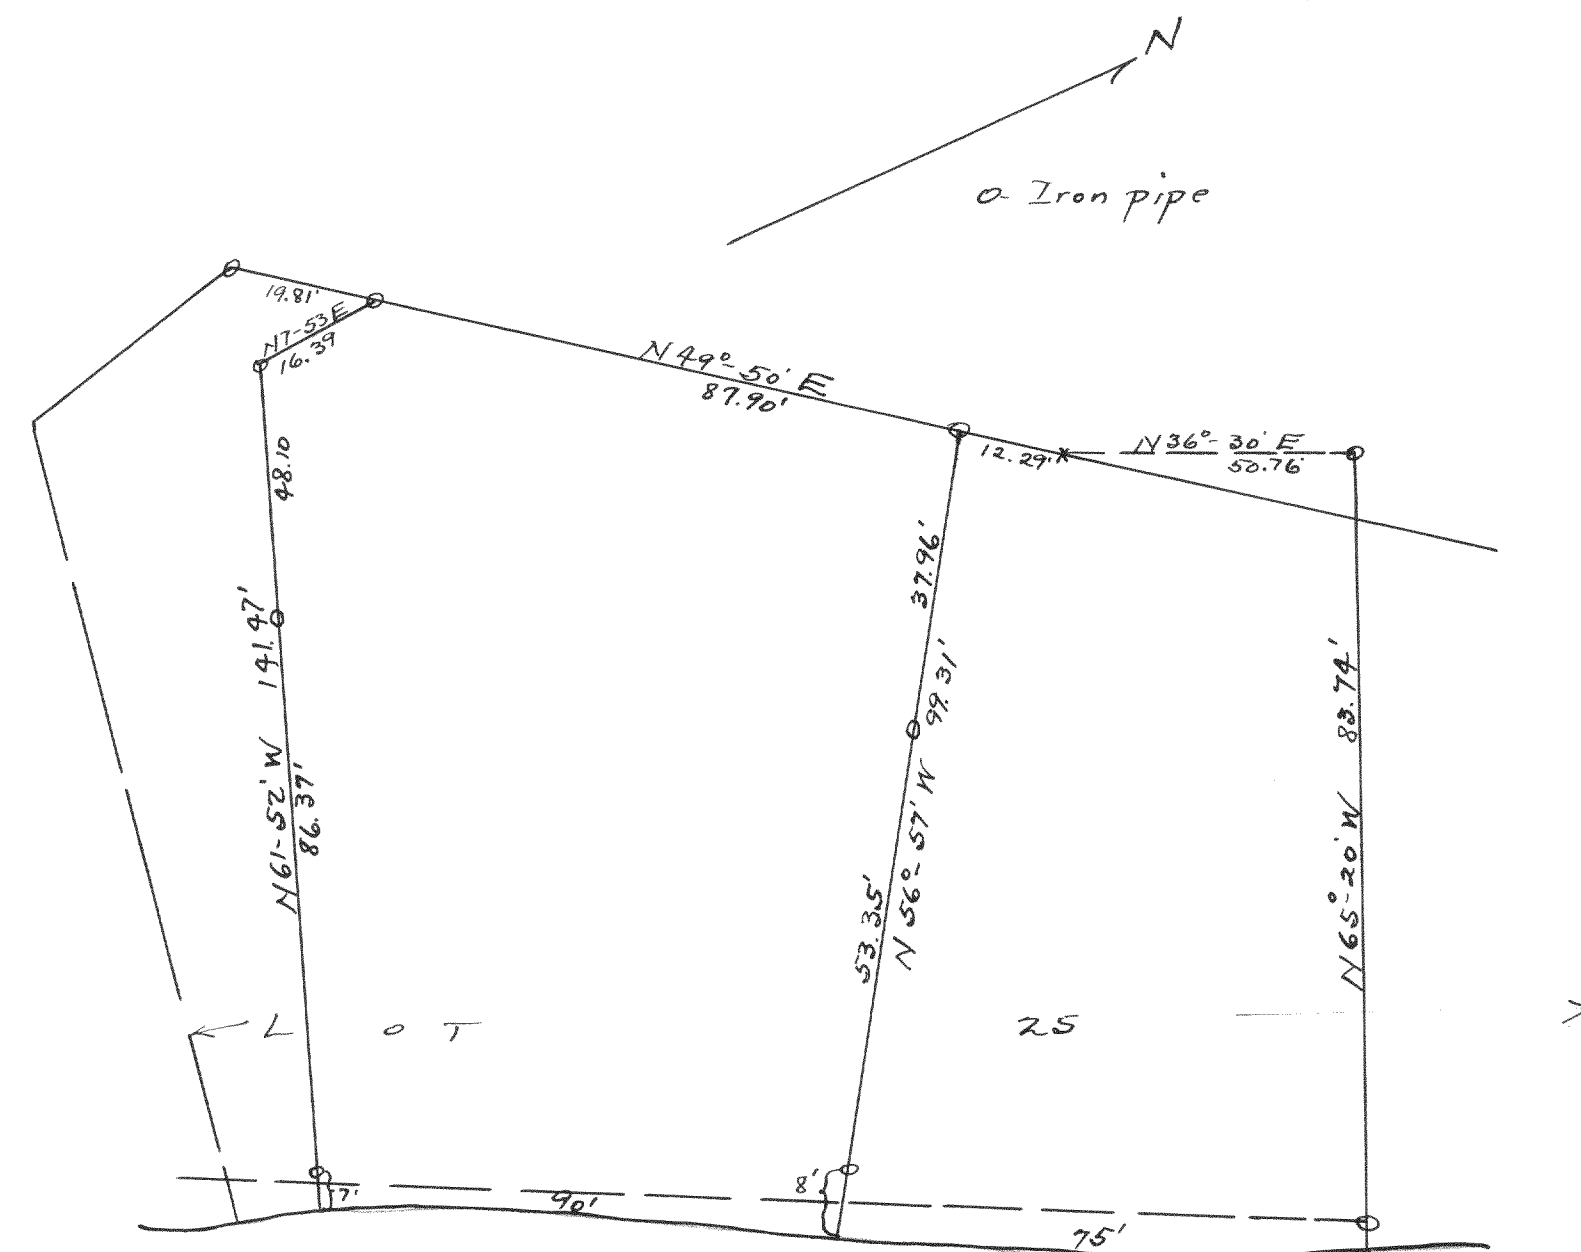

Plot of survey of part of lot 25 of
the subdivision of Green Island (Drakin Isld)
Section 26, T4N R16E.

May 1945

Olga S. Jensen
Cora J. Servey 07