


#1595

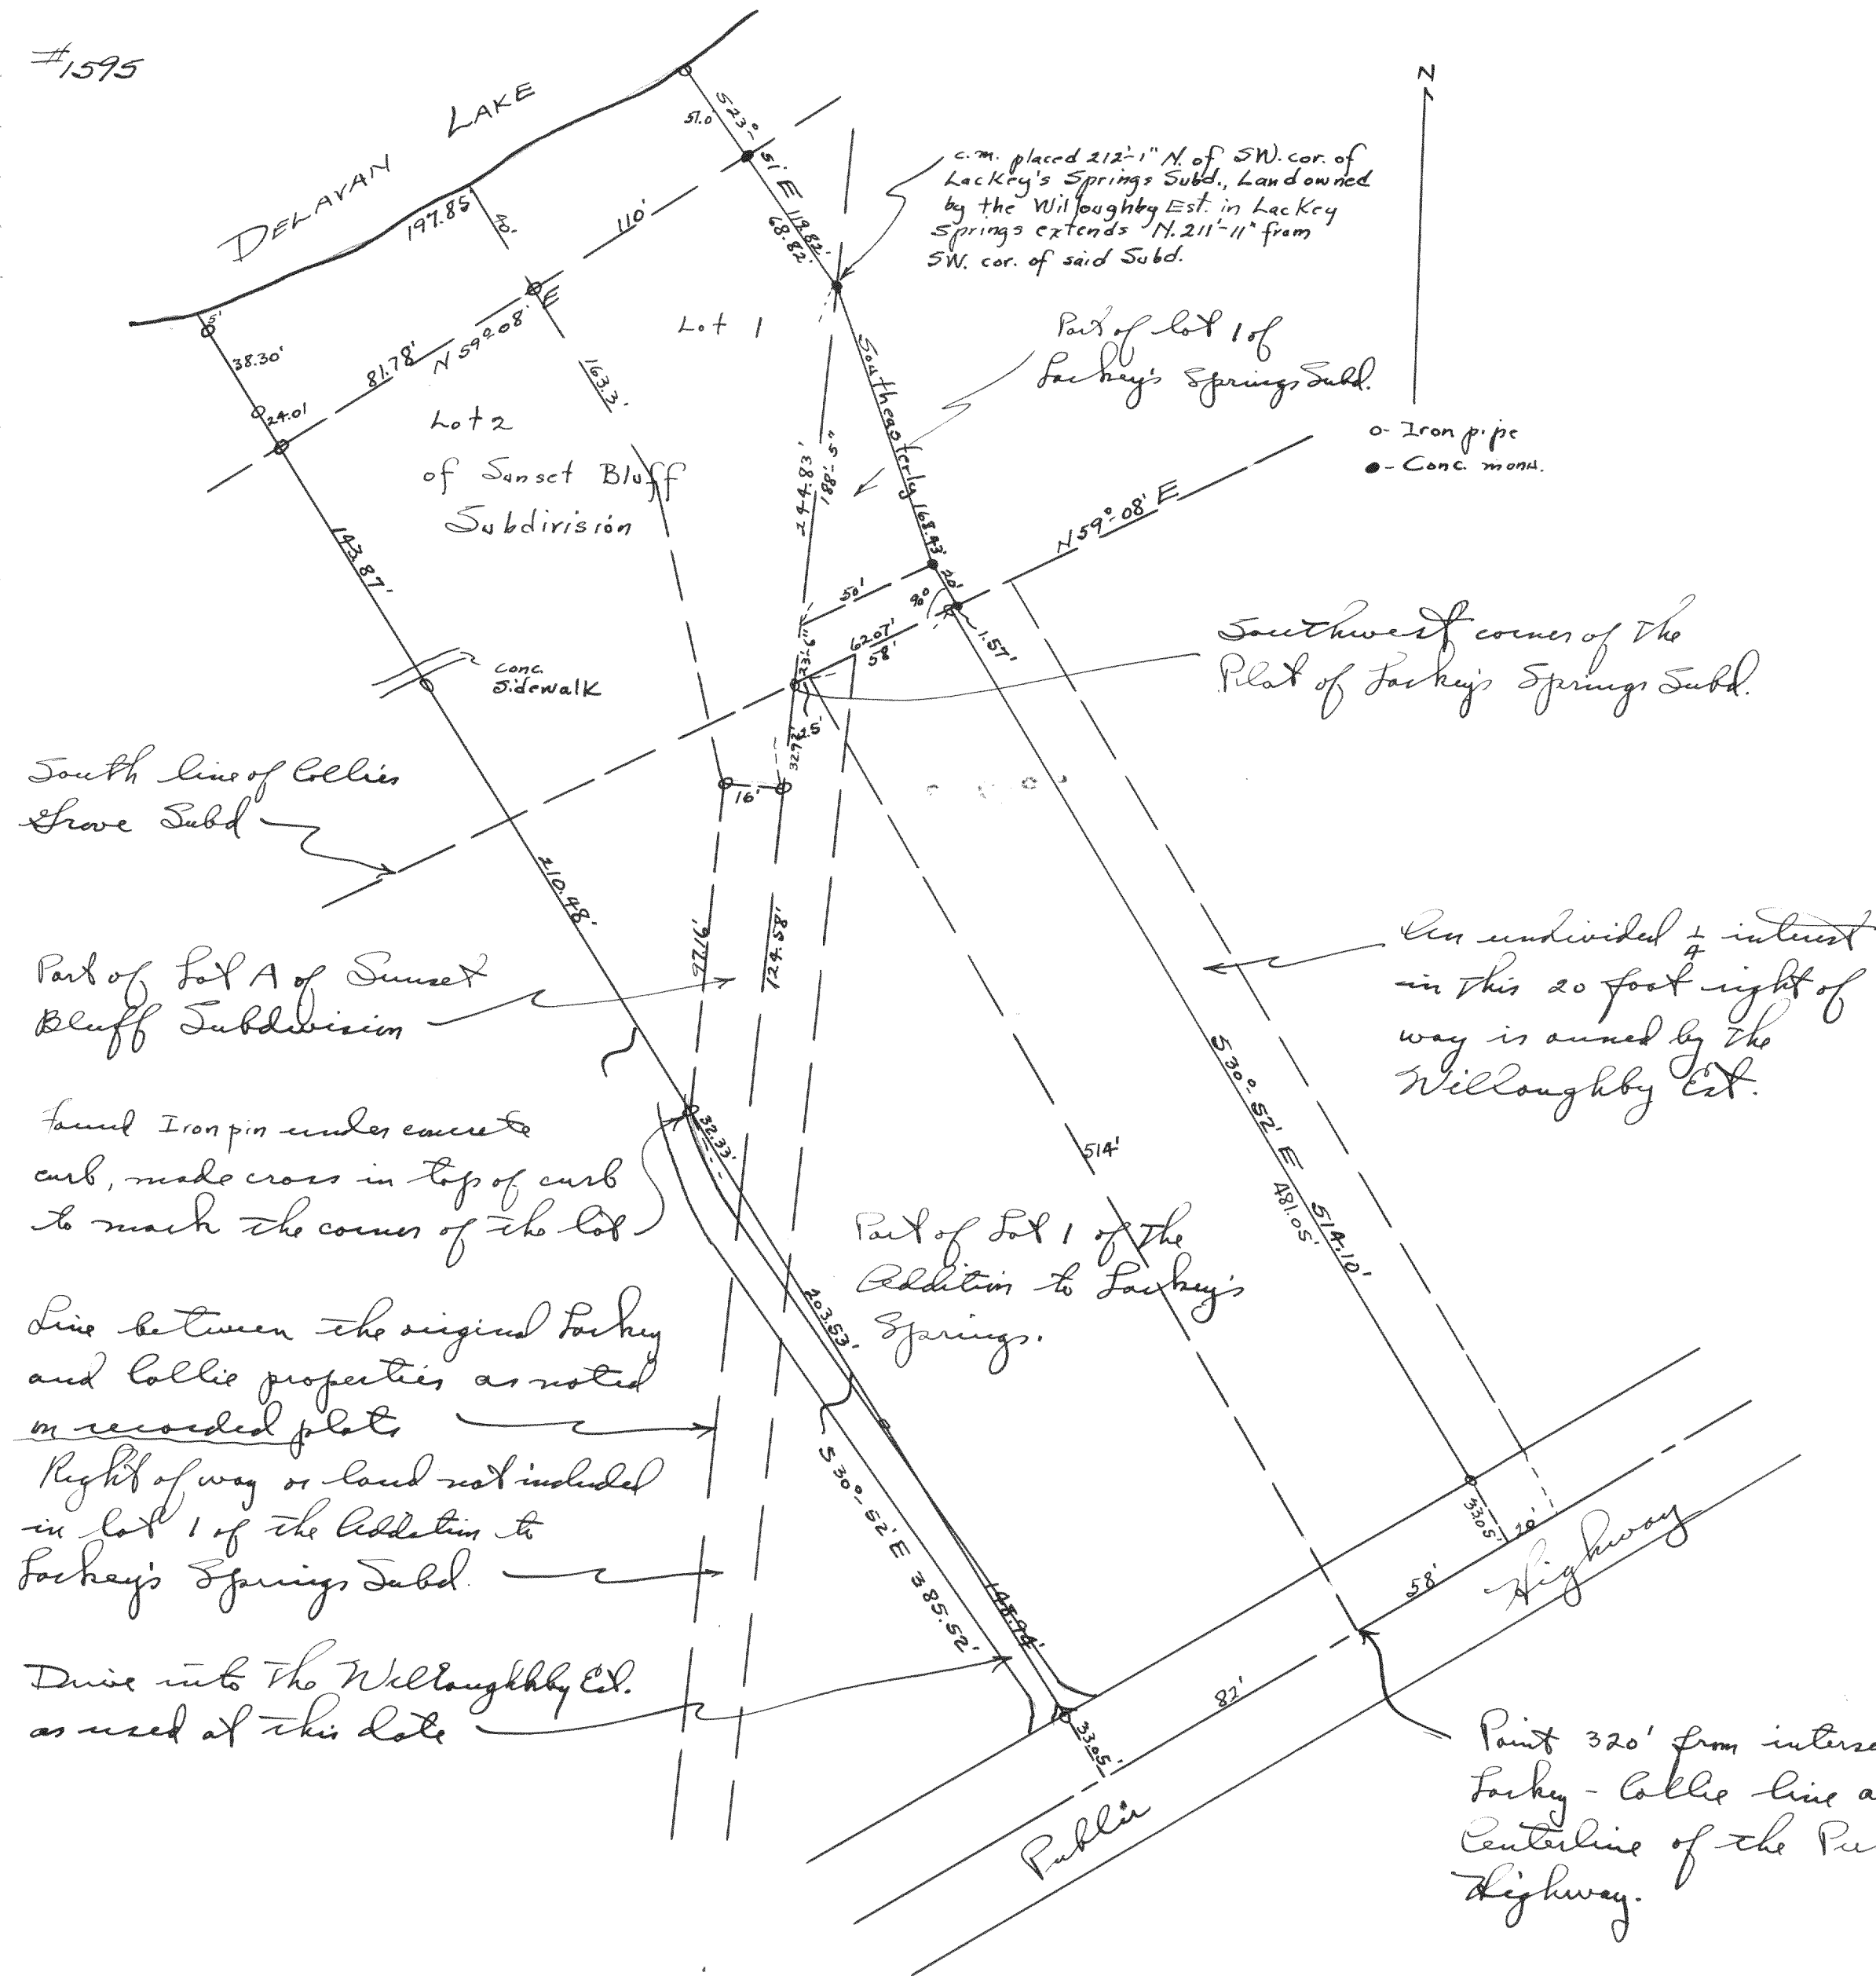

Plat of survey of the Willoughby Estate, located in the Northwest $\frac{1}{4}$ of fractional Section 33, T27N R16E of Walworth County Wisconsin.
8-3-45
Rloyd S. Jensen
County Surveyor