


#1600

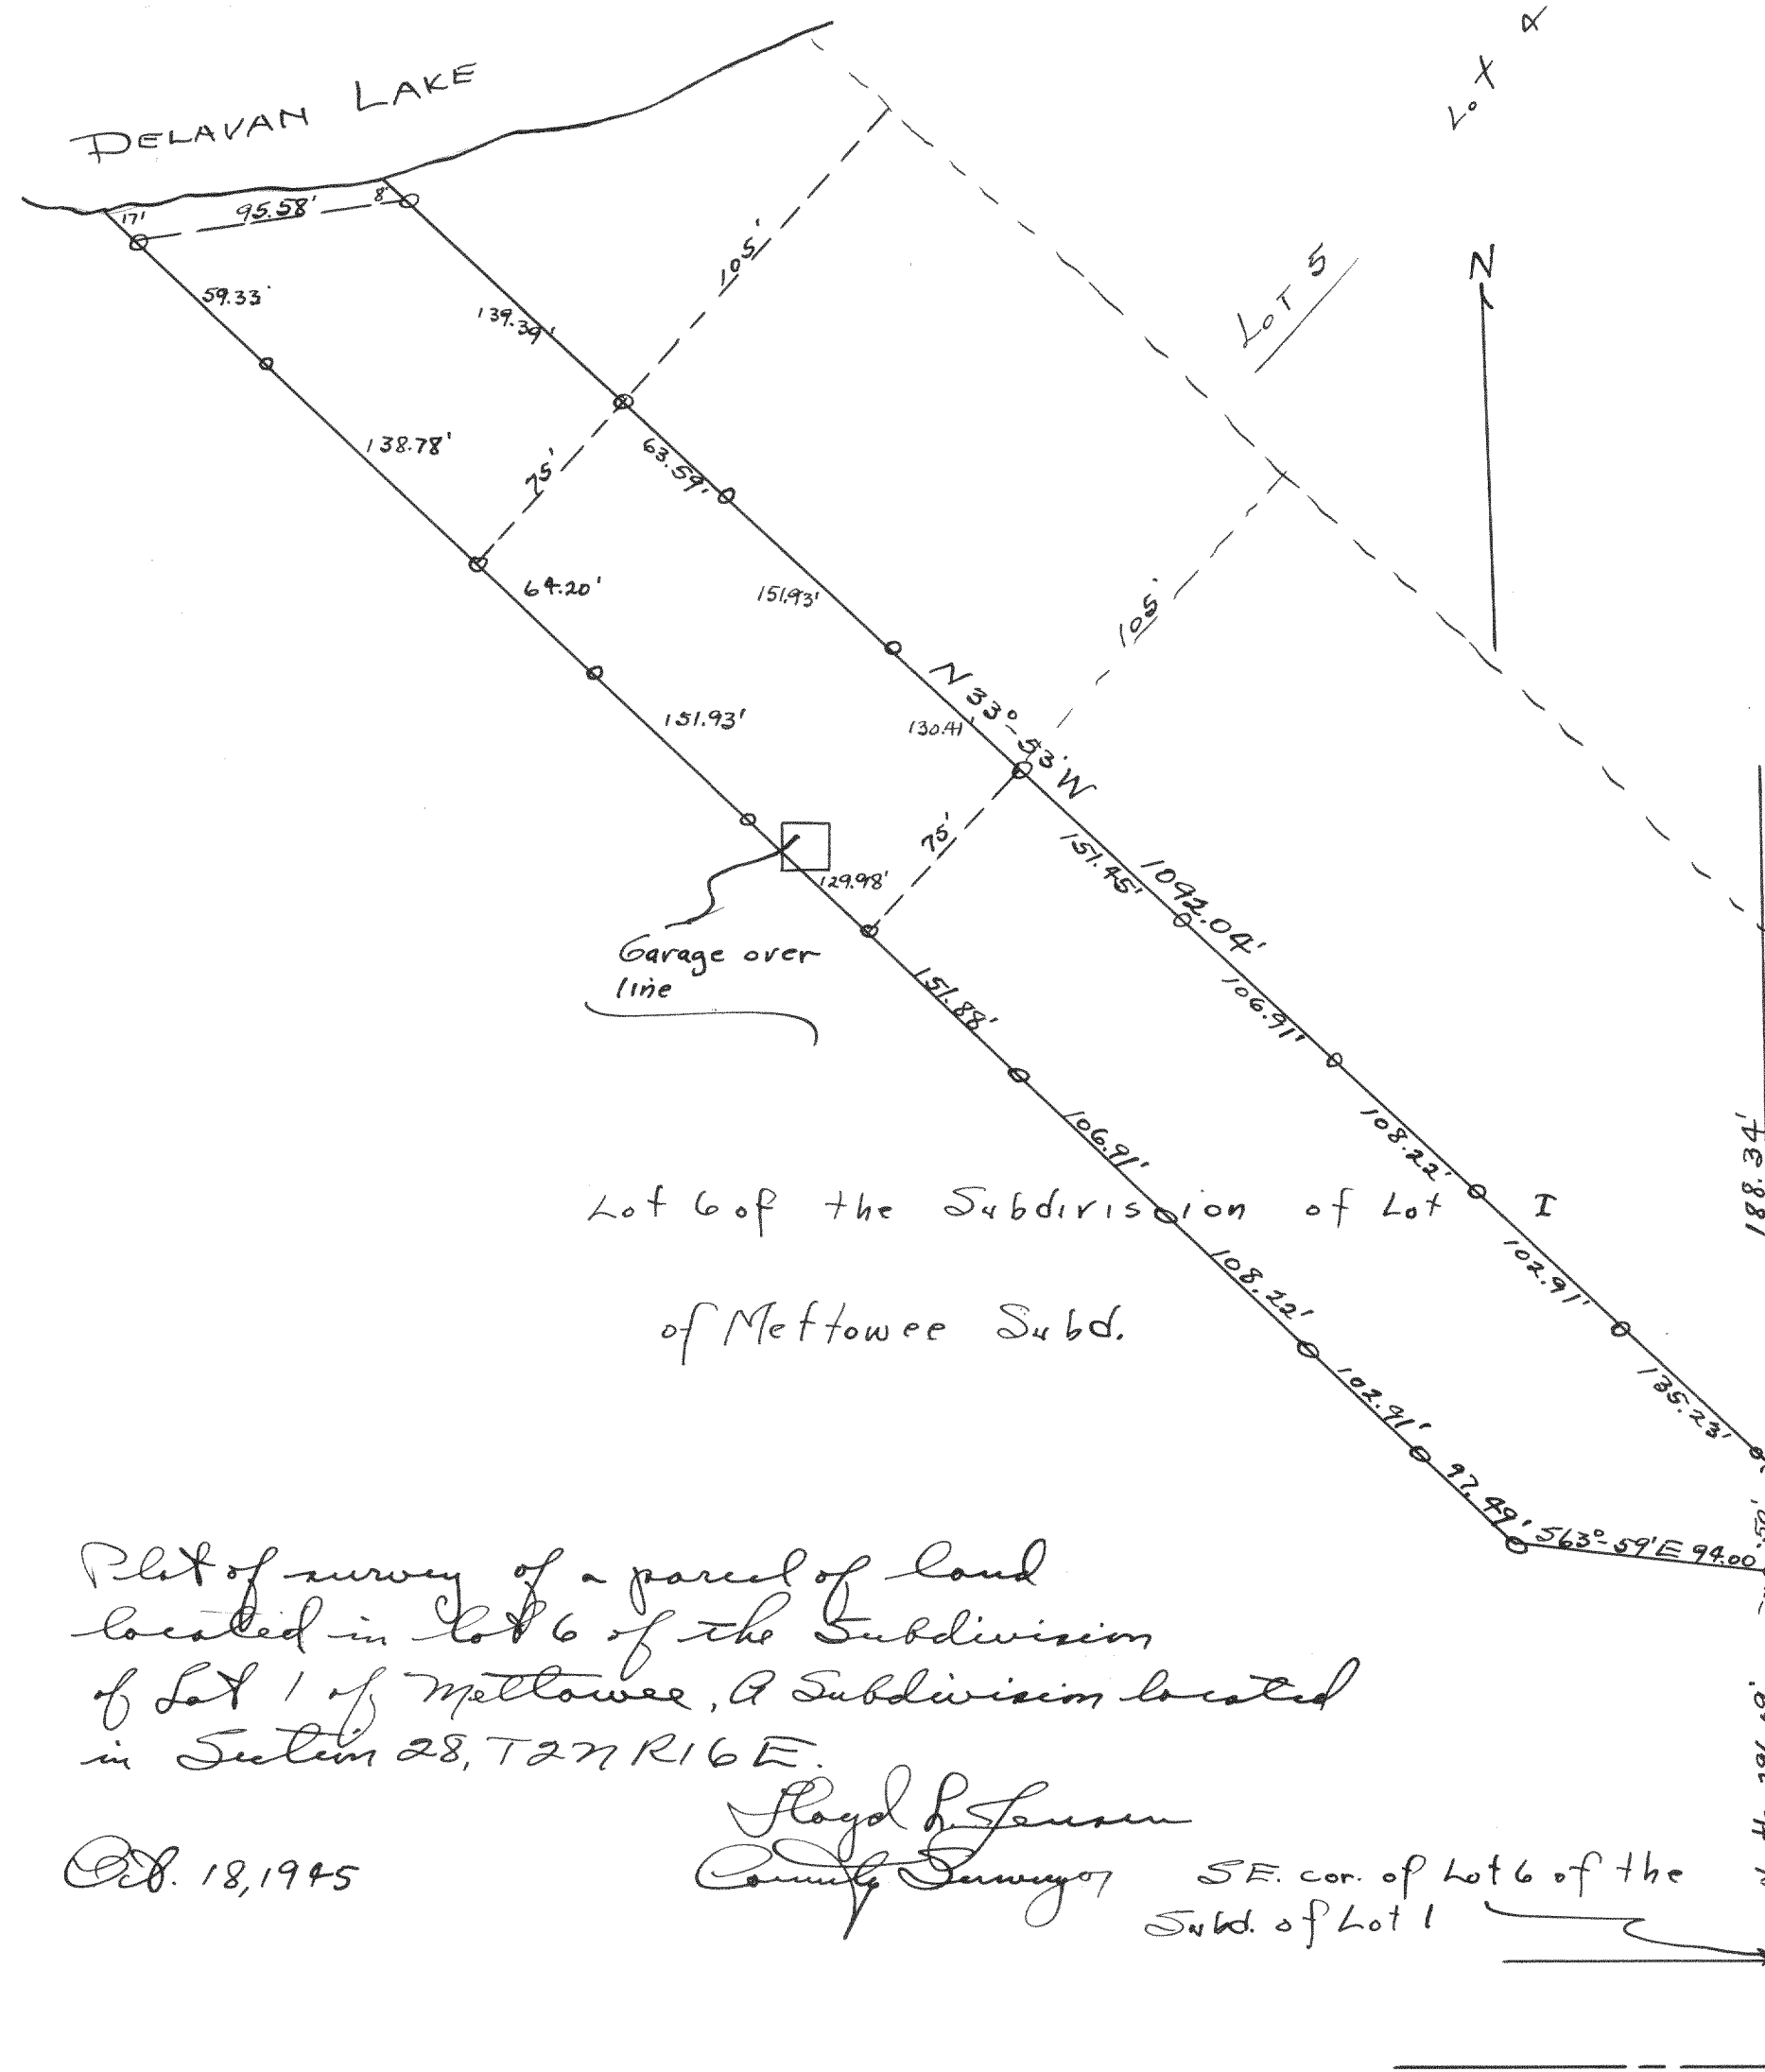

Plot of survey of a parcel of land located in Lot 6 of the Subdivision of Lot 1 of Mettowee, a Subdivision located in Section 28, T27 R16 E.

Oct. 18, 1945

Royal S. Jensen
County Surveyor

Cross cut in the top of gate post at lot corner.
Iron pipe is 2.00' NW'ly on Lot line
Cross was located by extending a line SE by parallel to and 105' distant from the SW'ly line of Lot 5.