


1609

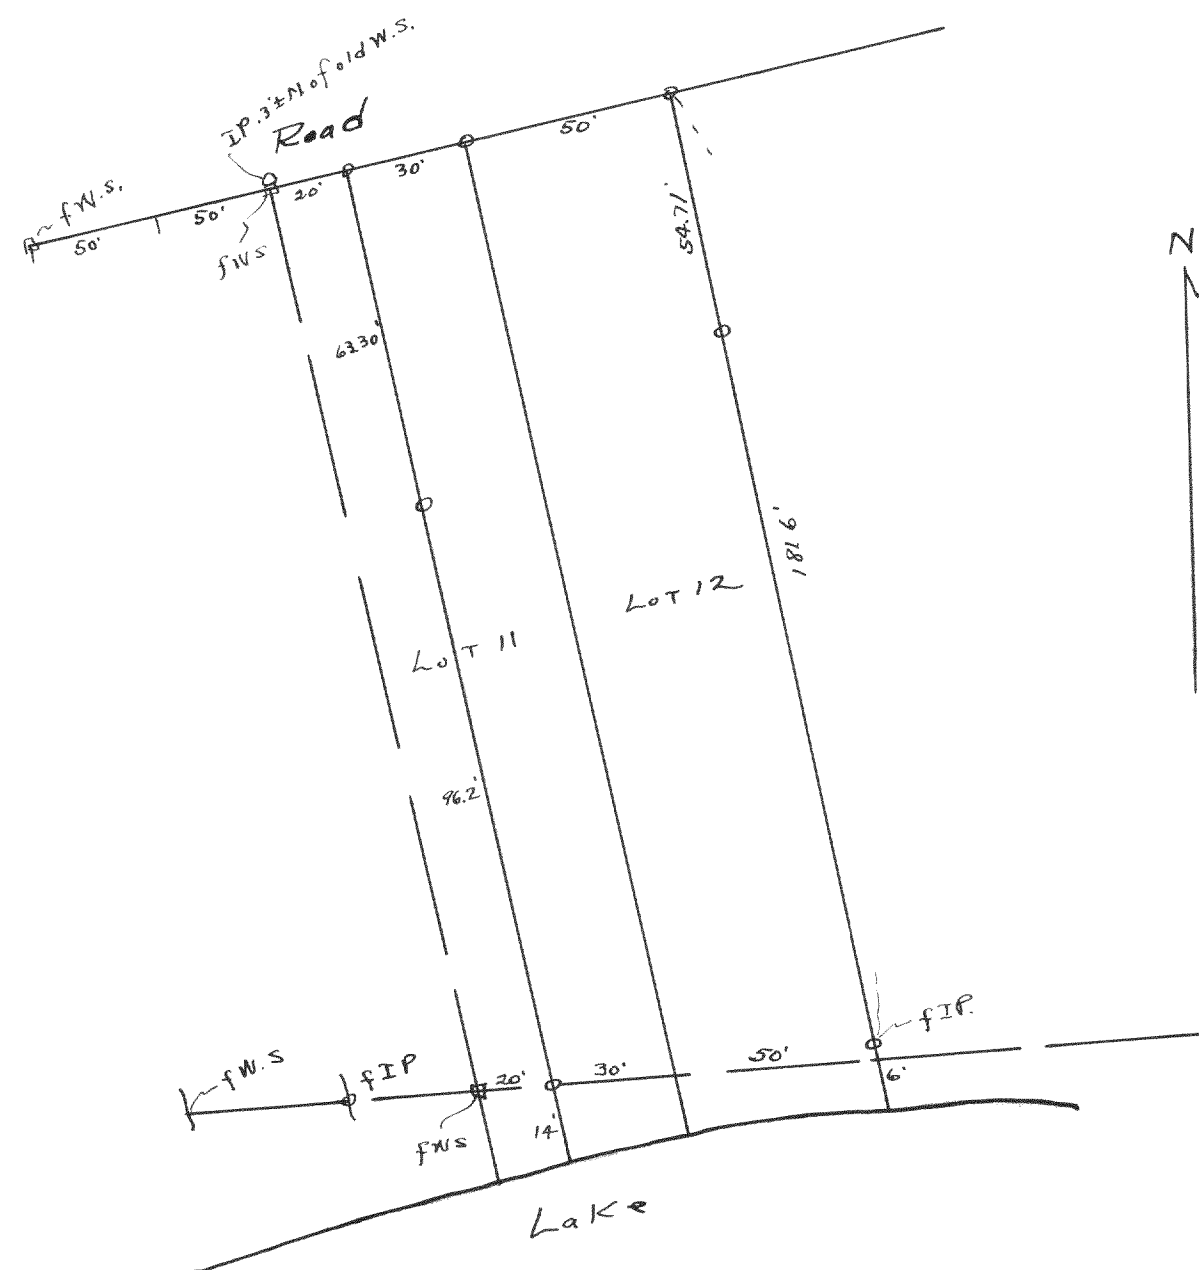


Plot of survey of Lot 12 and the
E. 30' of Lot 11 of the 1st. Add. to
Sawdendale Park.

June 1945

12.
Lloyd L. Jensen
County Surveyor

1610

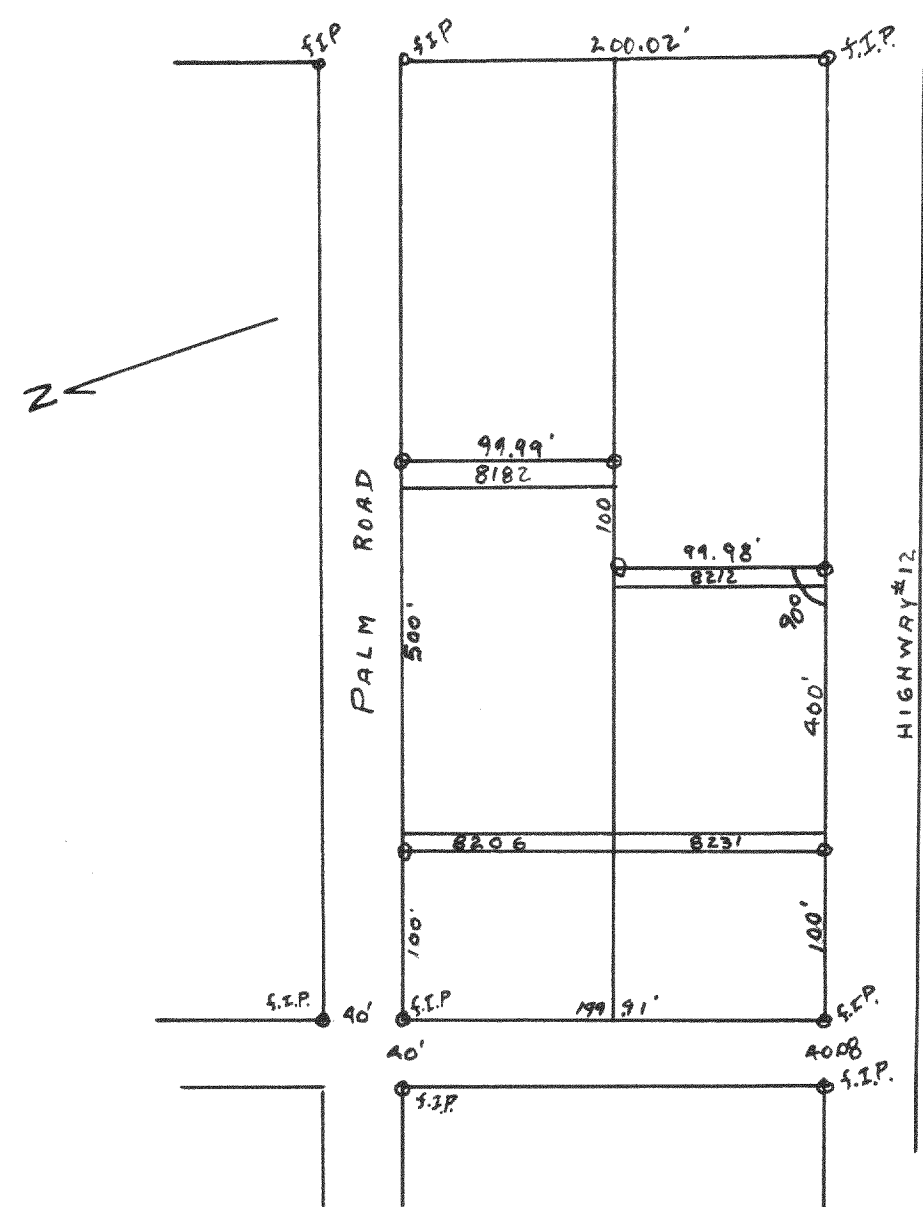

Plot of Survey of Lots 8182 to 8206 and
Lots 8212 to 8231 in section 5 of Bell Lake
Subdivisions Walworth County, Wisc.

Oct. 1946

Lloyd Jensen
County Surveyor
G.T.D.