



SURVEY No. 1224

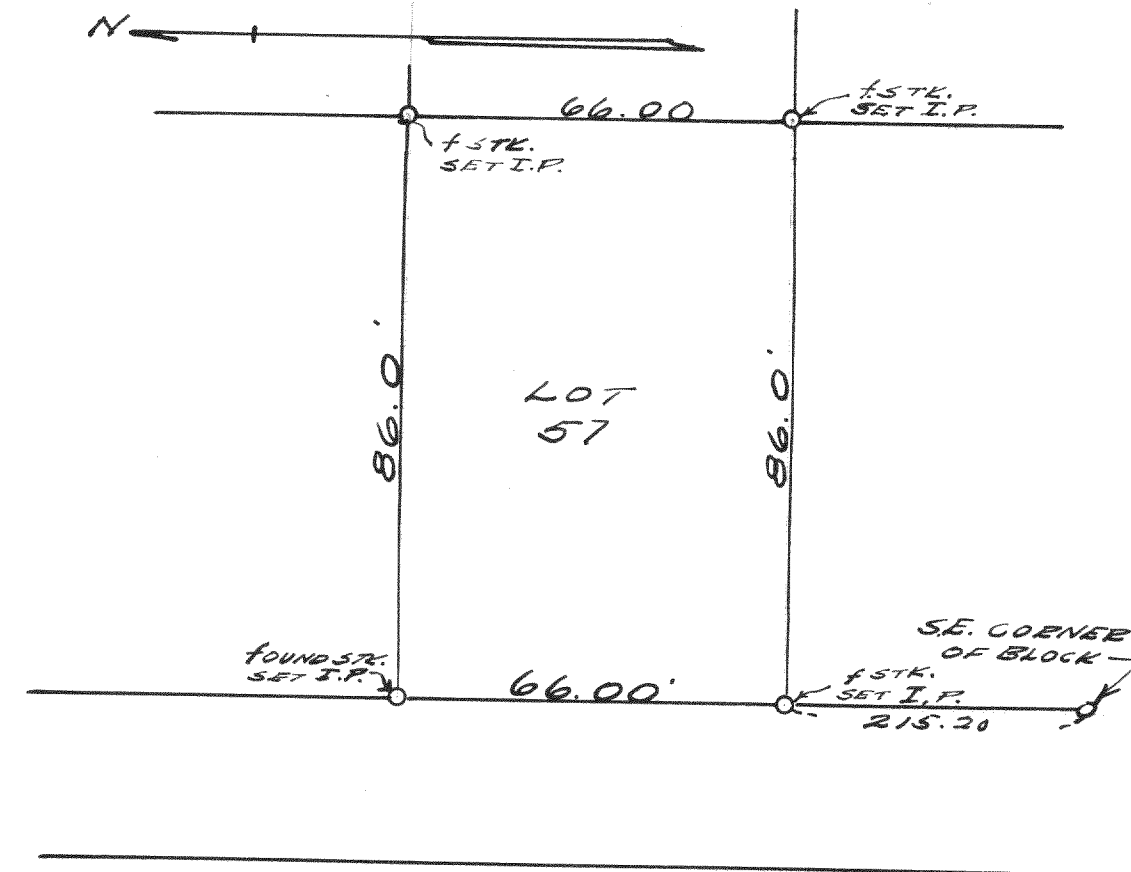

PLAT OF SURVEY OF ROBINSON'S SECOND  
SUBDIVISION, (LOT 57). TIN RITE, WALWORTH  
COUNTY, WISCONSIN  
MAY, 1941

Lloyd L Jensen  
S.E.J.

SURVEY No. 1225

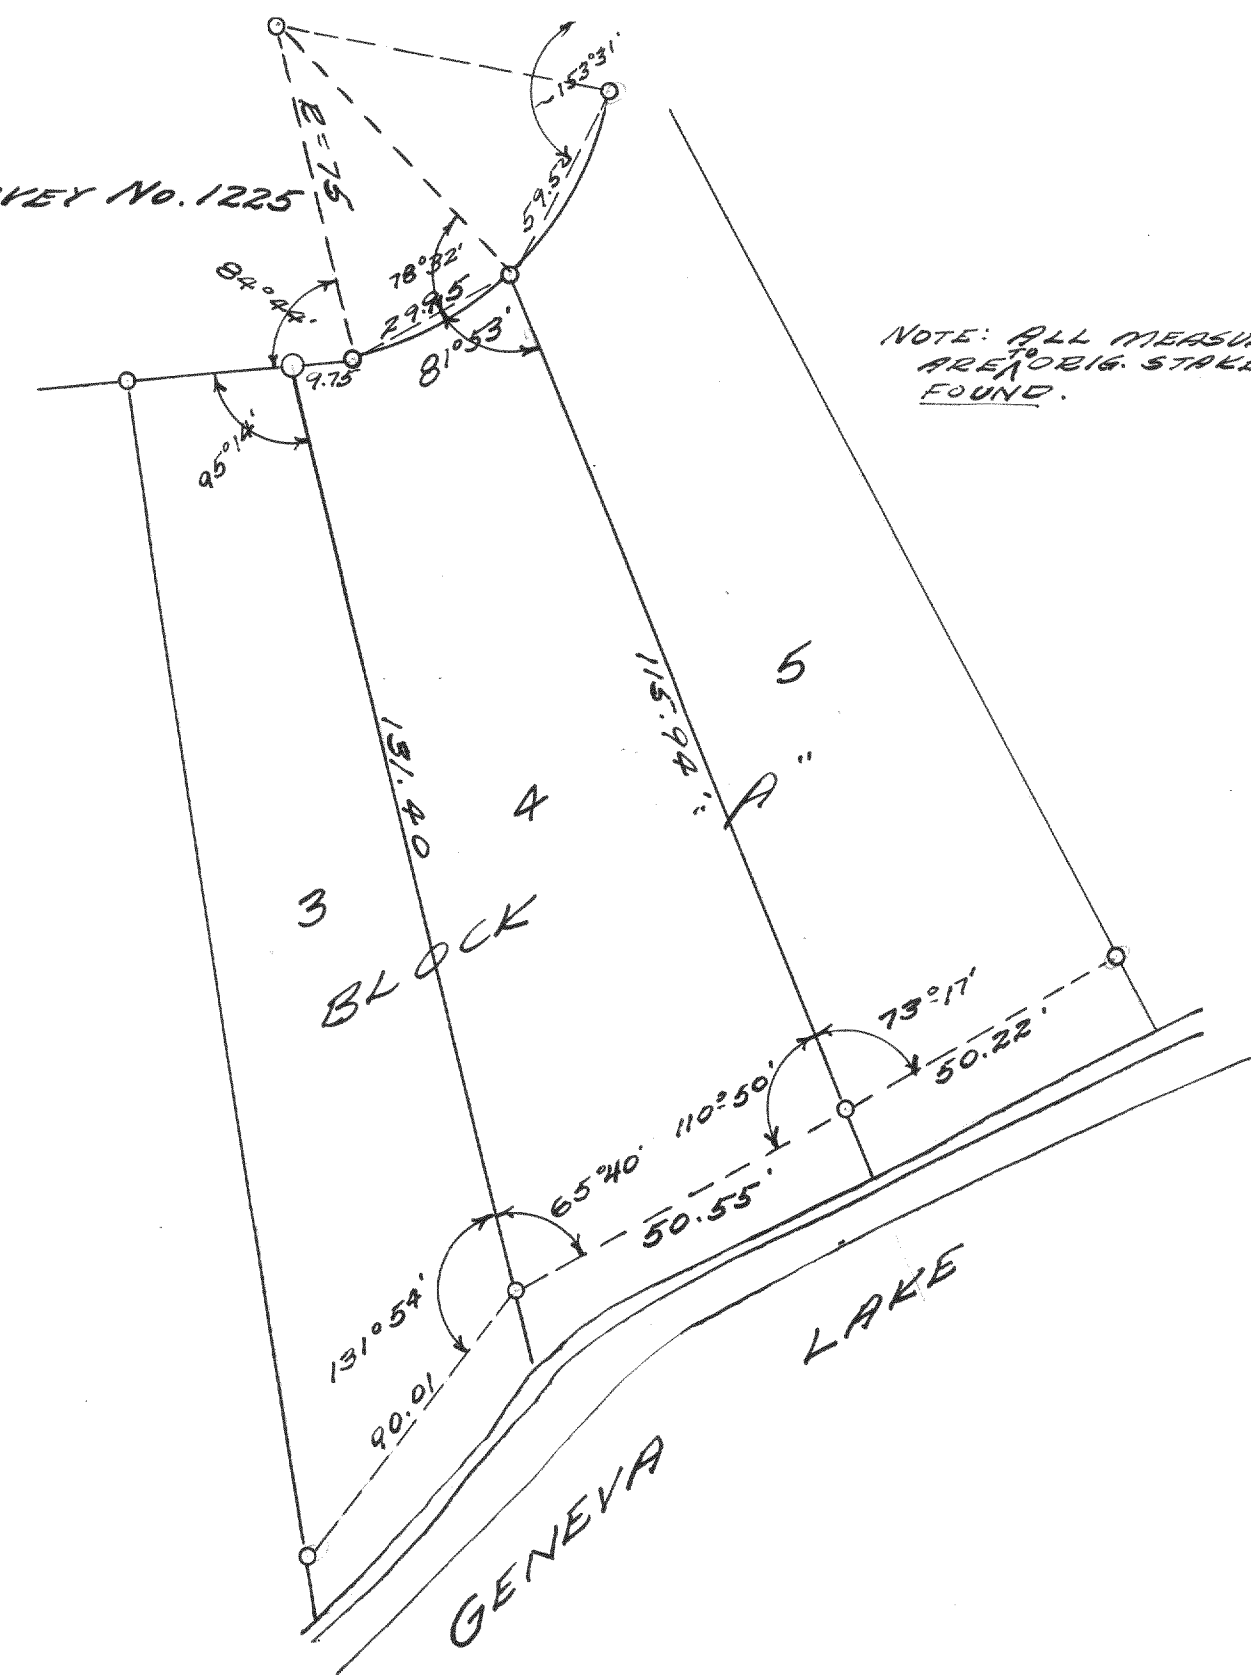

SURVEY OF LOT 4 BLOCK "A" OF  
CISCO BEACH SUBD., SECTION 5,  
TIN RITE, WALWORTH CO., WISC.  
JUNE 1941

Lloyd L Jensen  
S.E.J.