



#1617

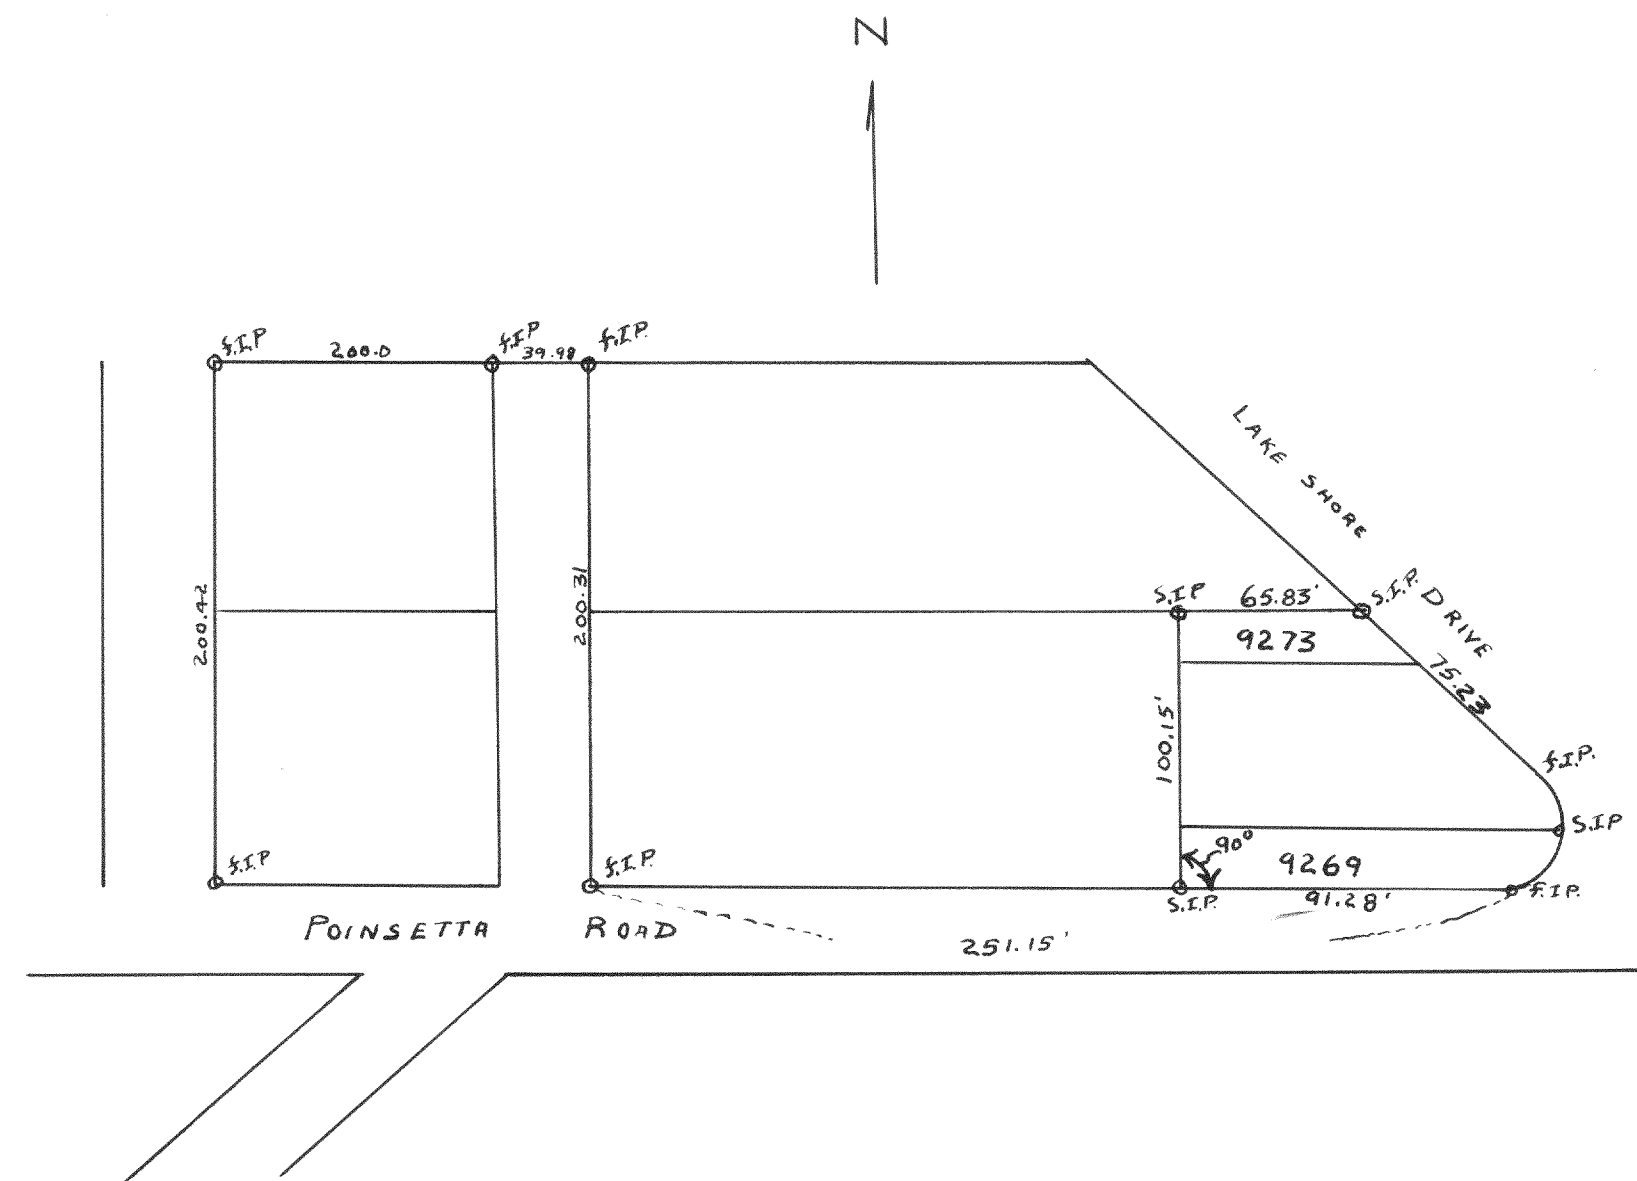

Plat of Survey of Lots 9269 to 9273 in Section 5
of Bell Lake Subdivisions, Walworth County, Wisconsin
Sept 1946
Lloyd L. Jensen
County Surveyor

#1618

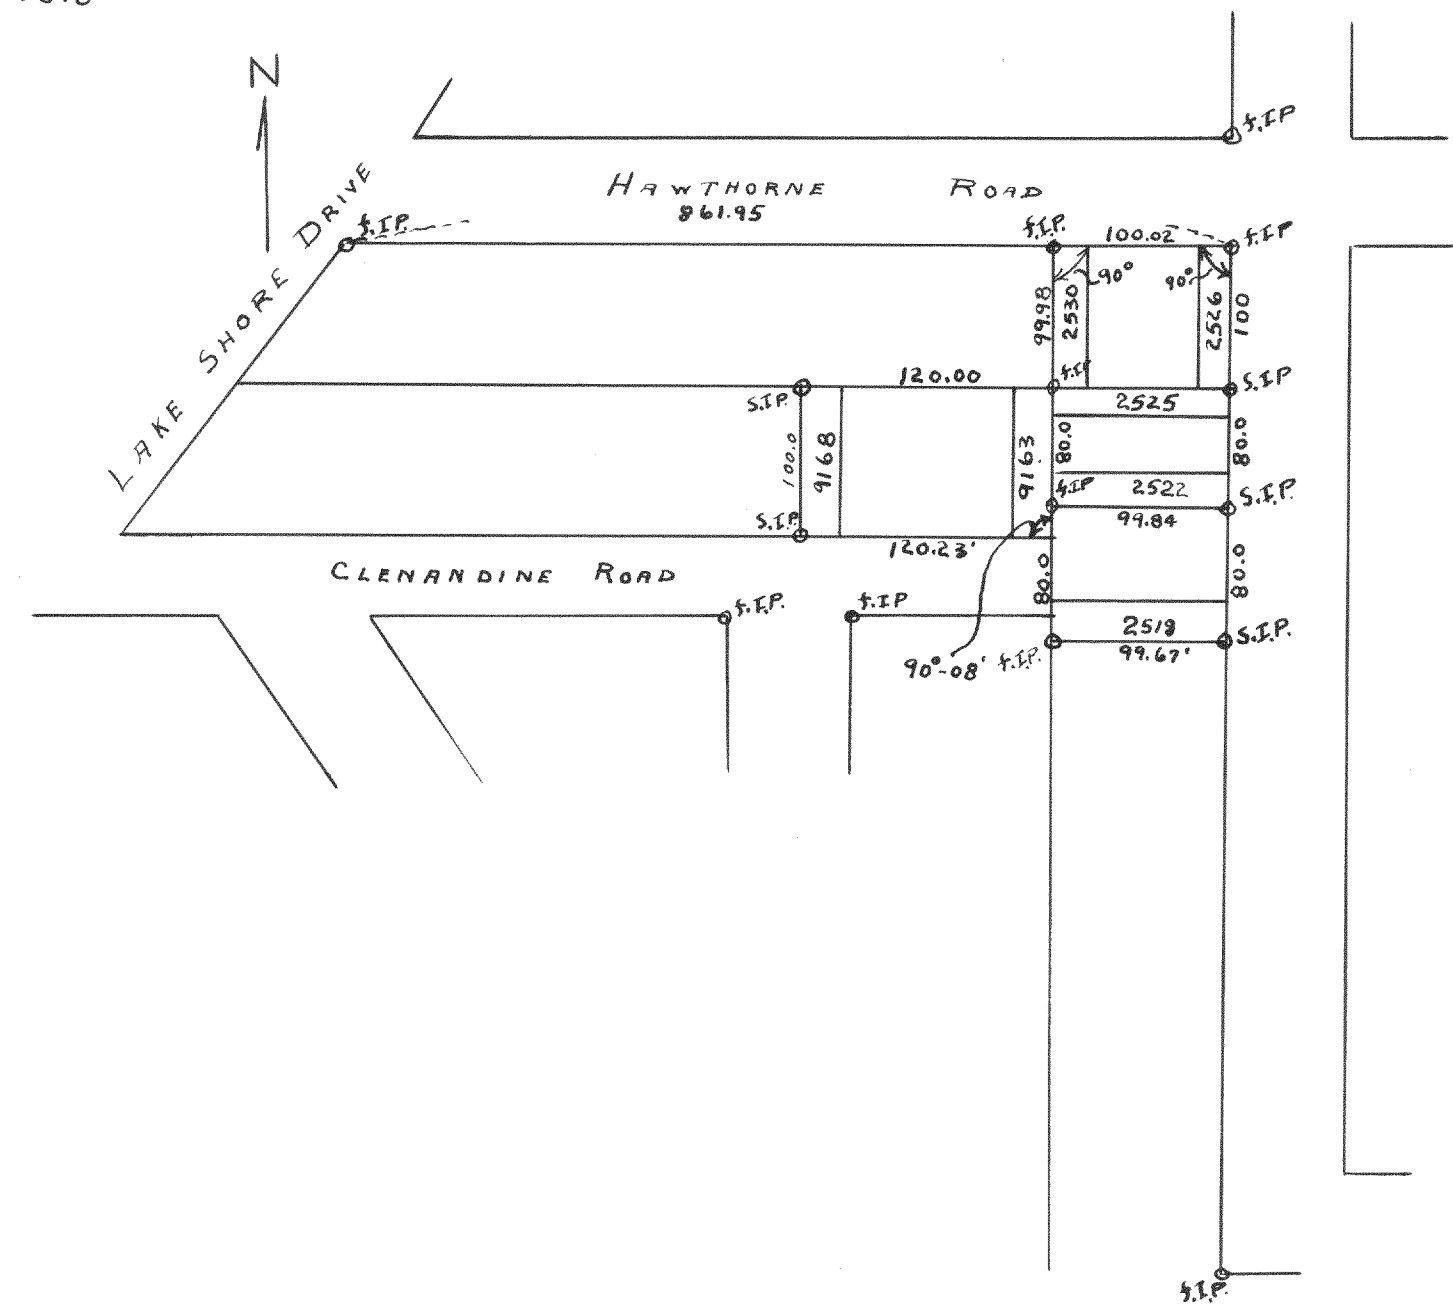

Plat of Survey of Lots 2518 to 2530 in Section 2
and Lots 9163 to 9168 in Section 5 of Bell Lake
Subdivisions, Walworth County, Wisconsin
Sept. 1946
Lloyd L. Jensen
County Surveyor