


1621

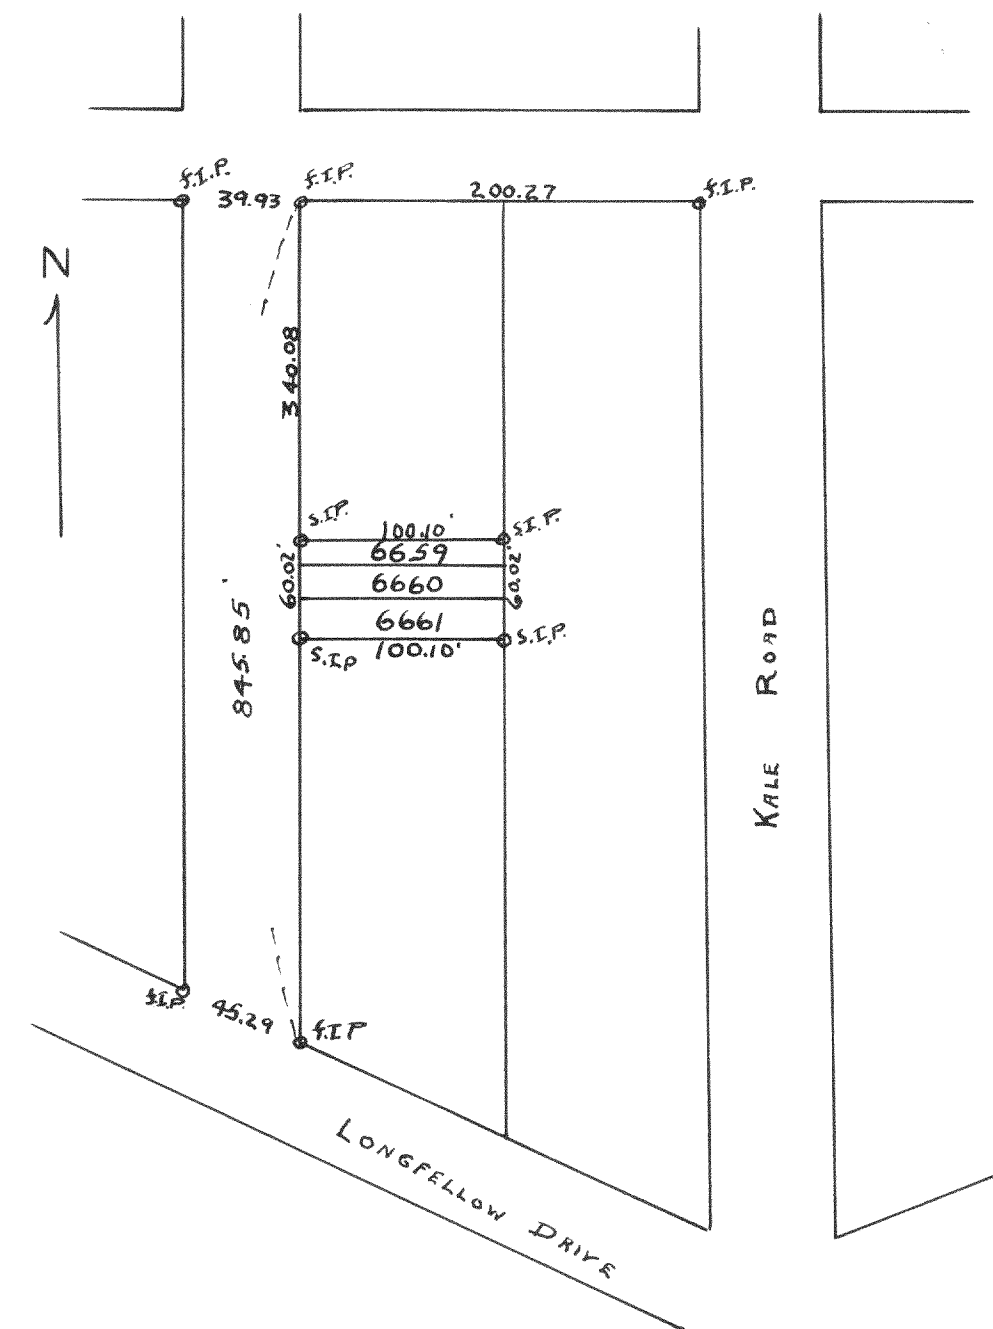


Plat of Survey of Lots 6659 to 6661 in
Lake Como Beach Subdivision Walworth
County, Wisconsin

Sept. 1946

Lloyd L. Jensen
County Surveyor
G.T.D.

1622

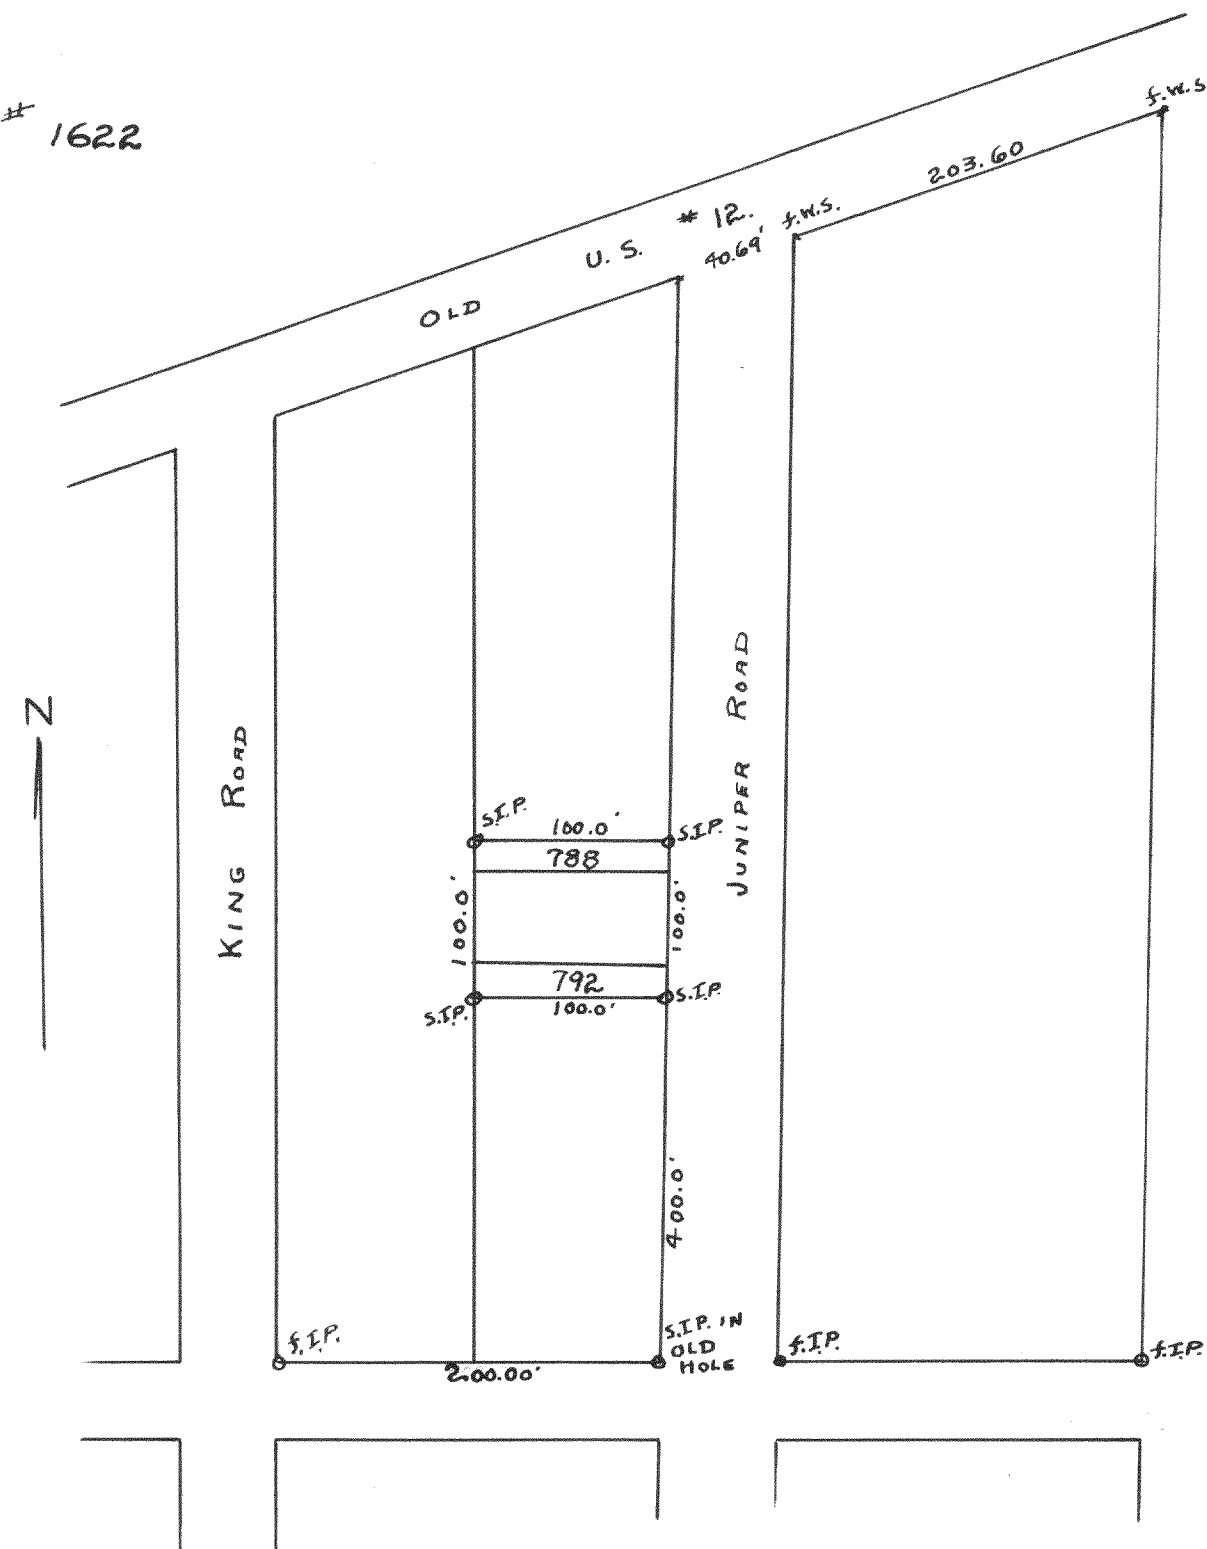

Plat of Survey of Lots 788 to 792 of Lake
Como Beach Subdivisions in Walworth County, Wisconsin

Sept. 1946

Lloyd L. Jensen
County Surveyor
G.T.D.