



1625

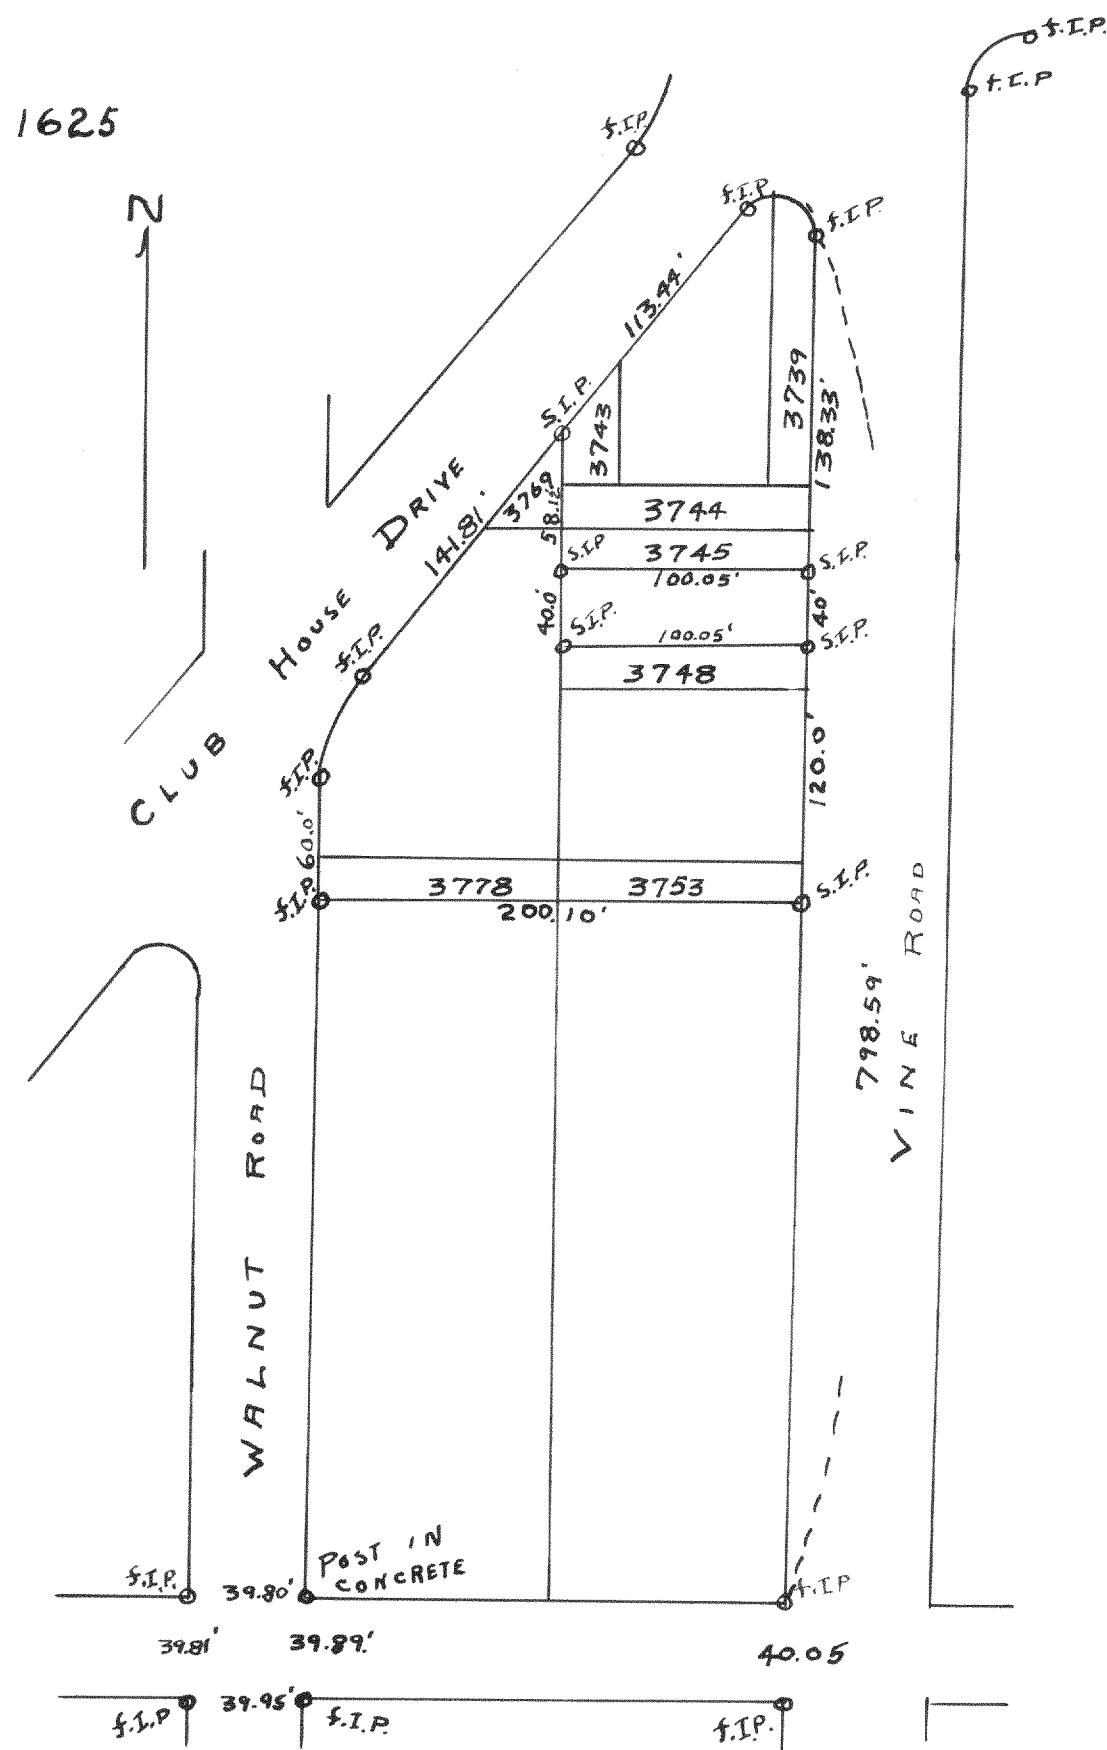

Plot of Survey of Lots 3739 to 3745 -
 Lots 3748 to 3753 and Lots 3769 to 3778
 in Lake Como Beach Subdivision, Walworth
 County, Wisconsin

Oct. 1946 Lloyd L. Jensen
 County Surveyor
 G.T.D.

1626

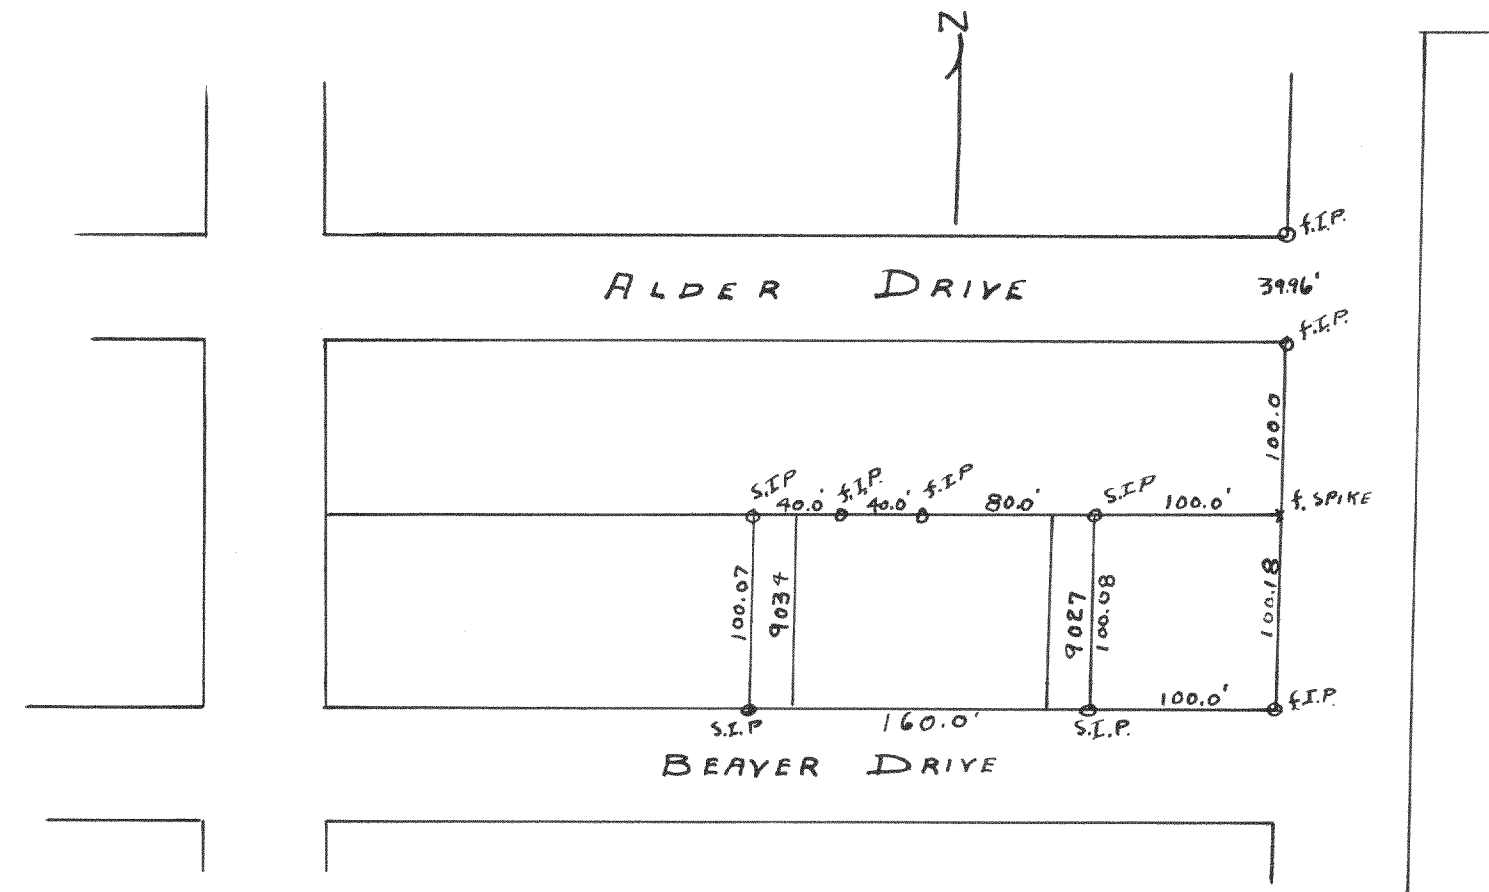

Plot of Survey of Lots 9027 to 9034 in
 Lake Como Beach Subdivision, Walworth County, Wisconsin

Oct. 1946

Lloyd L. Jensen
 County Surveyor
 G.T.D.