



1653

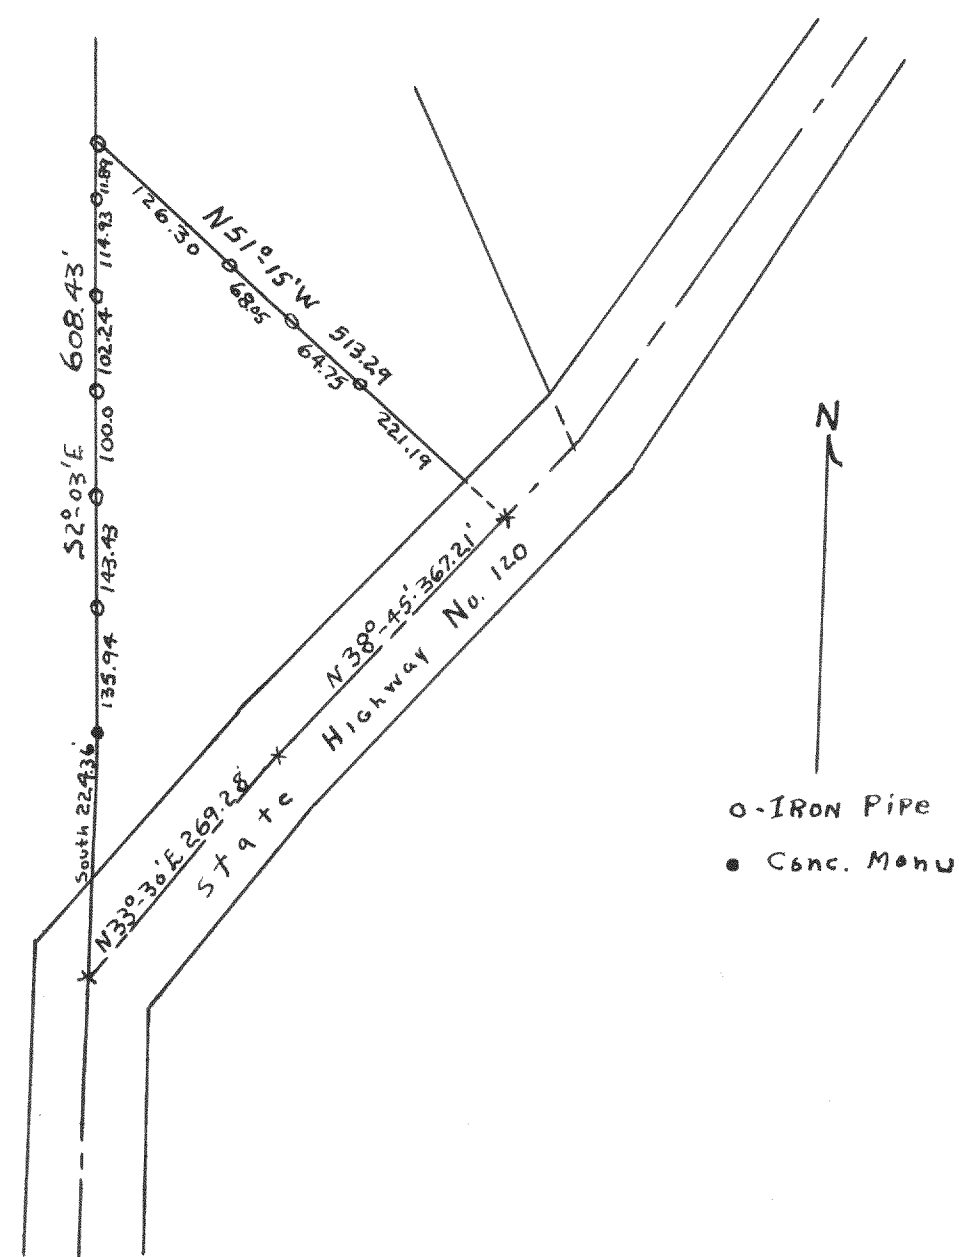

Plot of survey of lands located in the
Northwest fractional quarter and the SW 1/4 of section 12
T1N, R17E of Walworth County Wisconsin
Feb. 10, 1947

Lloyd L. Jensen
County Surveyor
G.T.D.

1654

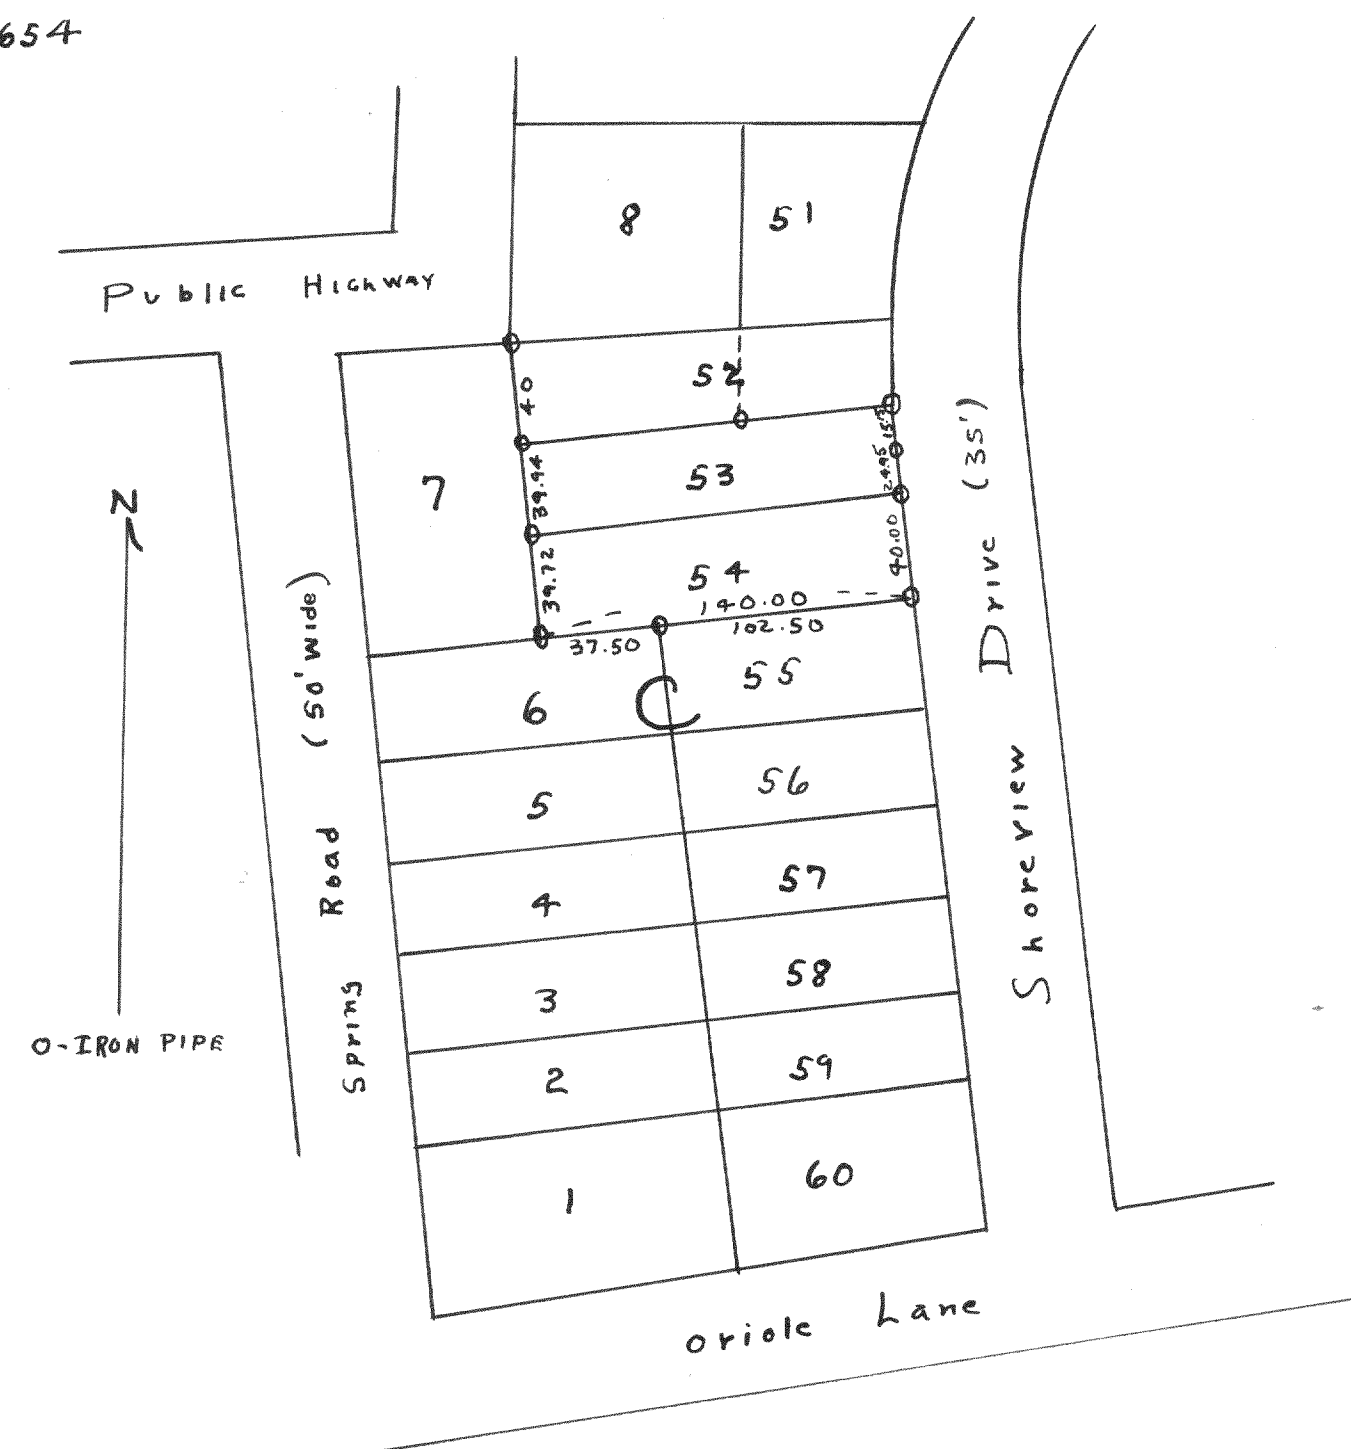

Plot of survey of lots 53 and 54 of
Block C of Cisco Beach Subdivision, T1N, R17E
of Walworth County Wisconsin
Sept 1946

Lloyd L. Jensen
County Surveyor
G.T.D.