



# 1671

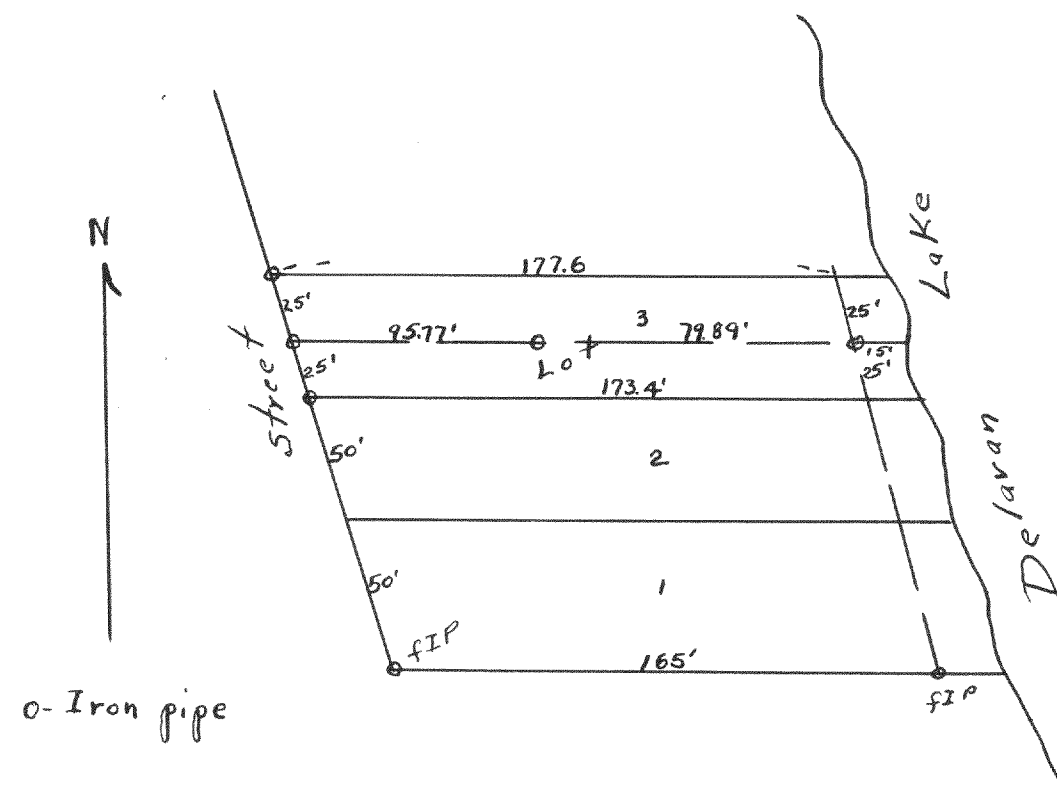

Plat of a survey to divide Lot 3 of  
Annex to Dulit Lake Subdivision into  
2 equal lots. Town of Delavan, Walworth County Wisconsin  
Lloyd L. Jensen  
County Surveyor  
Aug. 20, 1946  
G.T.D.

# 1672

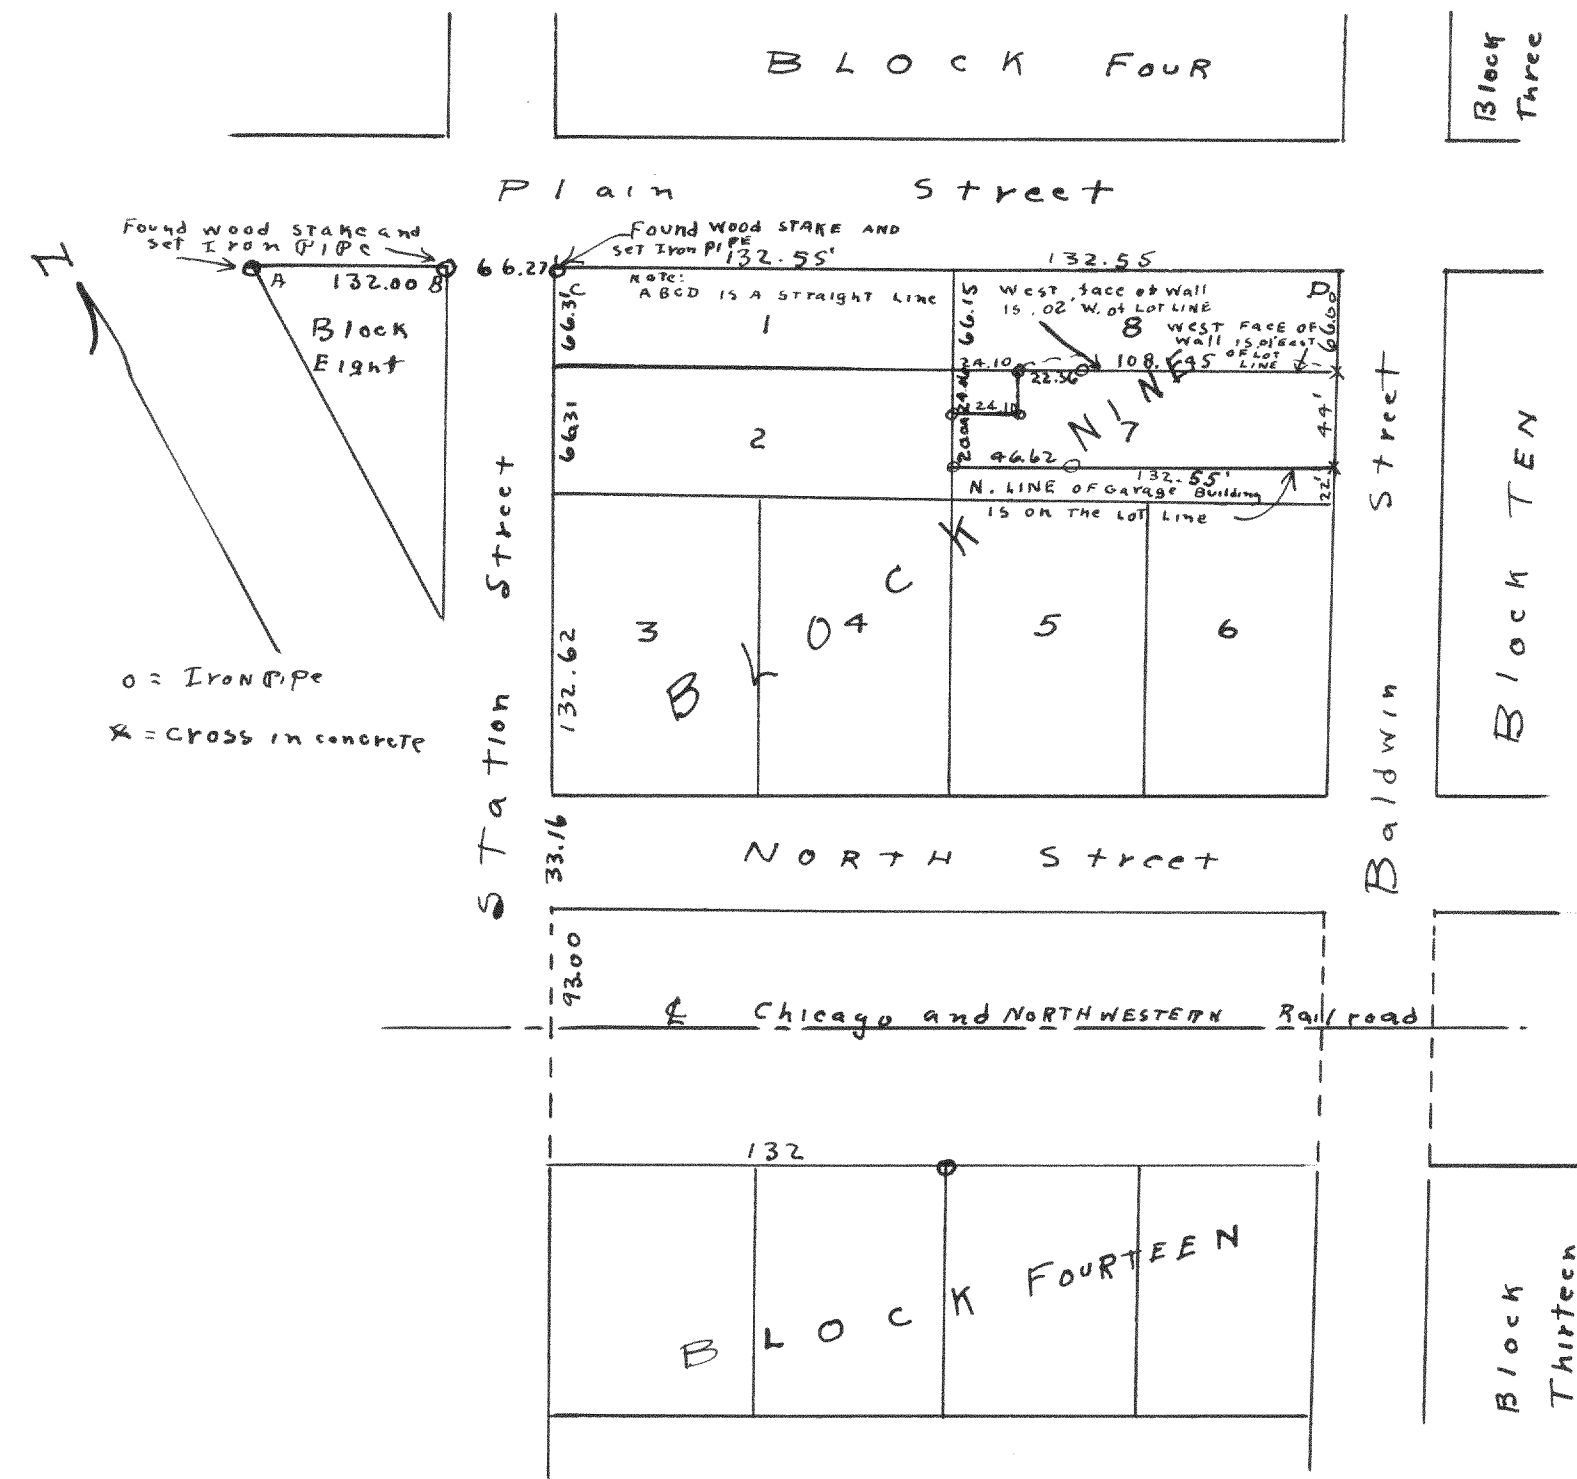

Plat of survey of part of Lot 7, Block 9 of the original Village of  
Sharon, Walworth County, Wisconsin  
March 29, 1946.

Lloyd L. Jensen  
County Surveyor  
G.T.D.