


#689

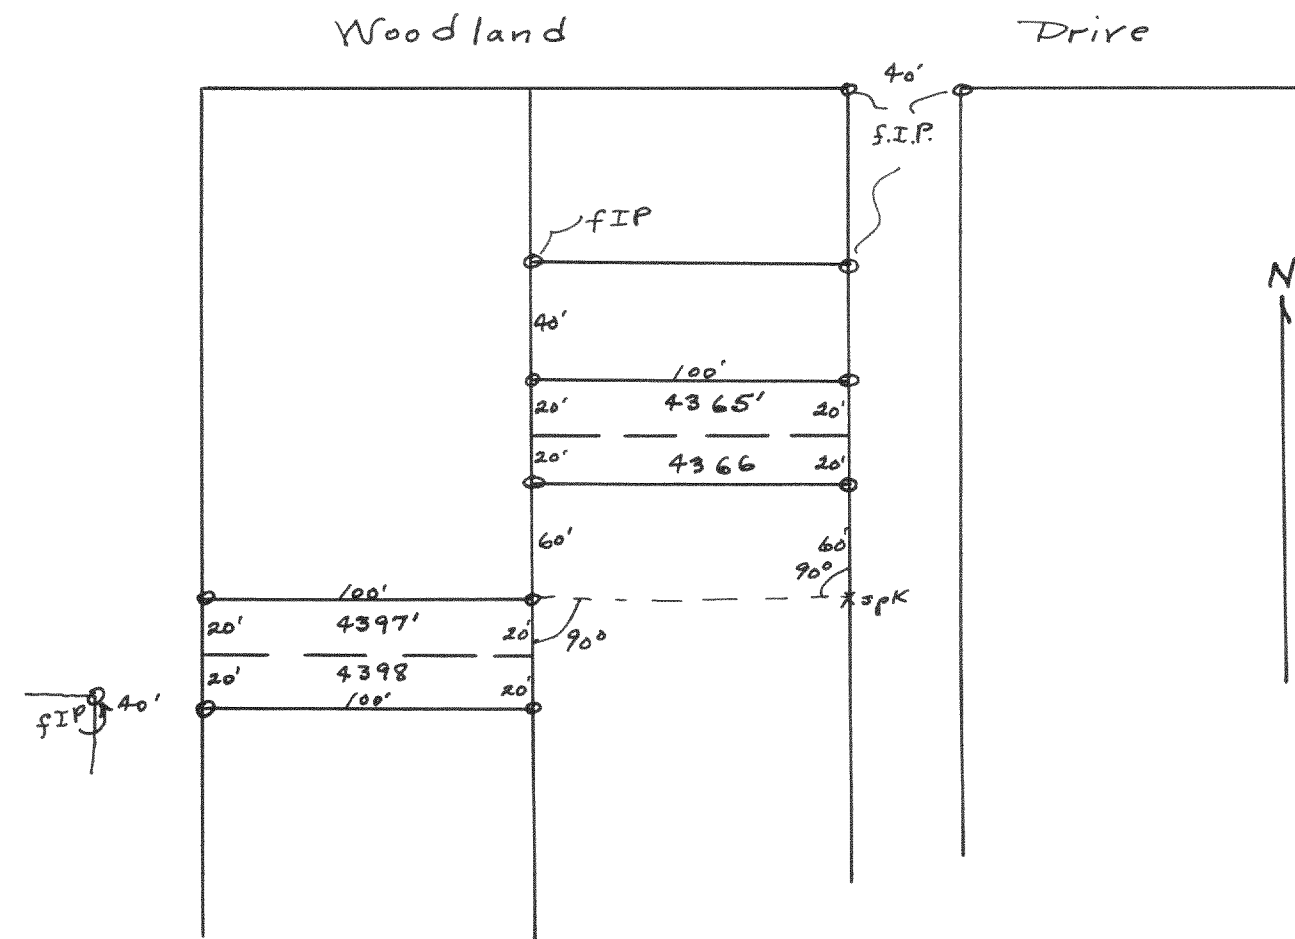


Plot of survey of lots in Lake Como
Beach Subd located in Geneva
Town Walworth County Wis.

May 16, 1946

Lloyd L. Jensen
County Surveyor

#1690

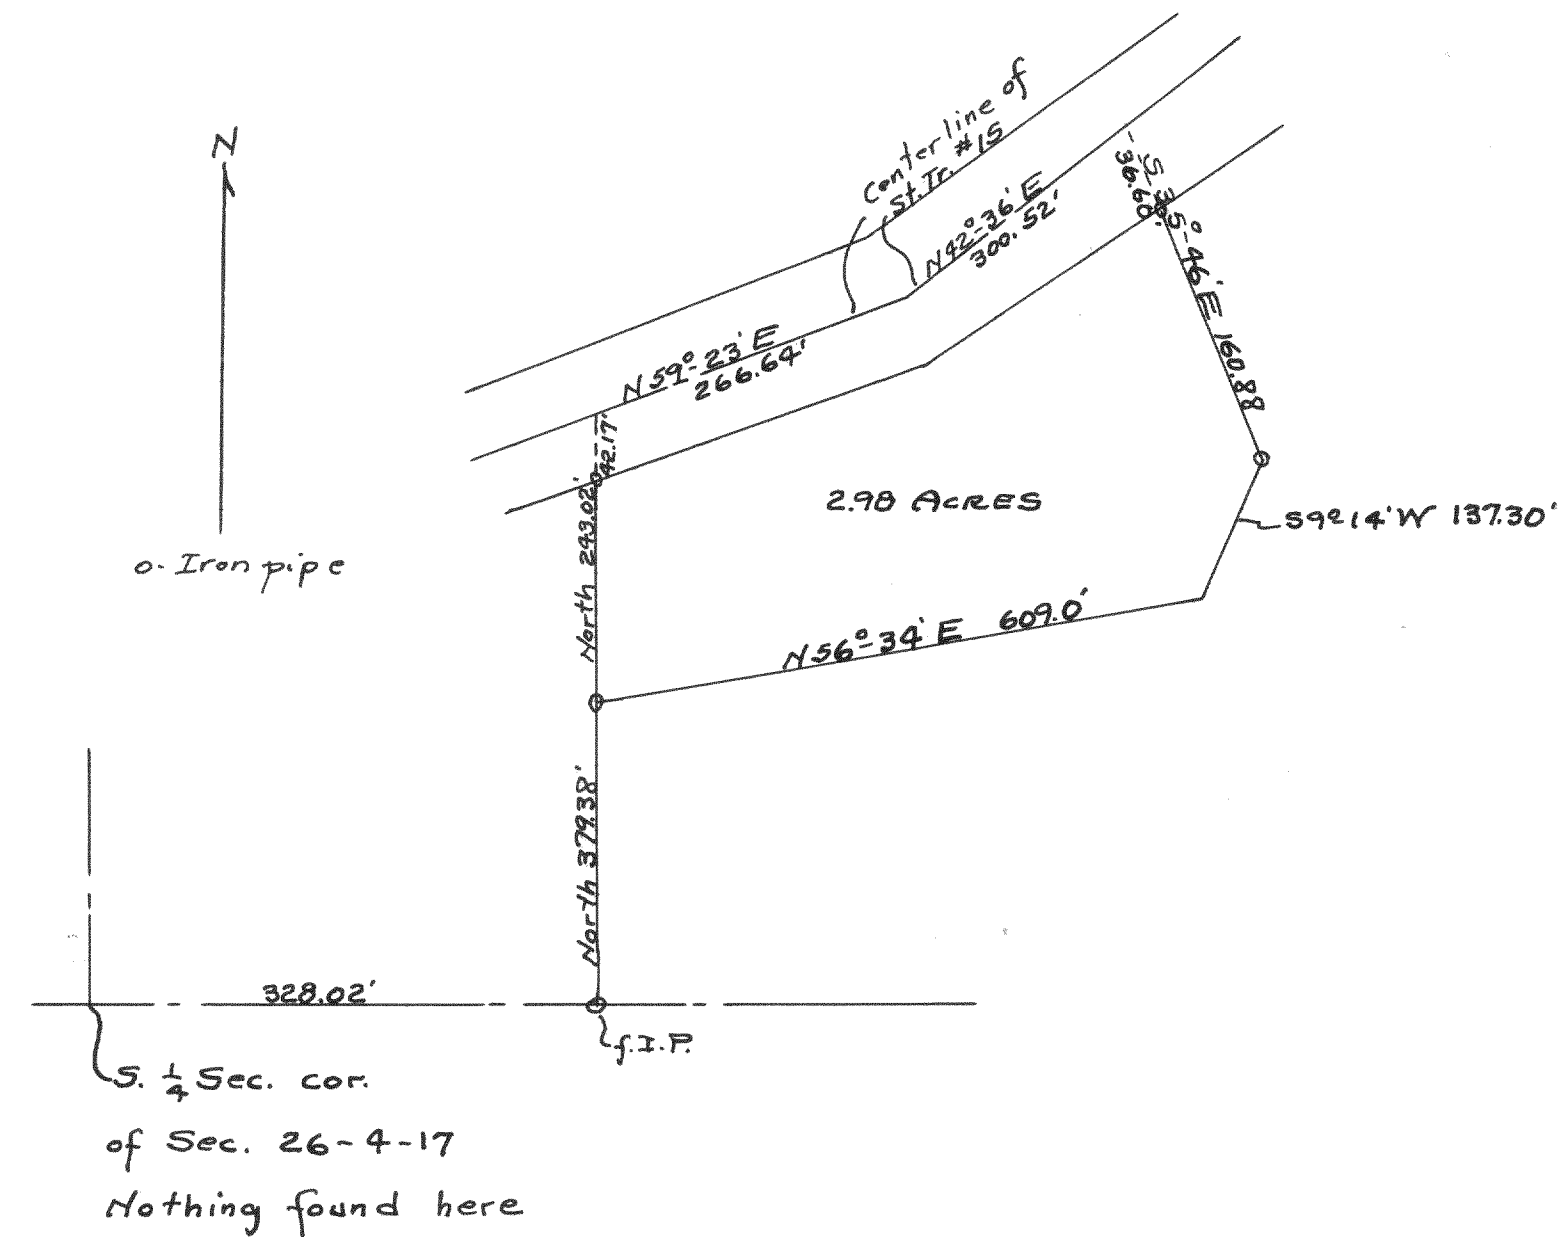

S. $\frac{1}{4}$ Sec. cor.
of Sec. 26-4-17
Nothing found here

Plot of a fence line survey of a
parcel of land located in the
Southeast $\frac{1}{4}$ of Section 26, T4N R17E
of Walworth County Wisconsin.

Dec. 1946

Lloyd L. Jensen
County Surveyor