



#1691.

#1692

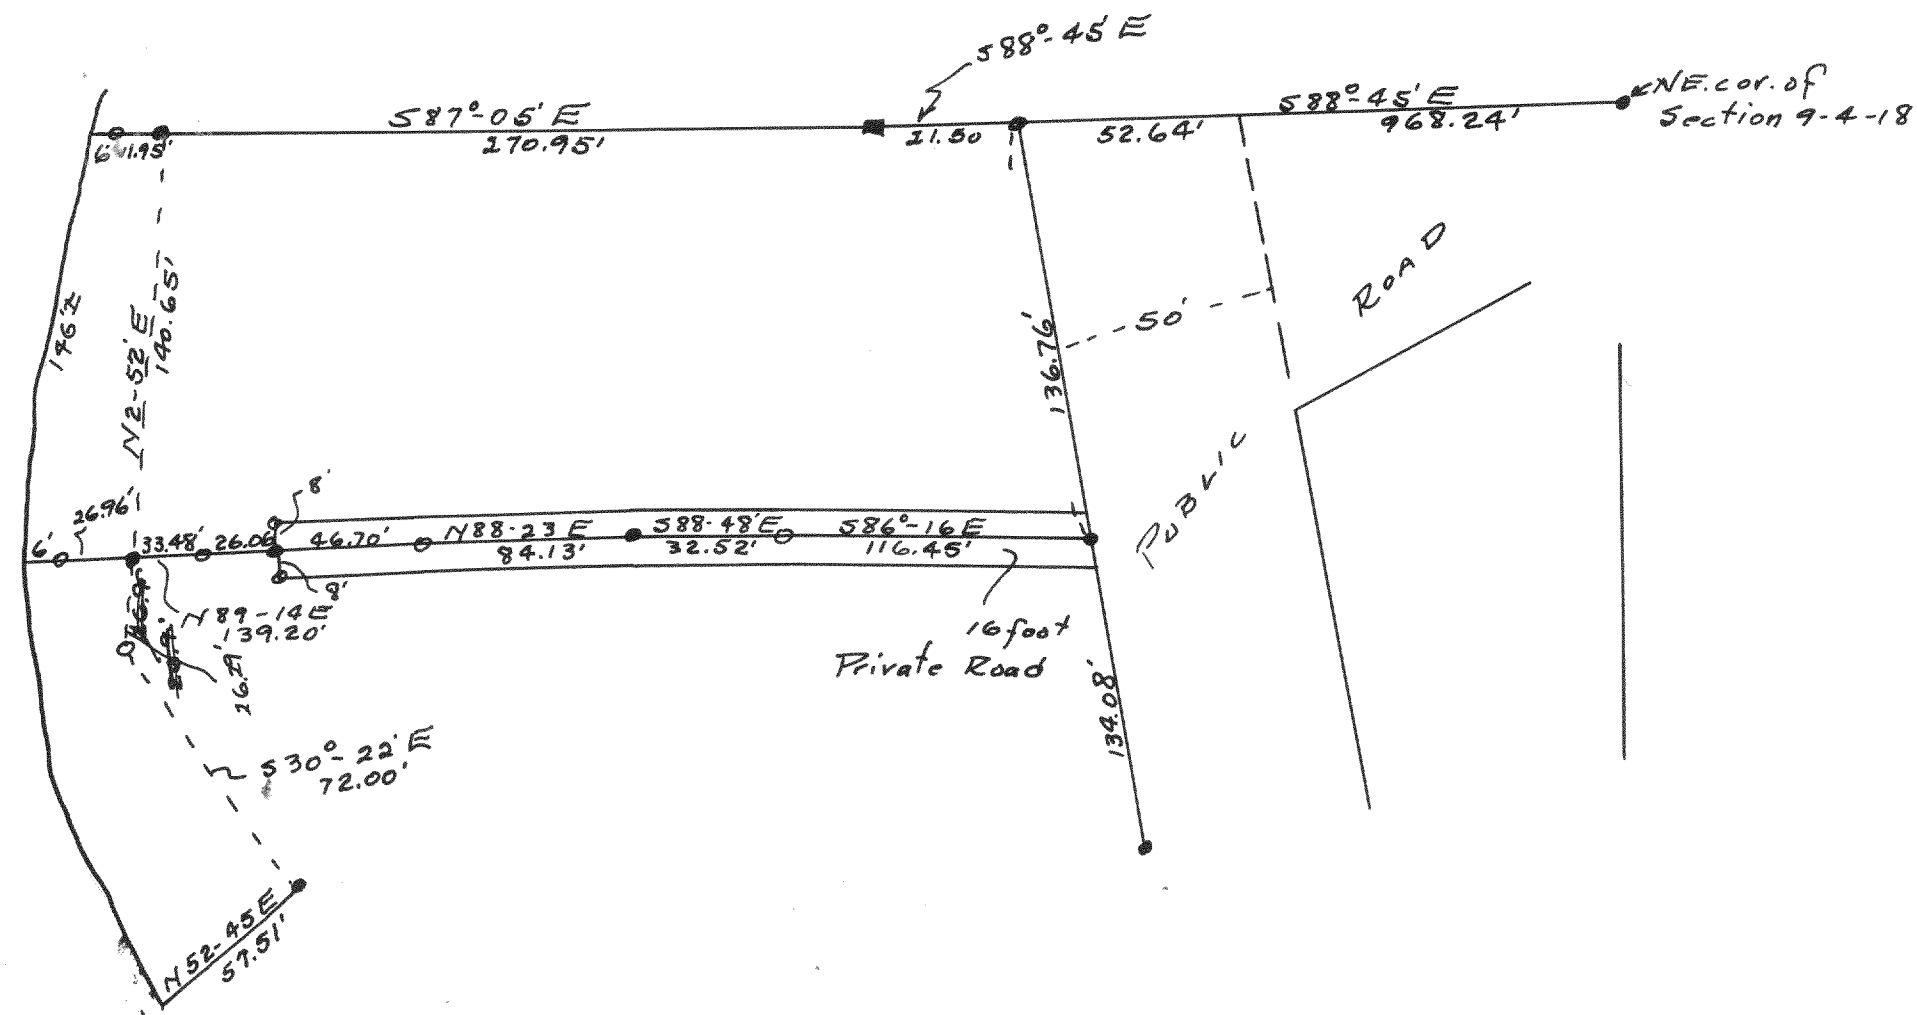

Plot of survey of the north part of the land
owned by Mrs. Lippert in Section 9, T47N R18 E of
Walworth County Wisconsin.

See survey 1392 for South part of land.
Sept. 1946
Lloyd L. Jensen
County Surveyor

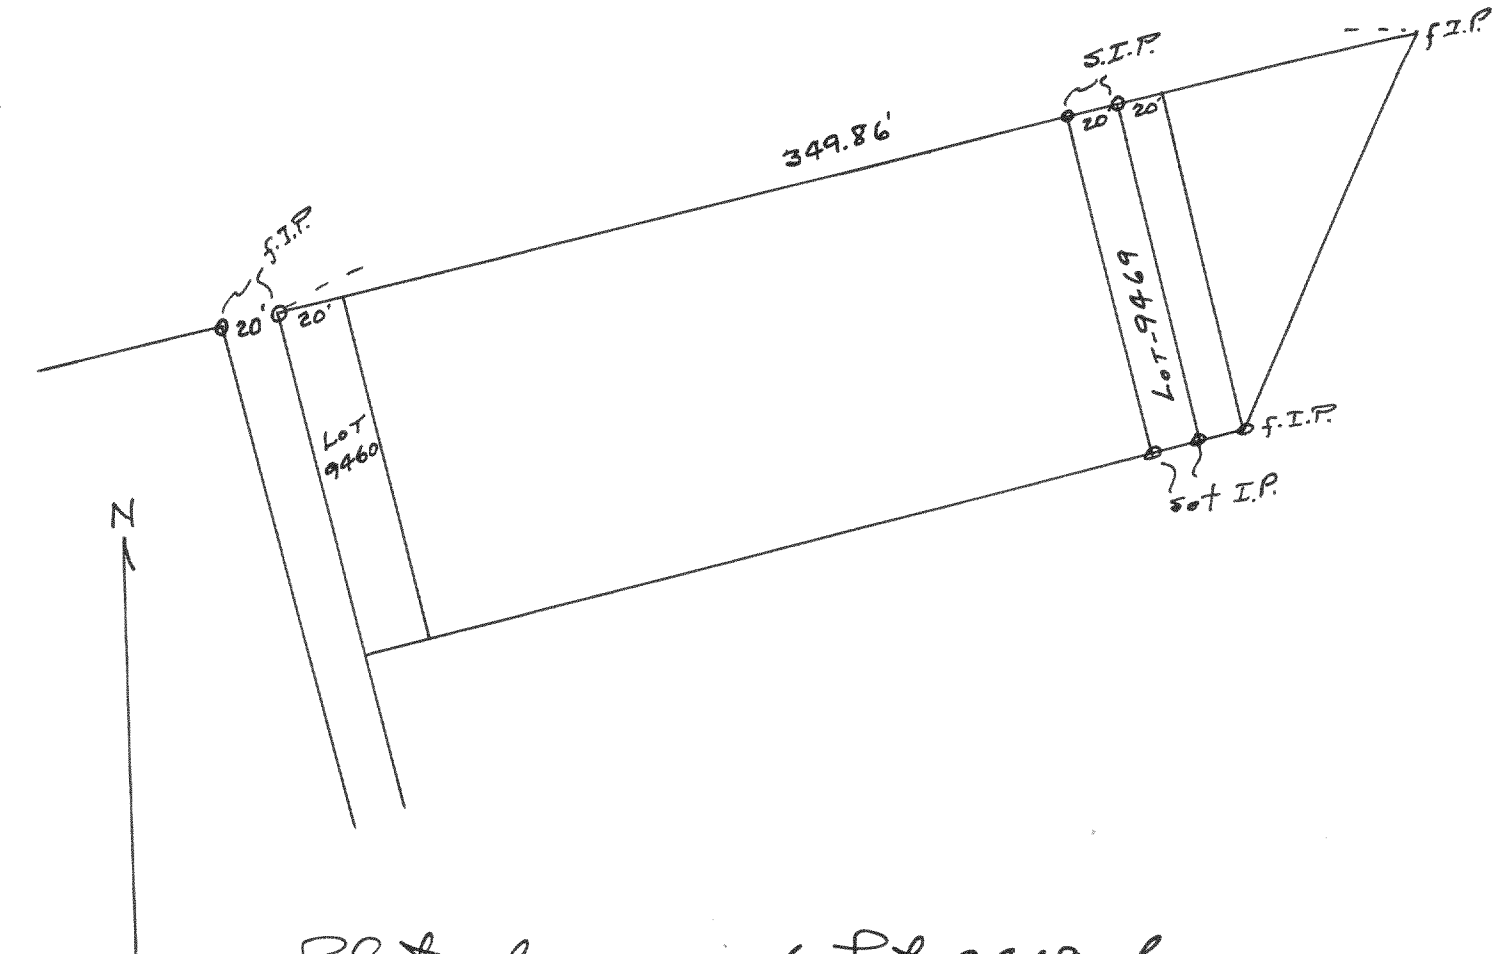

Plot of survey of Lot 9469 of
Pell Lake Subd.

June 1946

Lloyd L. Jensen
County Surveyor