



#1719

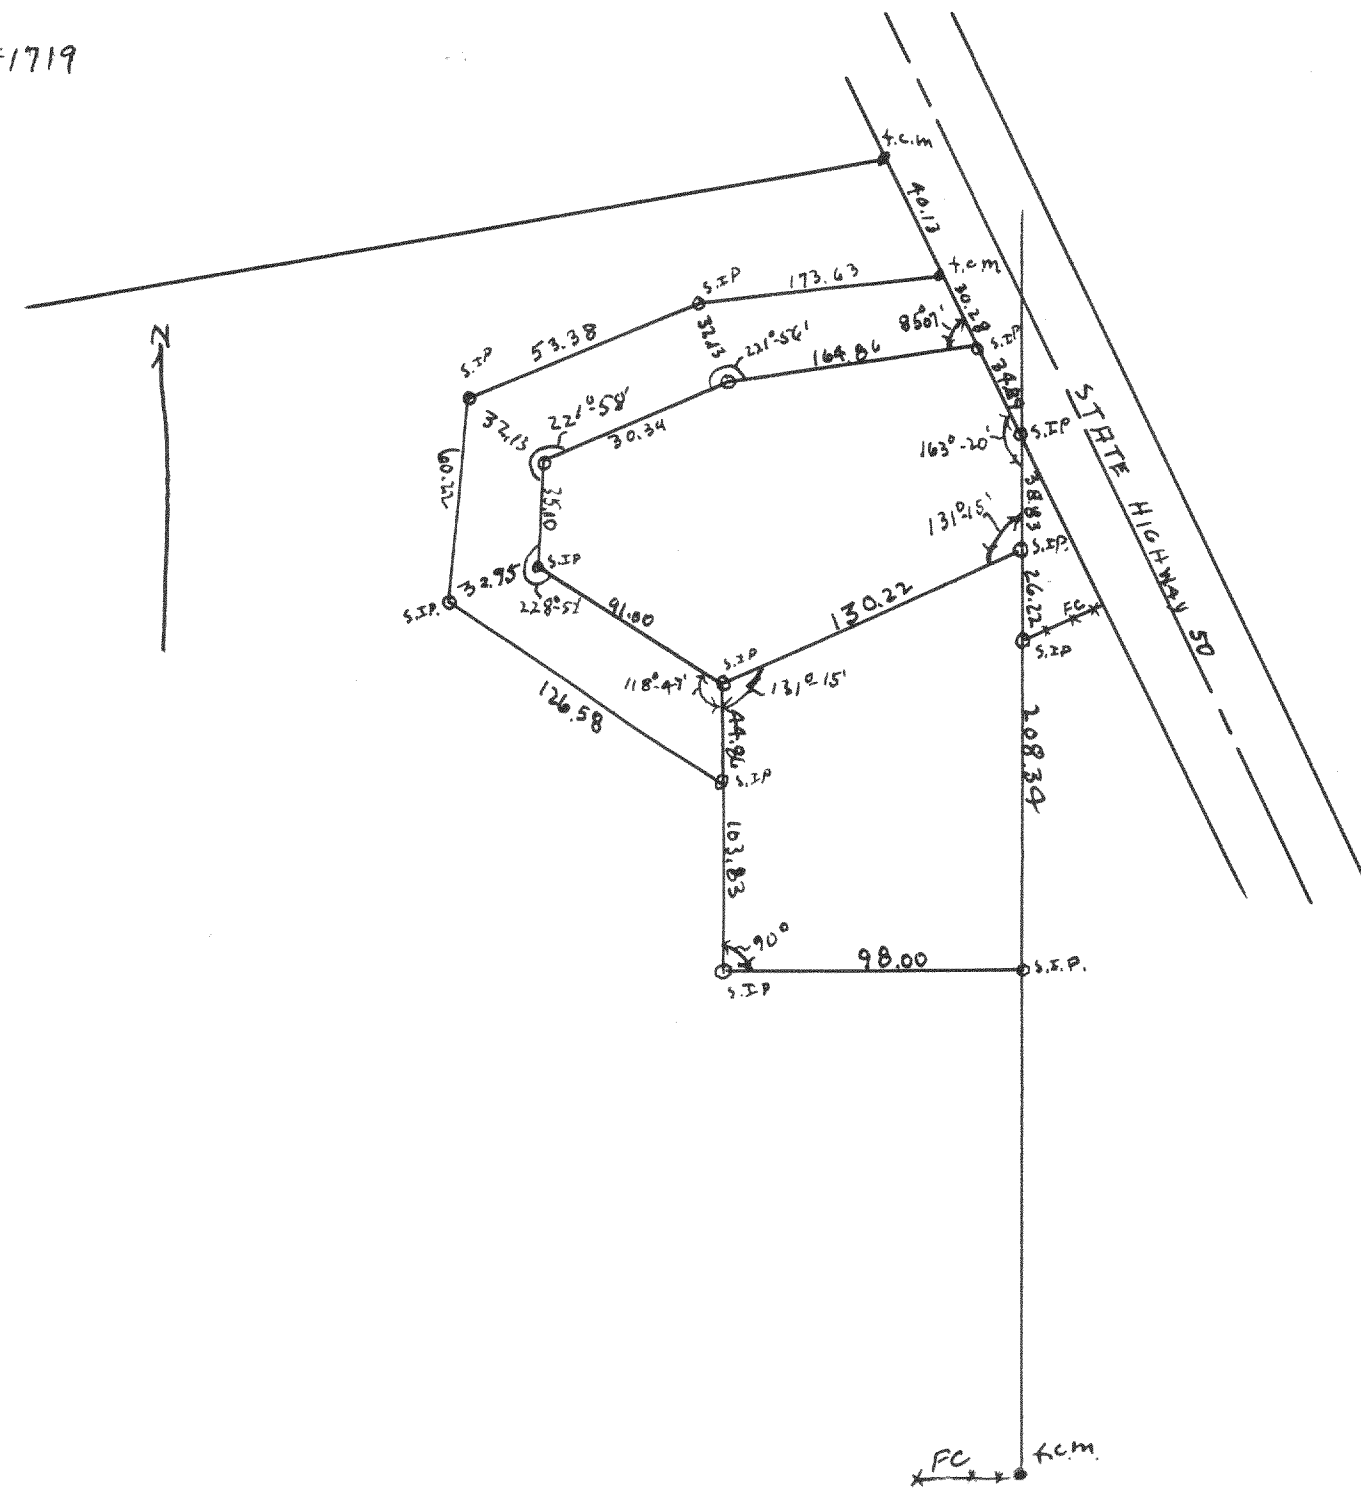

Plot of survey of parcel of land on the Berthelworth property
located in the NW 1/4 of section 31-T2N R17E.
Oct 1, 1947

Lloyd S Jensen
County Surveyor
[Signature]

#1720

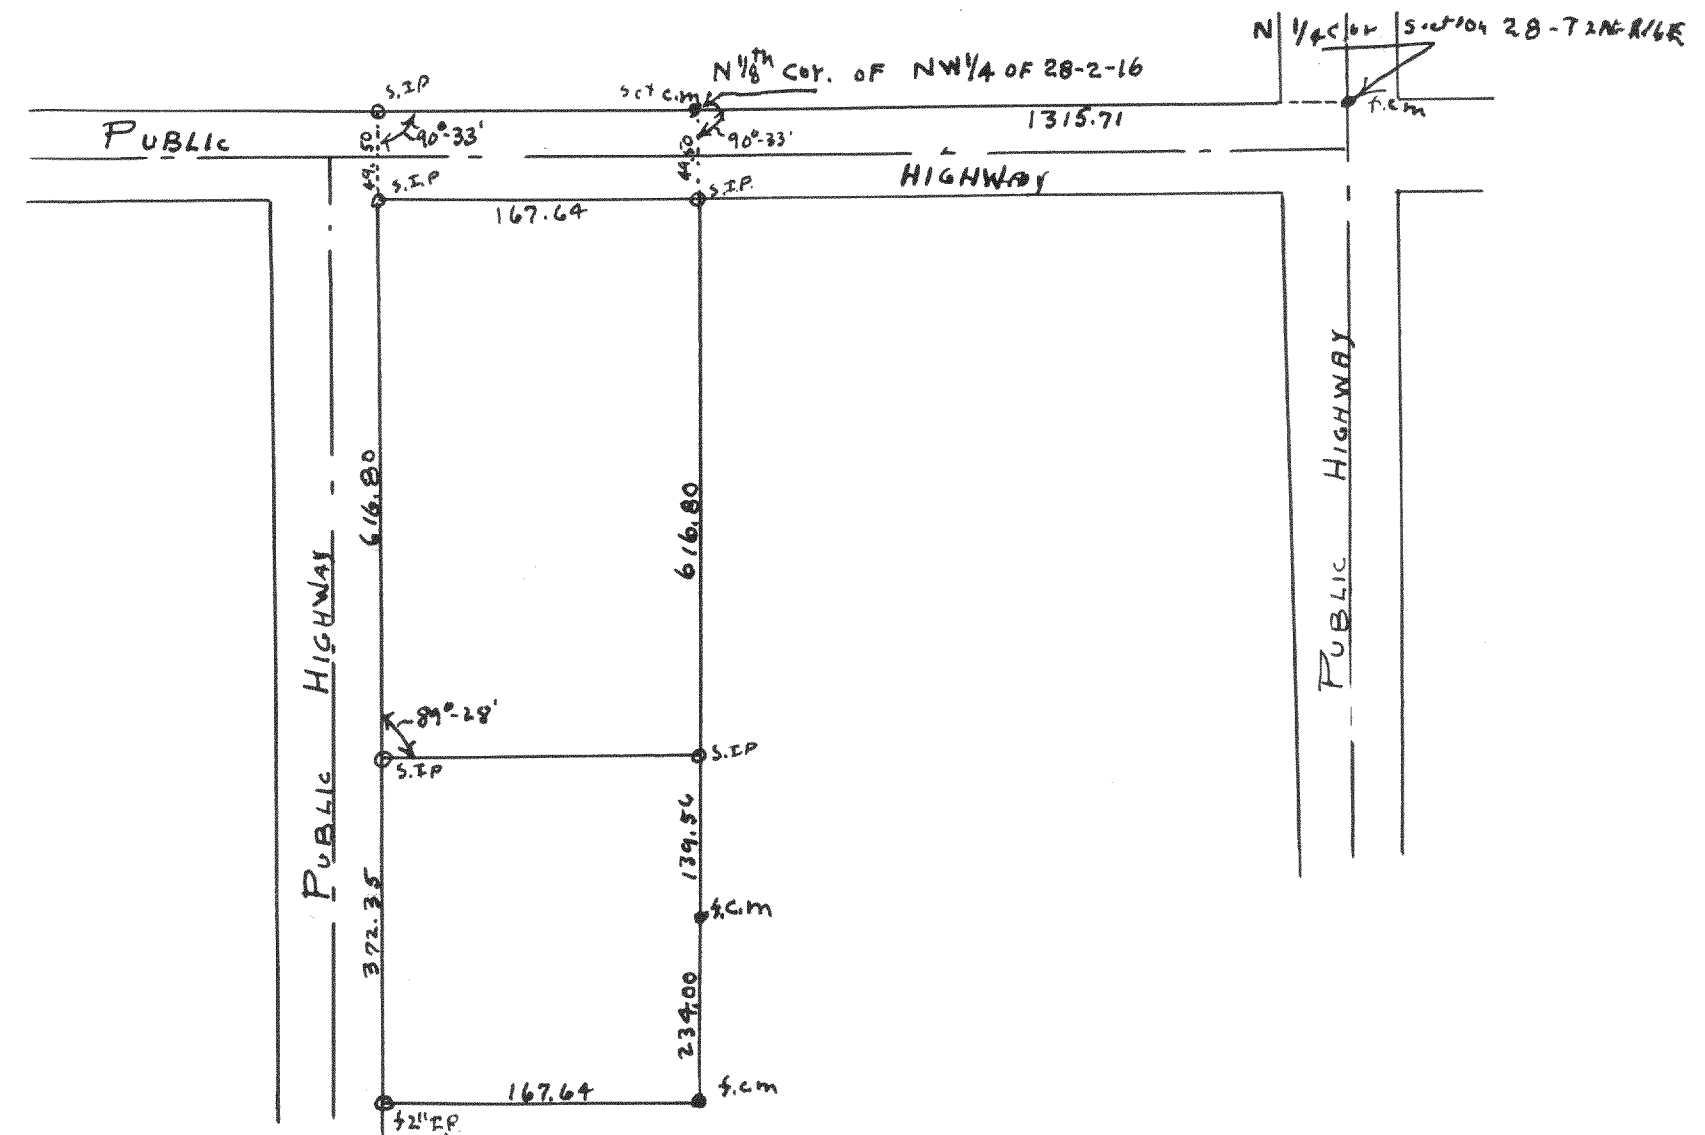

Plot of survey of parcel of land located in the
NW 1/4 of section 28, T2N, R16E of Walworth
County, Wisconsin

Oct 14, 1947

Lloyd S Jensen
County Surveyor
[Signature]