


#1731

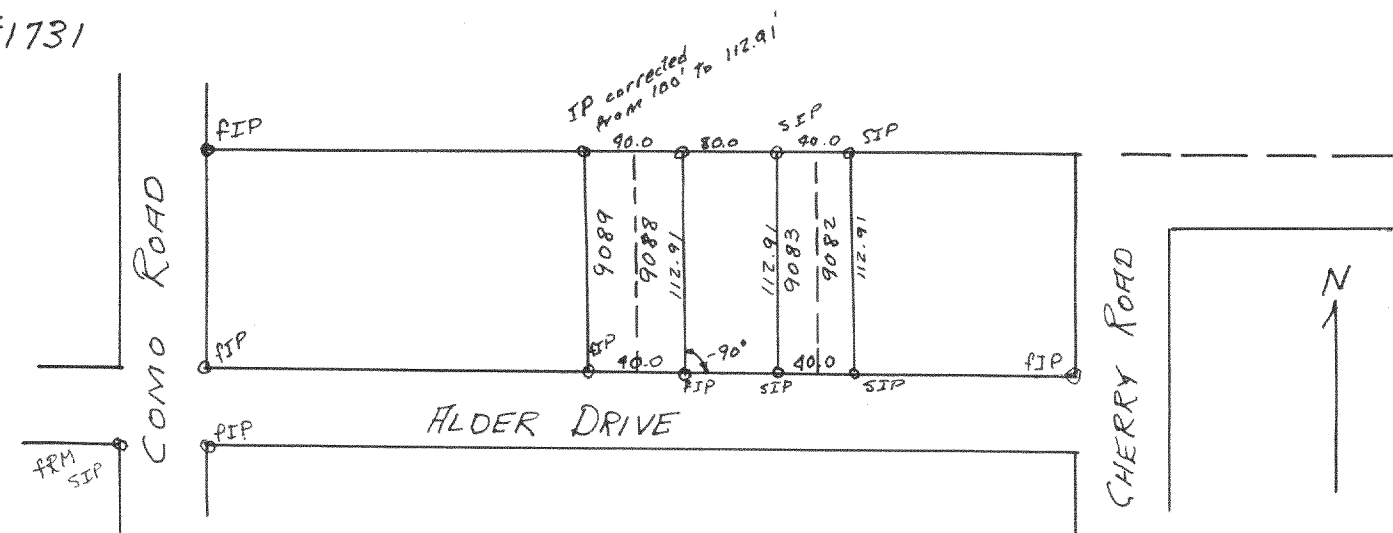


Plat of survey of Lots 9082-9083 of 4th map Lake Como Beach Subdivision, Walworth County, Wisconsin

1947

Lloyd E Jensen
County Surveyor
LSD

#1732

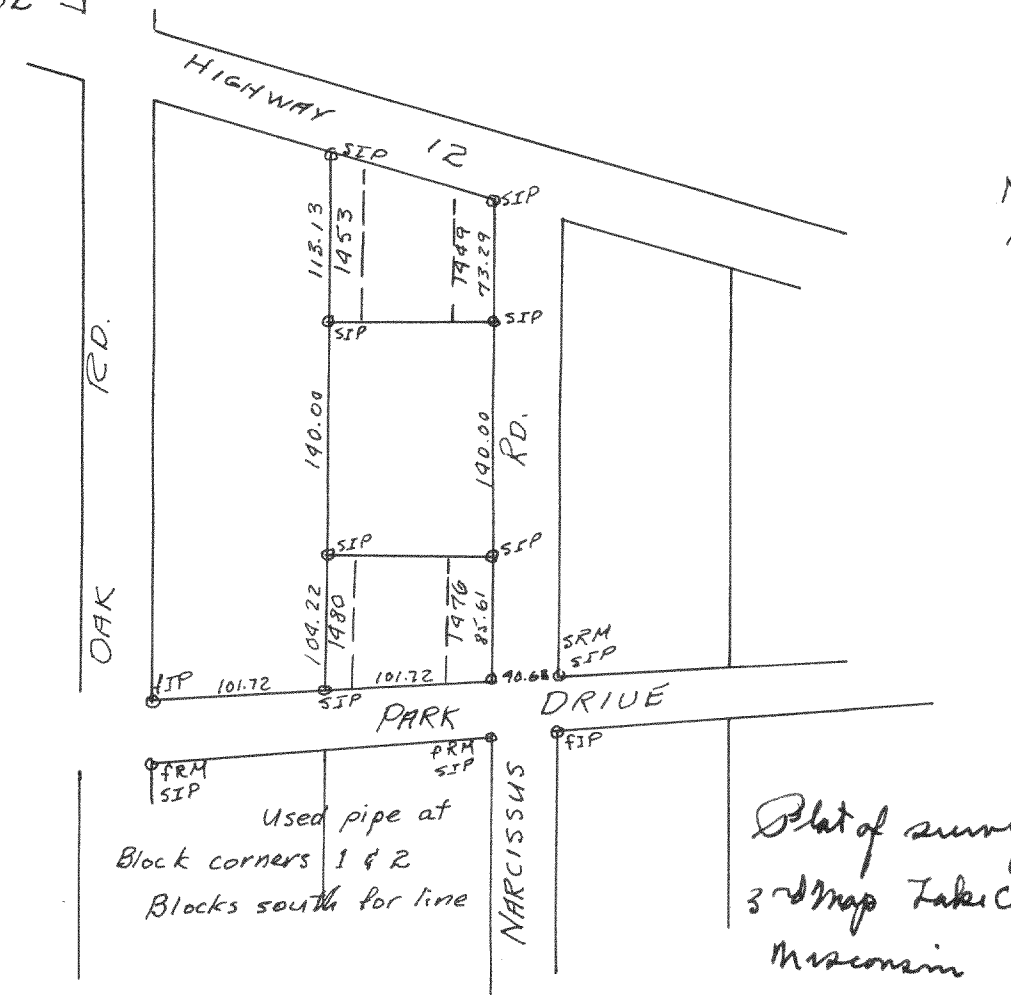


Plat of survey of lots 1449-1453, 1476-1480 of 3rd map Lake Como Beach Subdivision, Walworth County, Wisconsin

1947

Lloyd E Jensen
County Surveyor
LSD


#1733

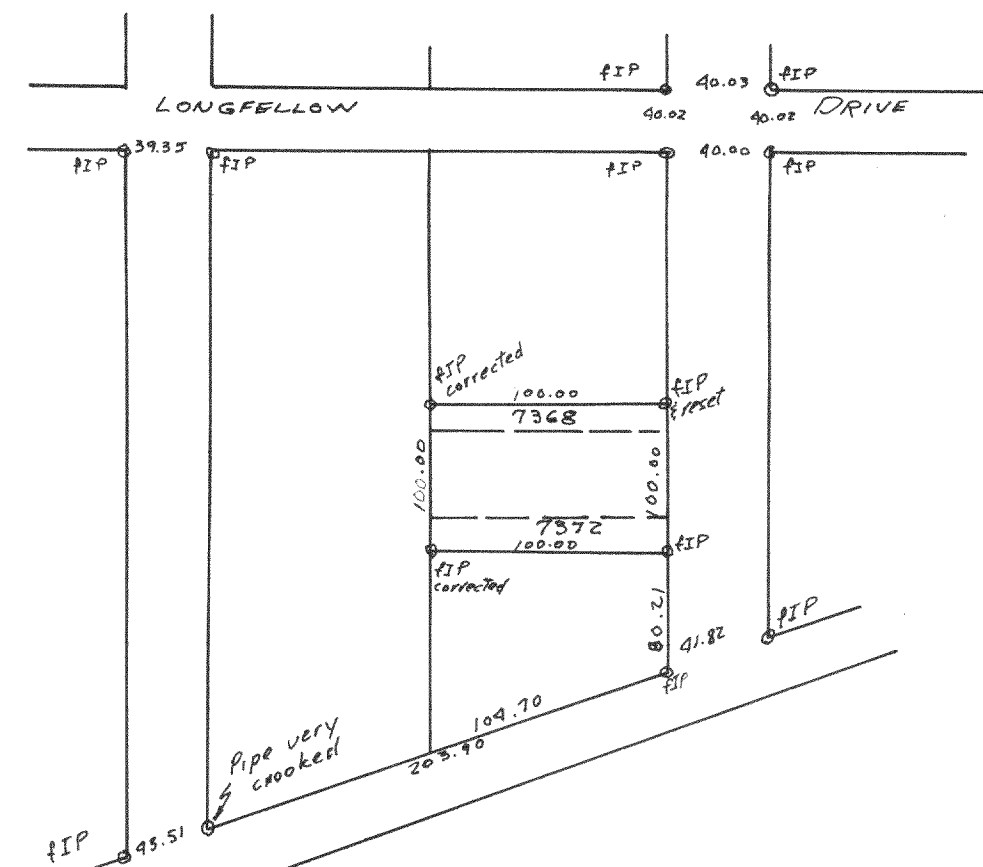

Plat of survey of lots 7368-7372 Lake Como Beach Subdivision, Walworth County, Wisconsin
April 14, 1947

Lloyd E Jensen
County Surveyor
LSD

#1734

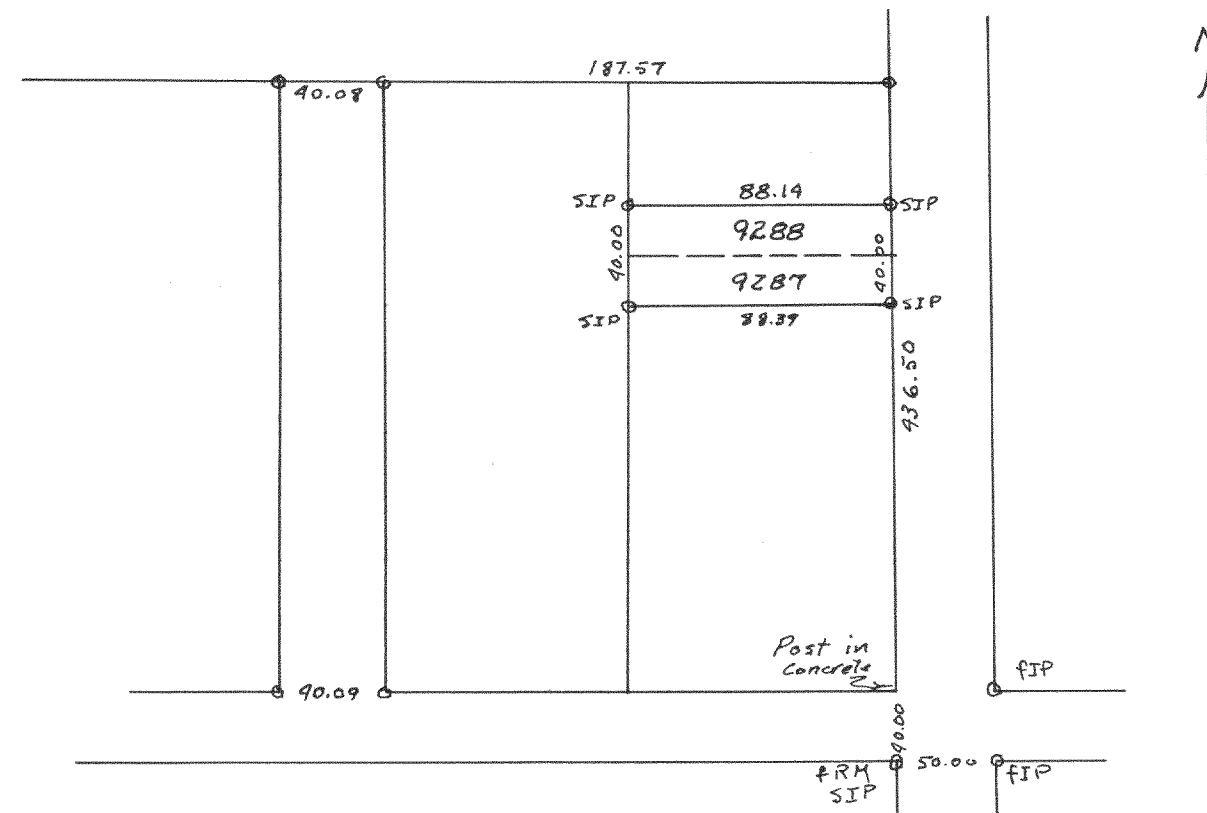

Lots 9287-9288 Lake Como Beach Subdivision in Walworth County, Wisconsin
April 14, 1947

Lloyd E Jensen
County Surveyor
LSD