


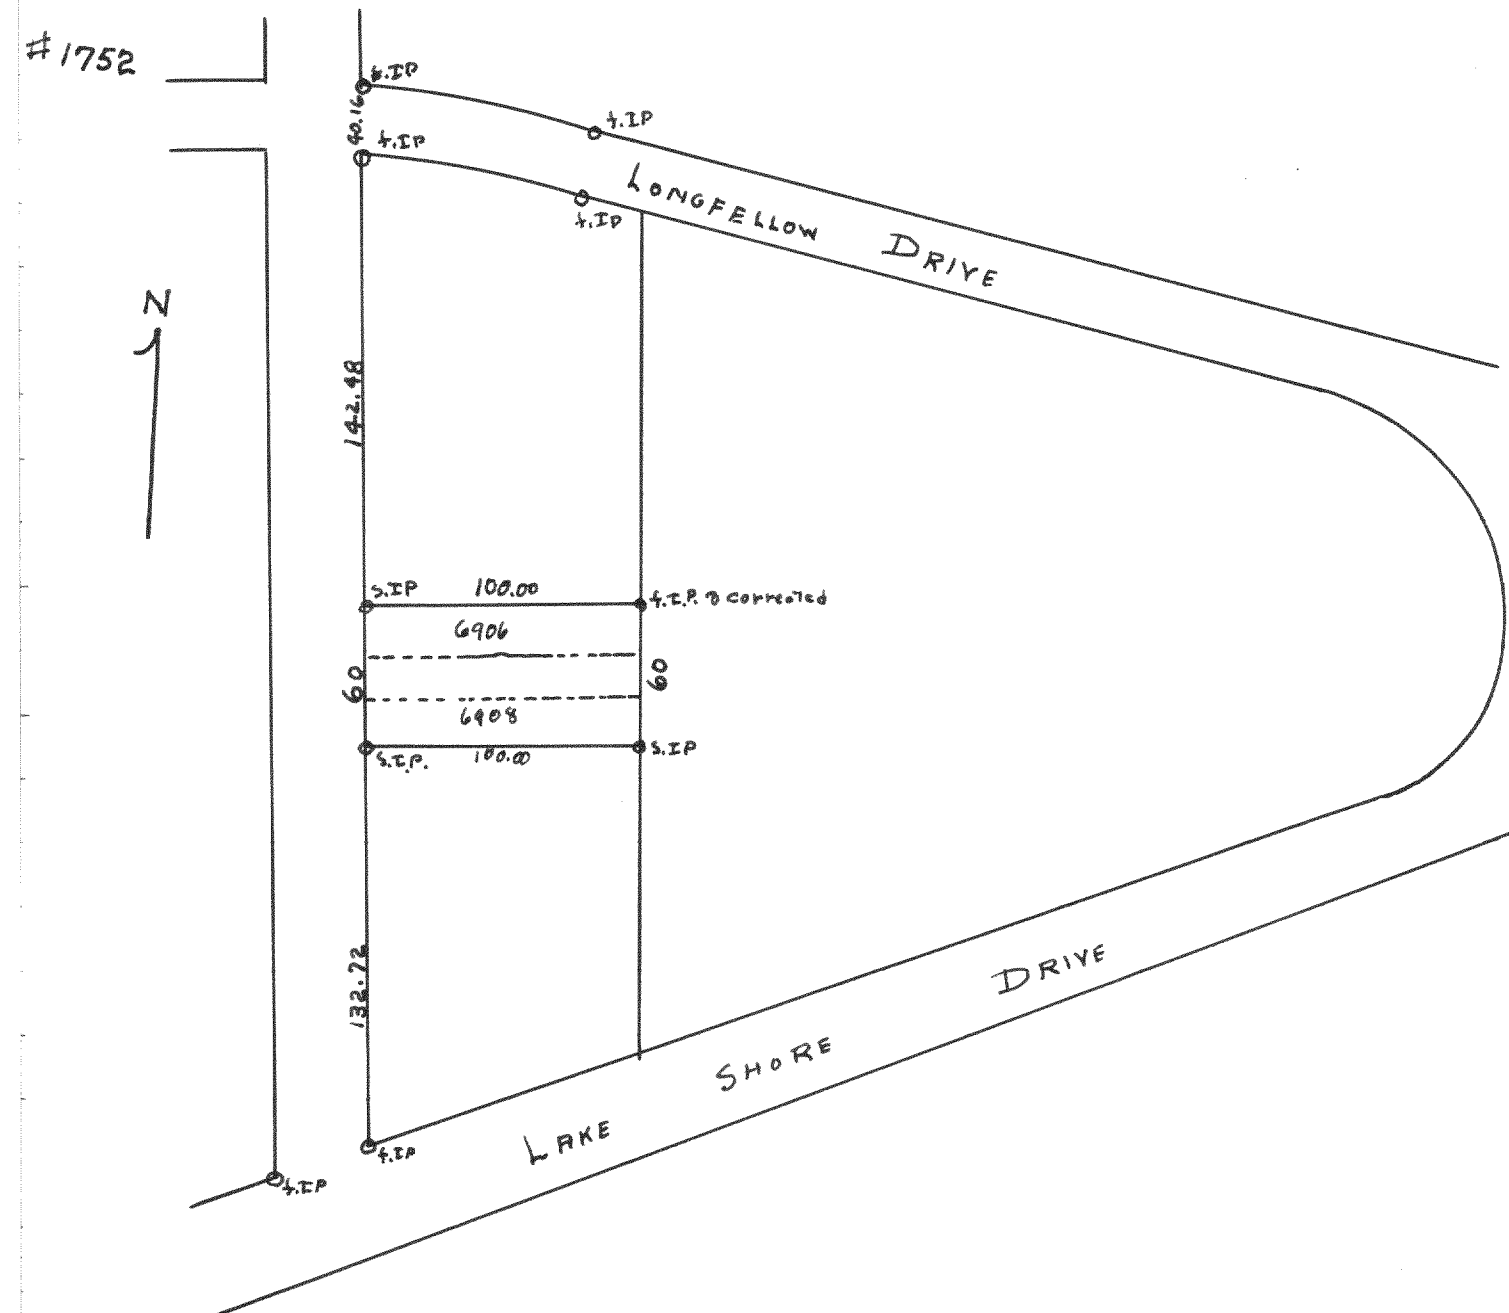


Plot of survey of lots 6906-6908 Lake Como Beach
Malworth County Wisconsin

June 13, 1947

Floyd E Jensen
County Surveyor
FES

#1753

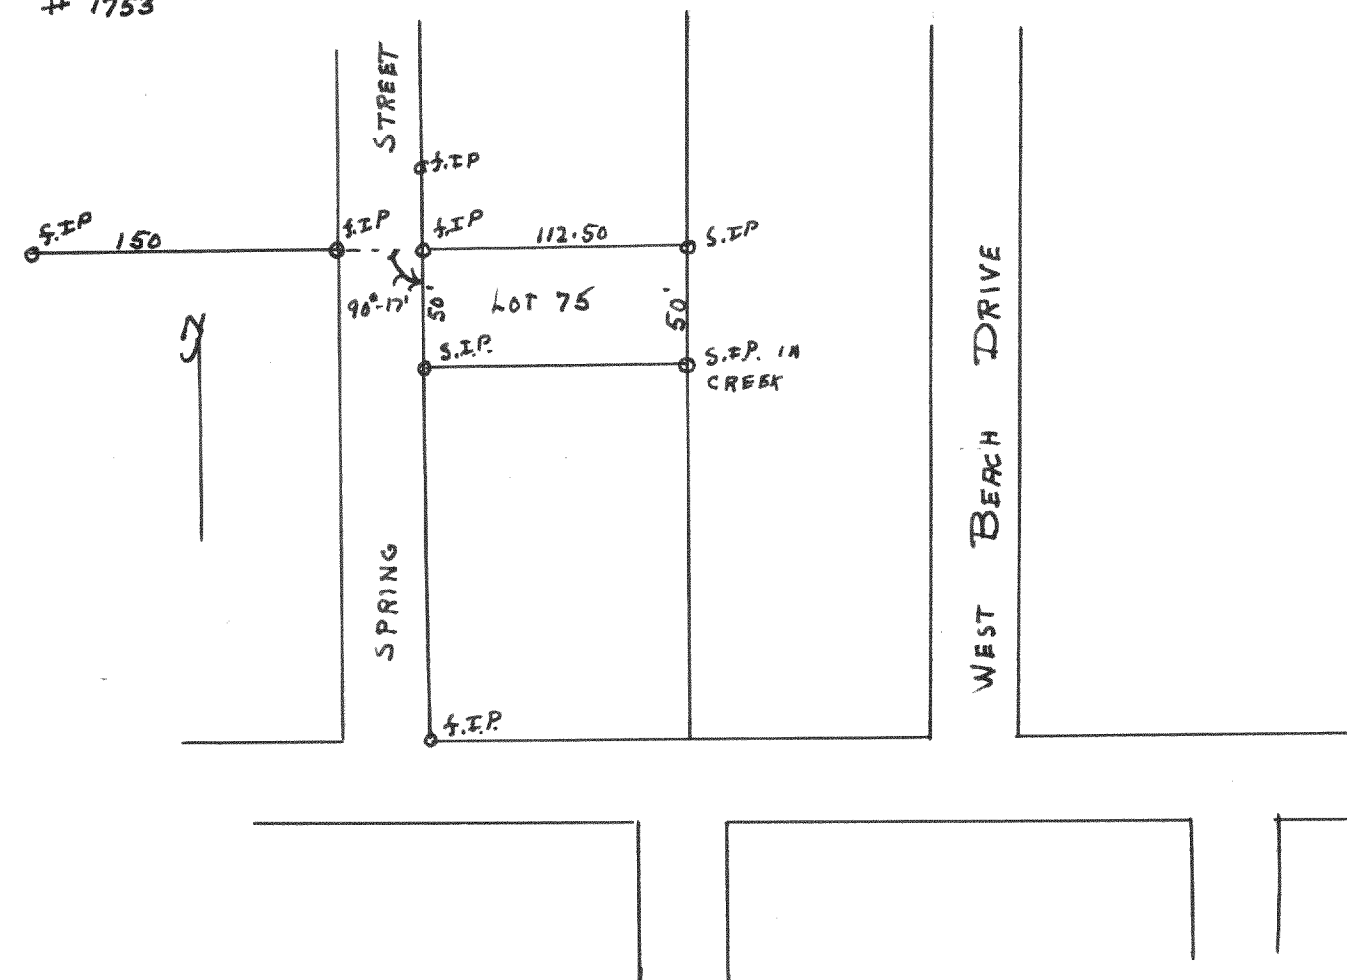

Plot of survey of lot 75 Lake ~~Como~~^{Como} Beach subdivision
Malworth County Wisconsin

July 5, 1947

Floyd E Jensen
County Surveyor
FES