


#1762

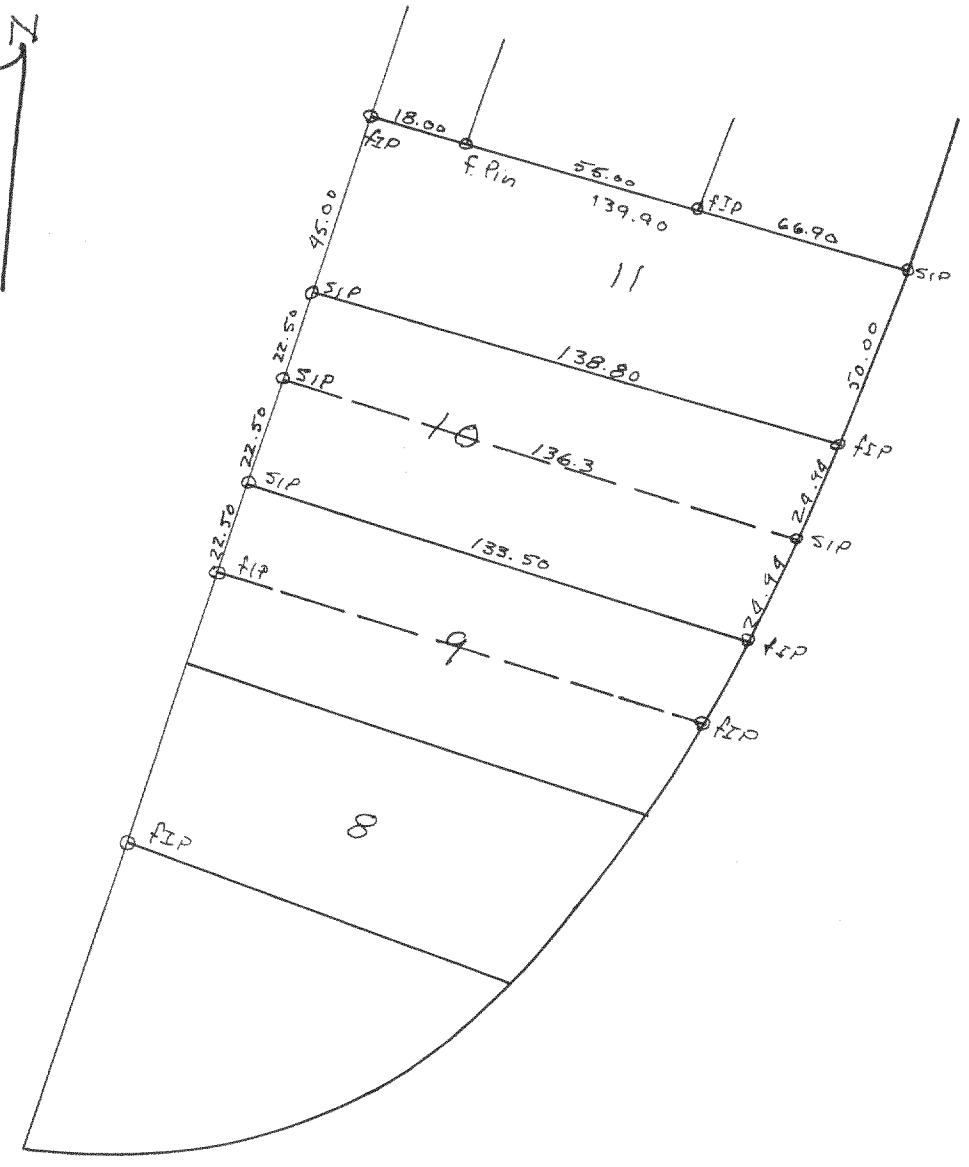


Plot of survey of $\frac{1}{2}$ lot 10 and lot 11, and $\frac{1}{2}$ lot 9 and $\frac{1}{2}$ lot 10 in Block 3 of Indian Hills in Fontana, Walworth County, Wisconsin

Aug 21, 1947

Lloyd S Jensen
County Surveyor
LSD

#1763

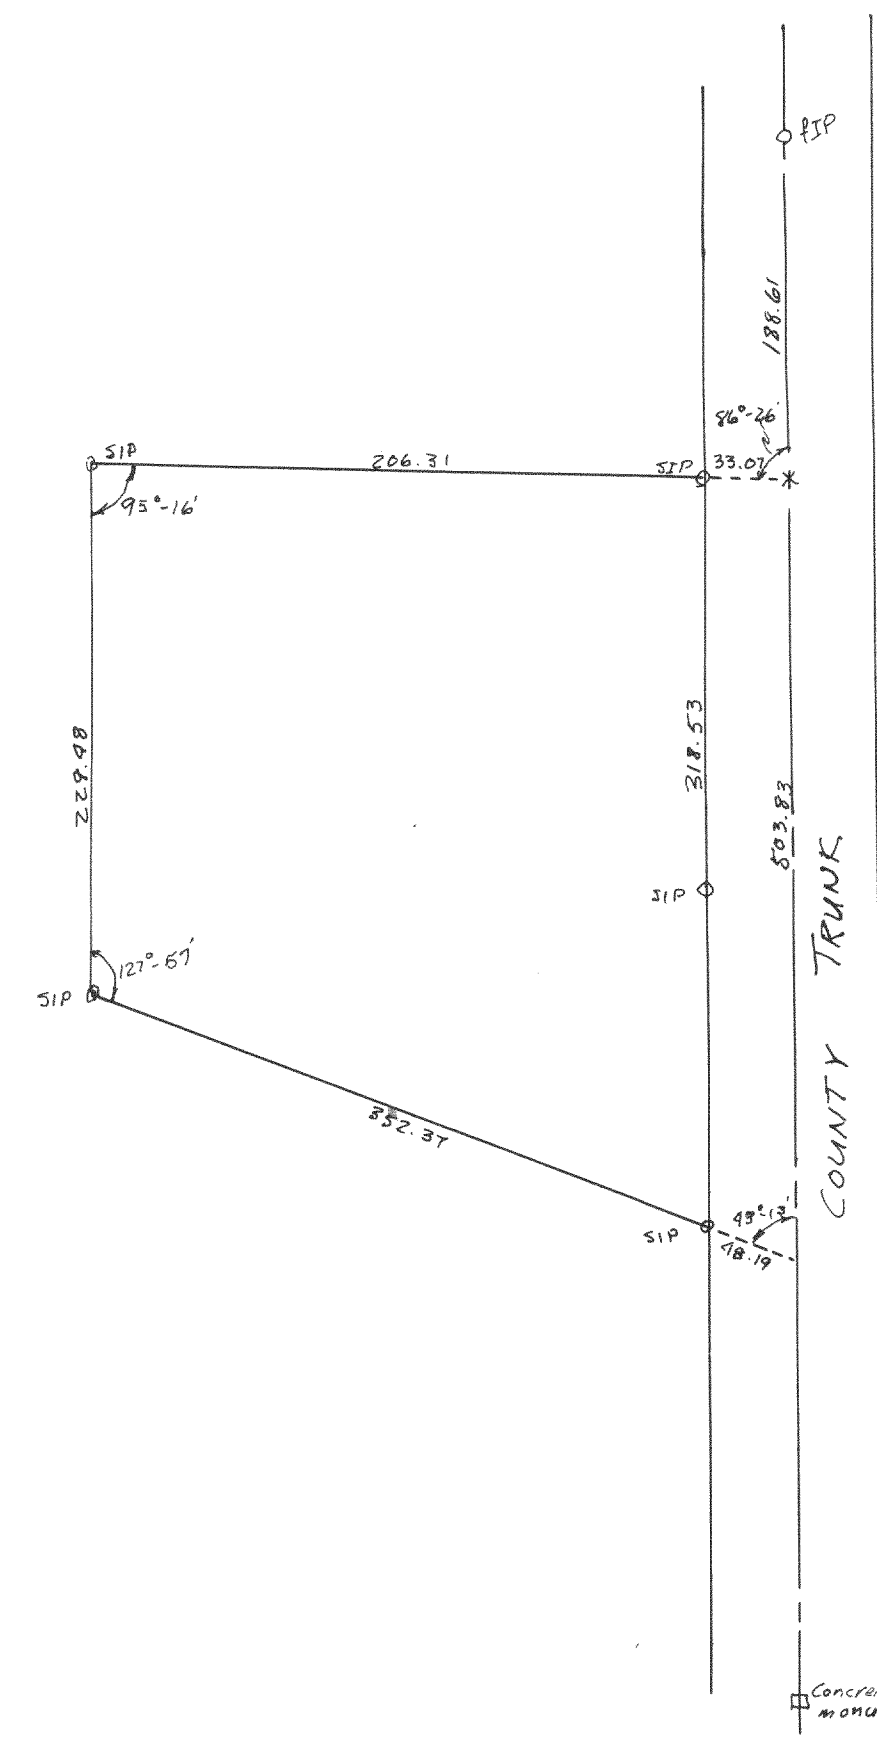

Plot of survey of parcel of land on Al Blodgett's Farm located in Section 22-T2N-R16E of Walworth County, Wisconsin

Aug 27, 1947

Lloyd S Jensen
County Surveyor
LSD

Concrete monument SE COR. SEC. 22-R-16