


17 66

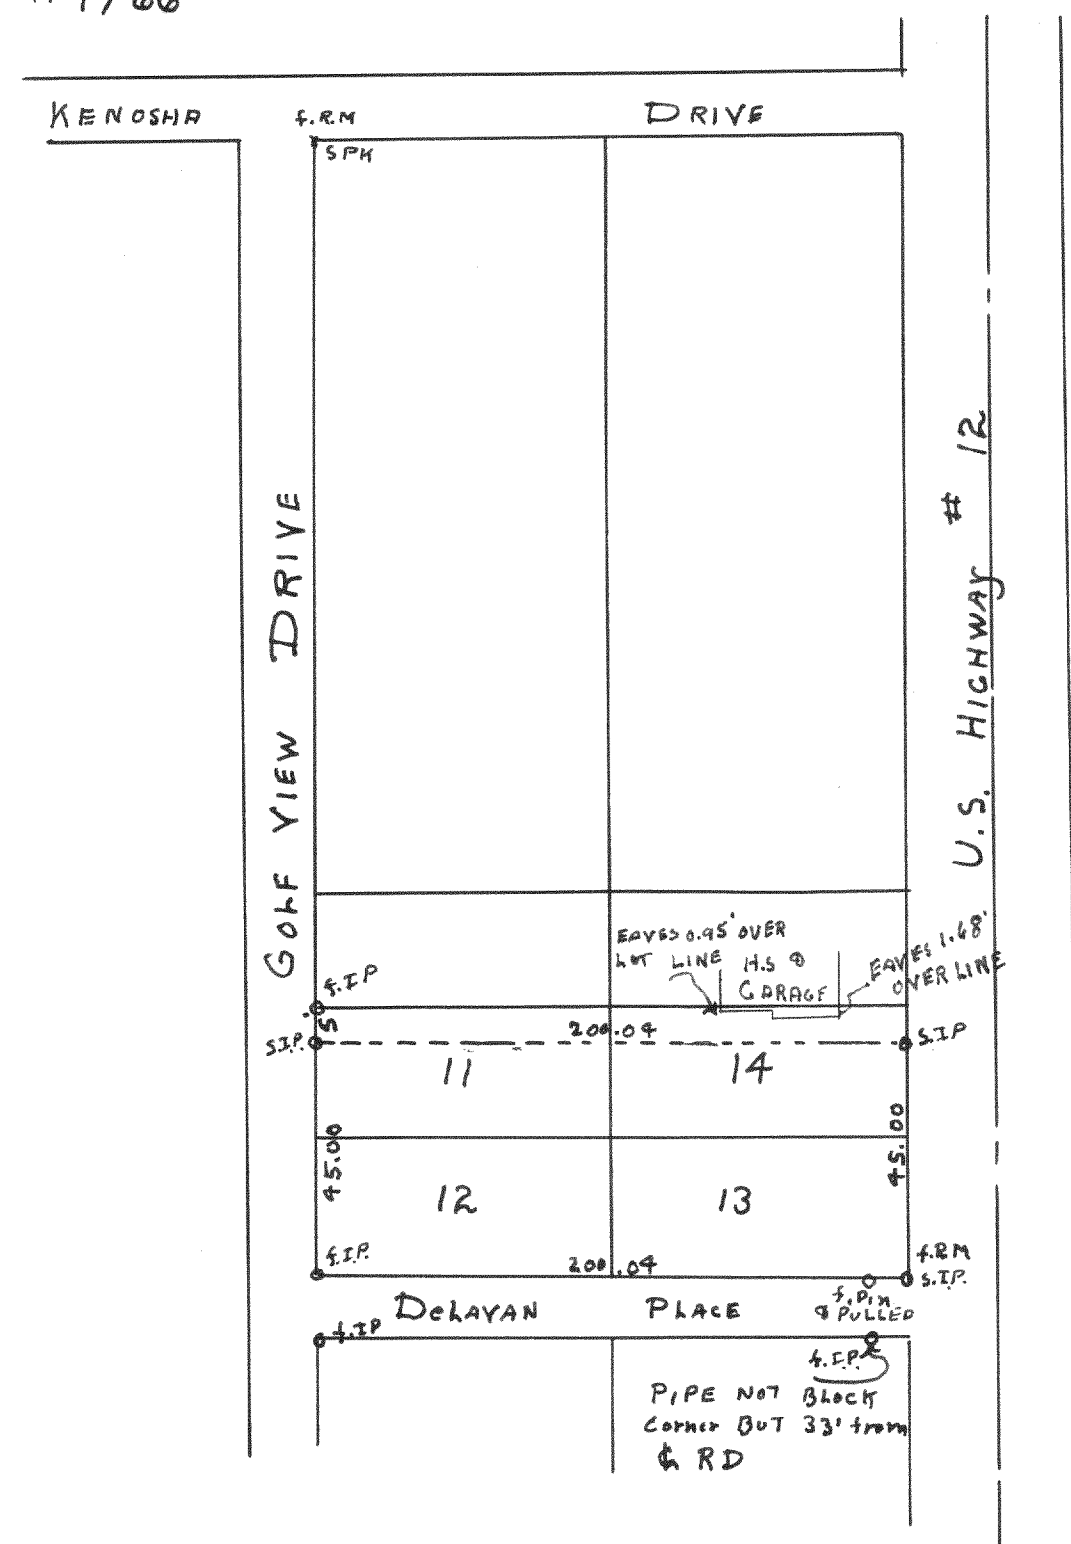


Plot of survey of lots 12-13 and the south 45' of lots 11 & 14 of Block 23 in Mandawega subdivision, Walworth County, Wisconsin

Nov 20, 47

Lloyd L. Jensen
County Surveyor
1560

1767

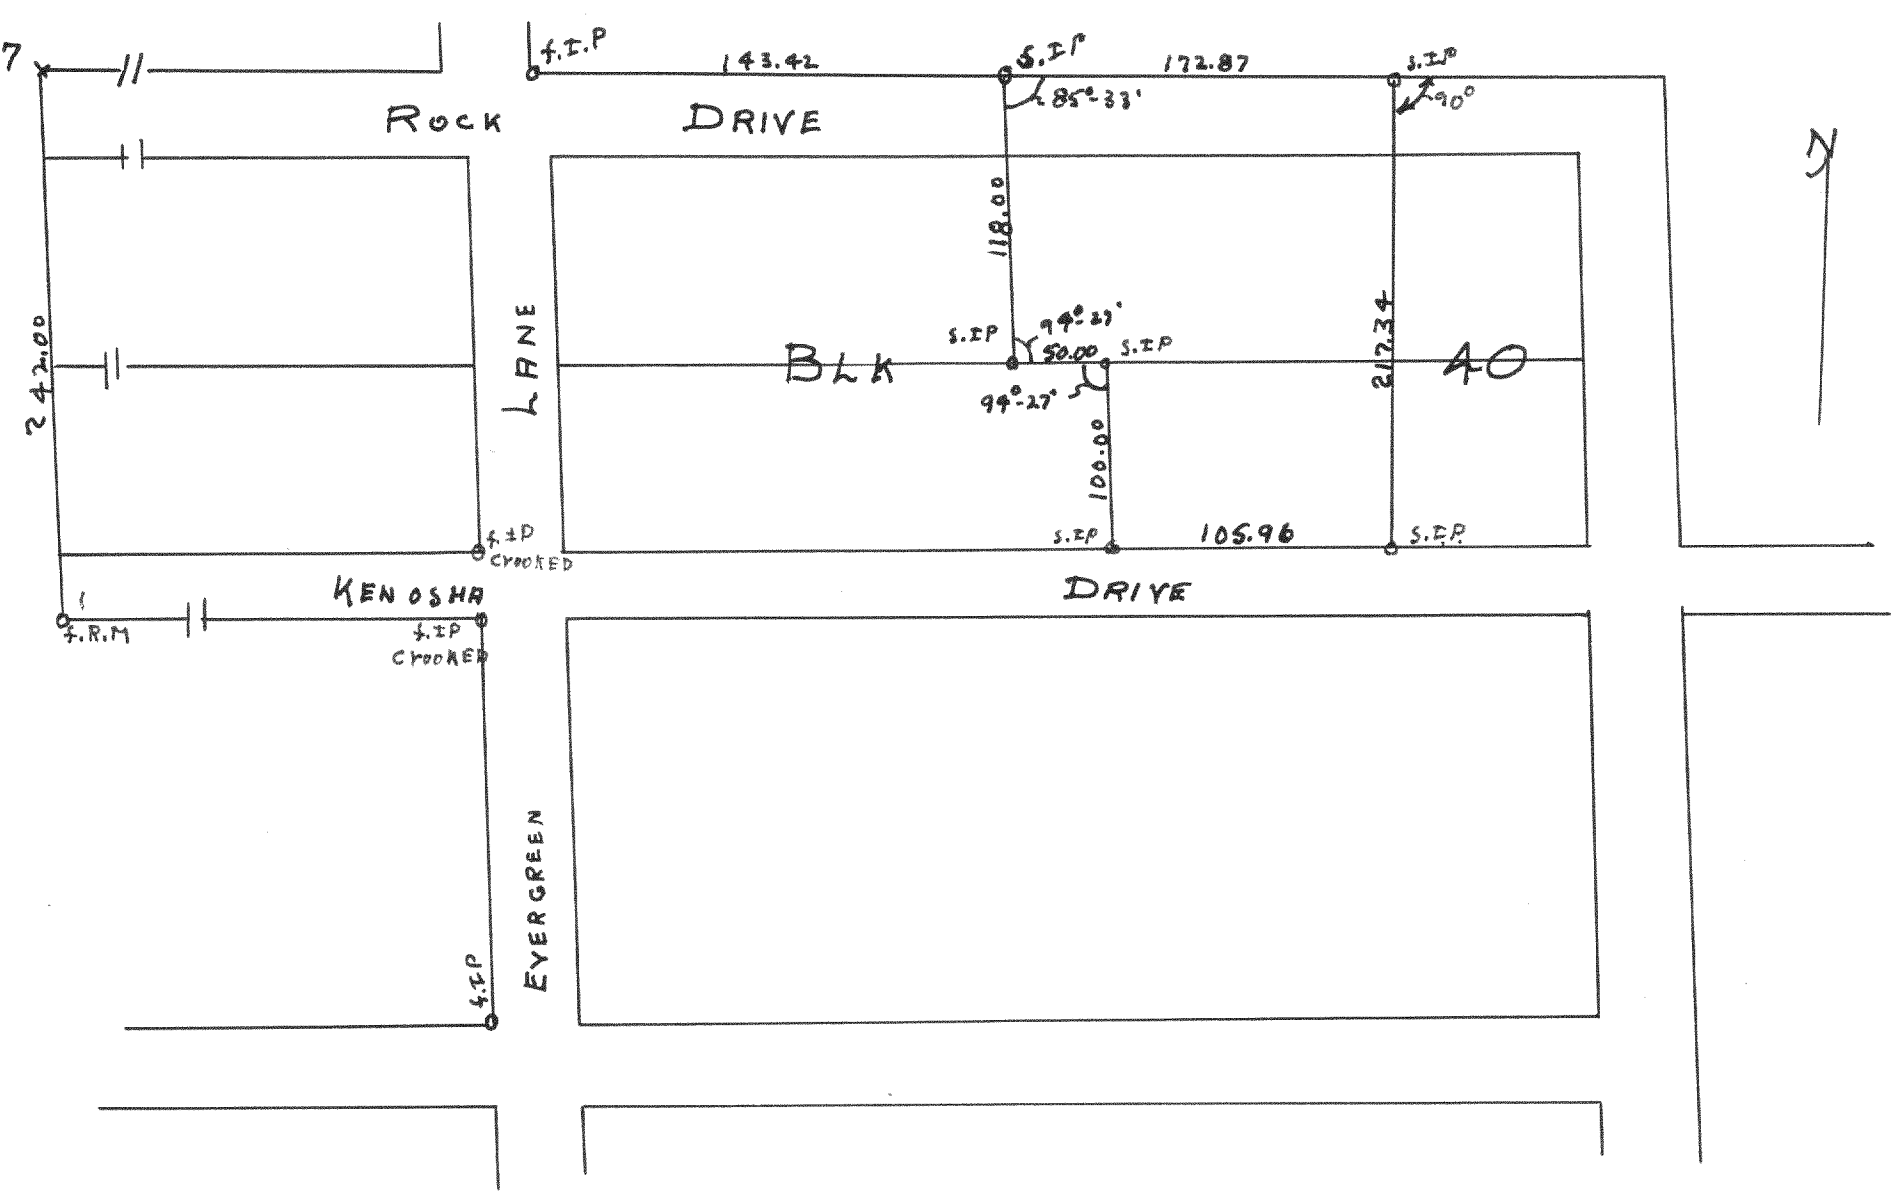

Plot of survey of part of Block 40 in Lake Mandawega subdivision, Walworth County, Wisconsin

Nov. 19, 1947

Lloyd L. Jensen
County Surveyor
1560