


#1768

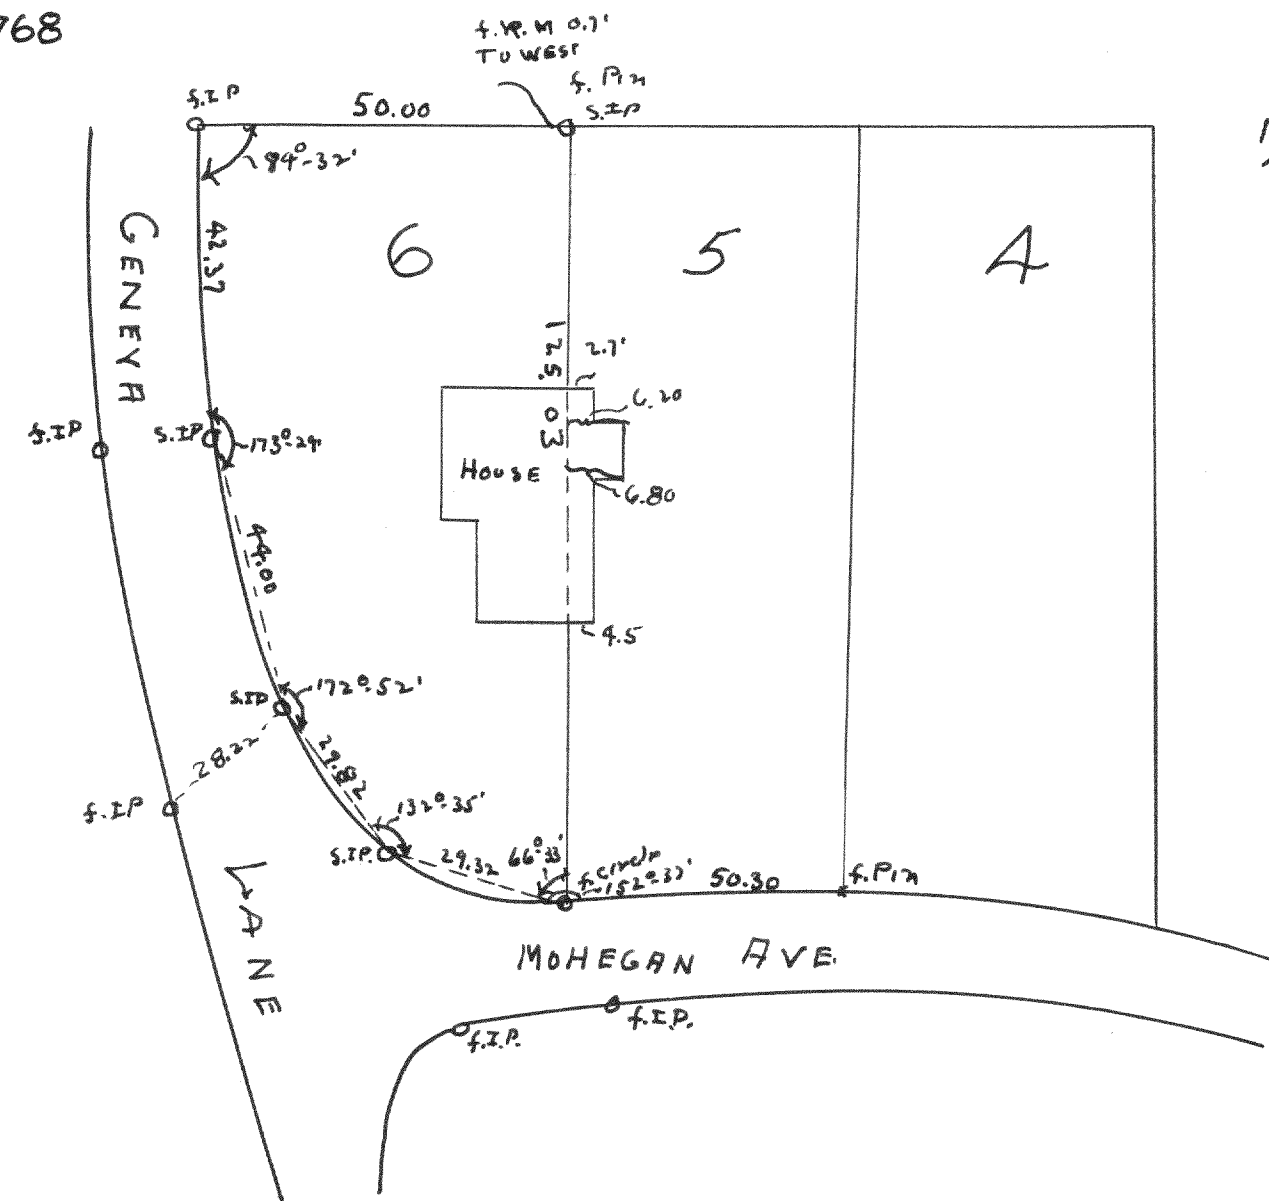


Plot of survey of lot 6 Block 2 Indian Hills
in town of Indian Hills, Walworth County, Wisconsin

Nov. 3, 1947

Lloyd L Jensen
County Surveyor
LJS

#1769

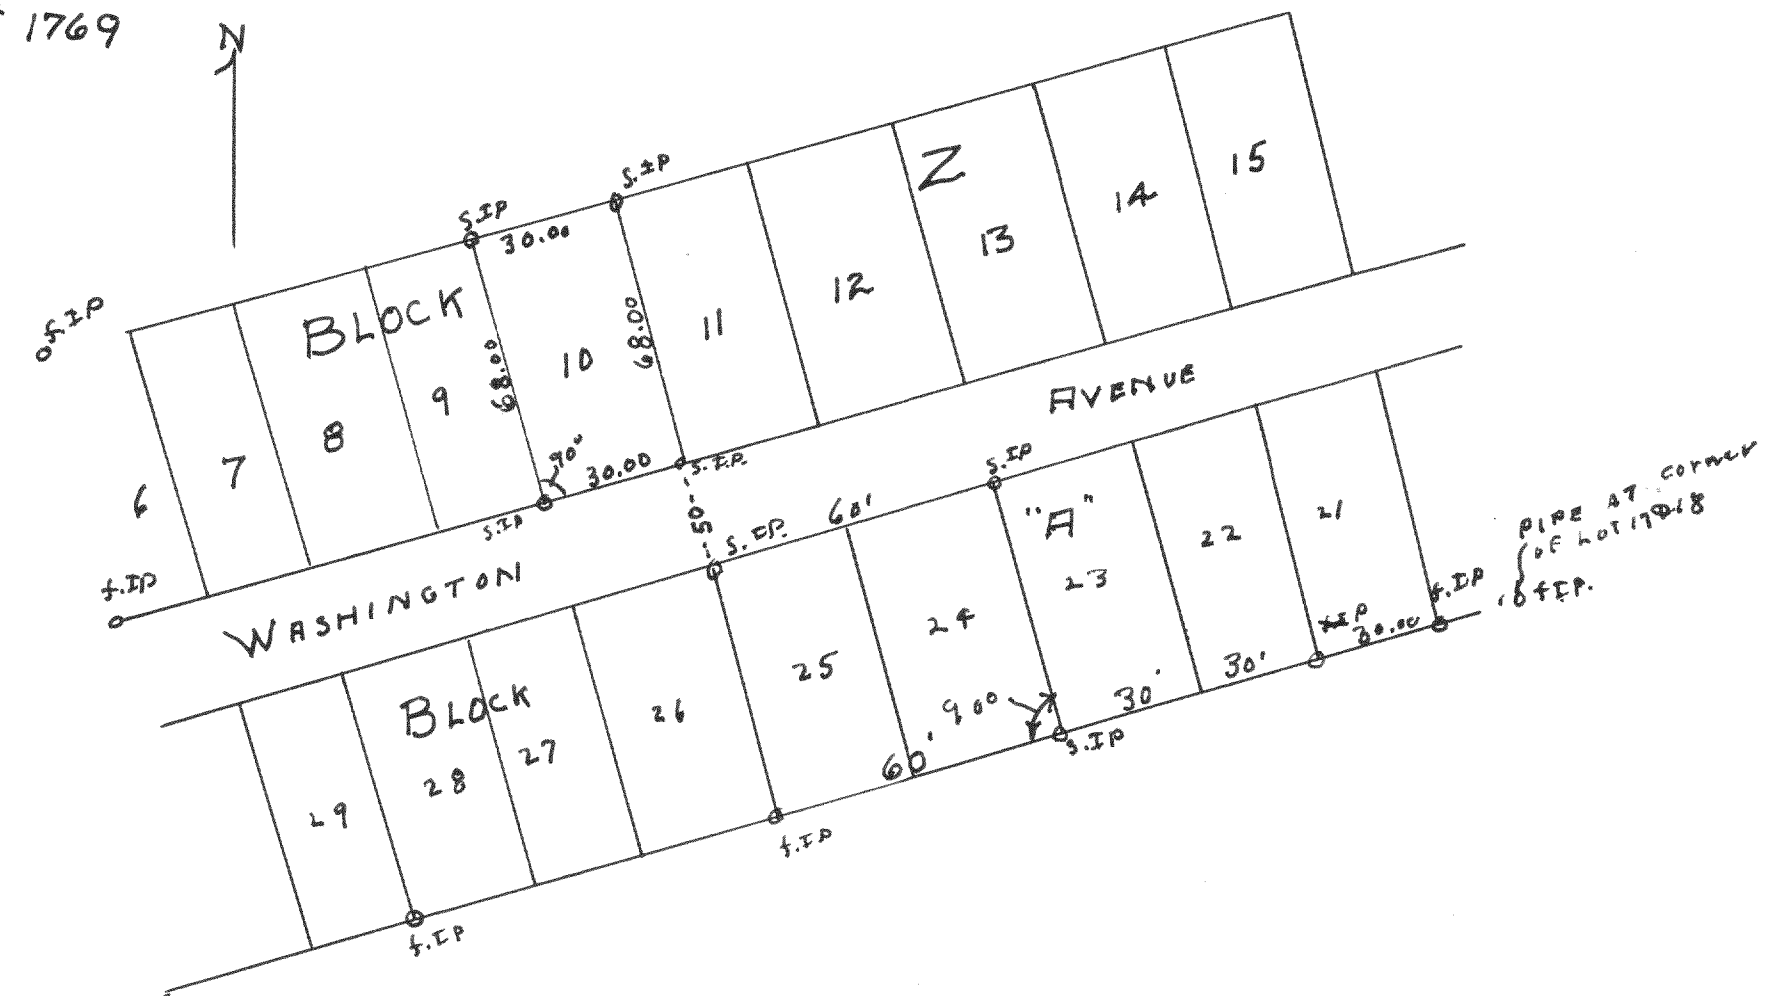

Plot of survey of lots 24 & 25 in Block A and lot 10 in Block Z
of Assembly Grounds at Delavan Lake, Walworth County, Wisconsin

Oct 8, 1947

Lloyd L Jensen
County Surveyor
LJS