



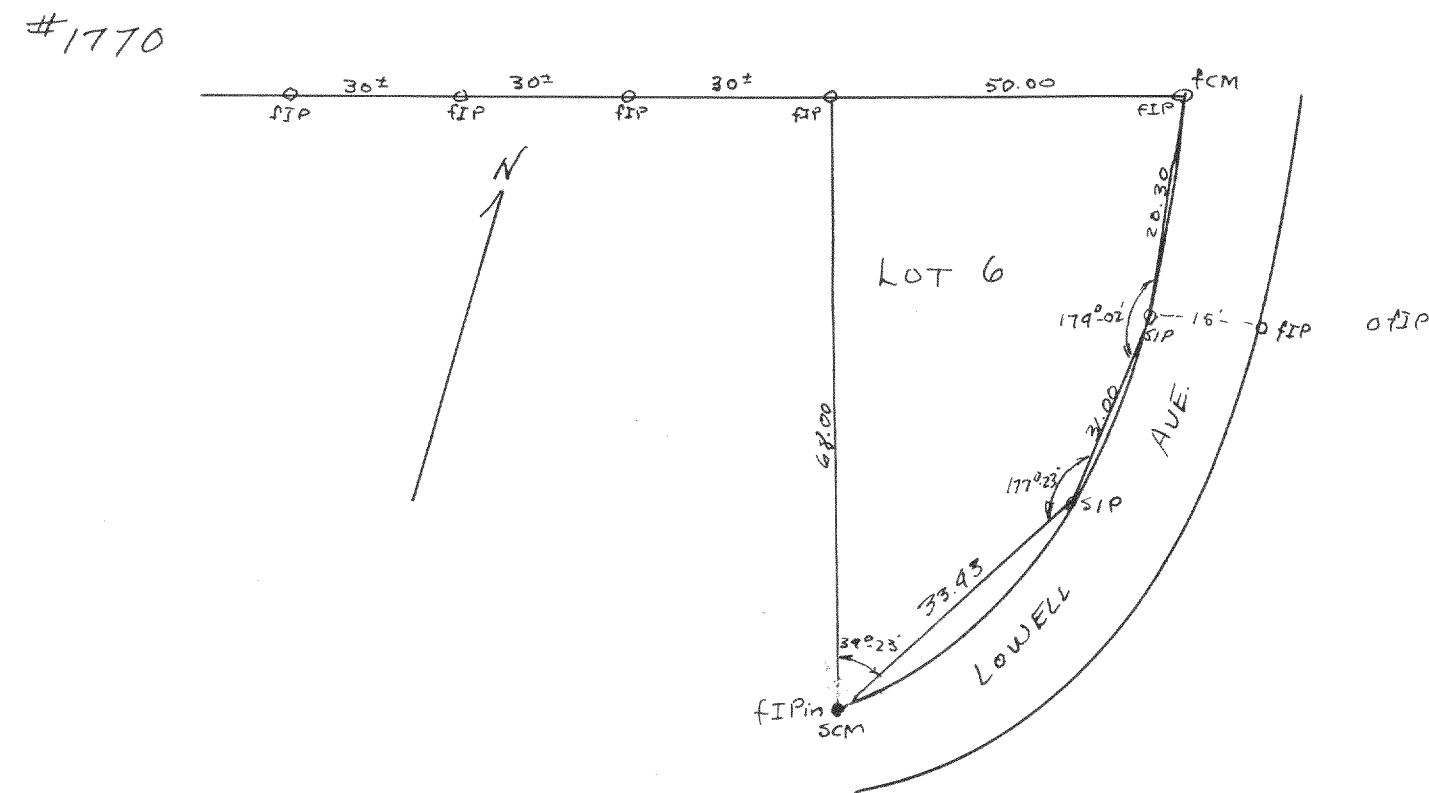

Plot of survey of Lot 6 Block R of Assembly grounds
Delavan Lake Walworth County Wisconsin

Oct 6, 1947

Floyd L Jensen
County Surveyor
1950

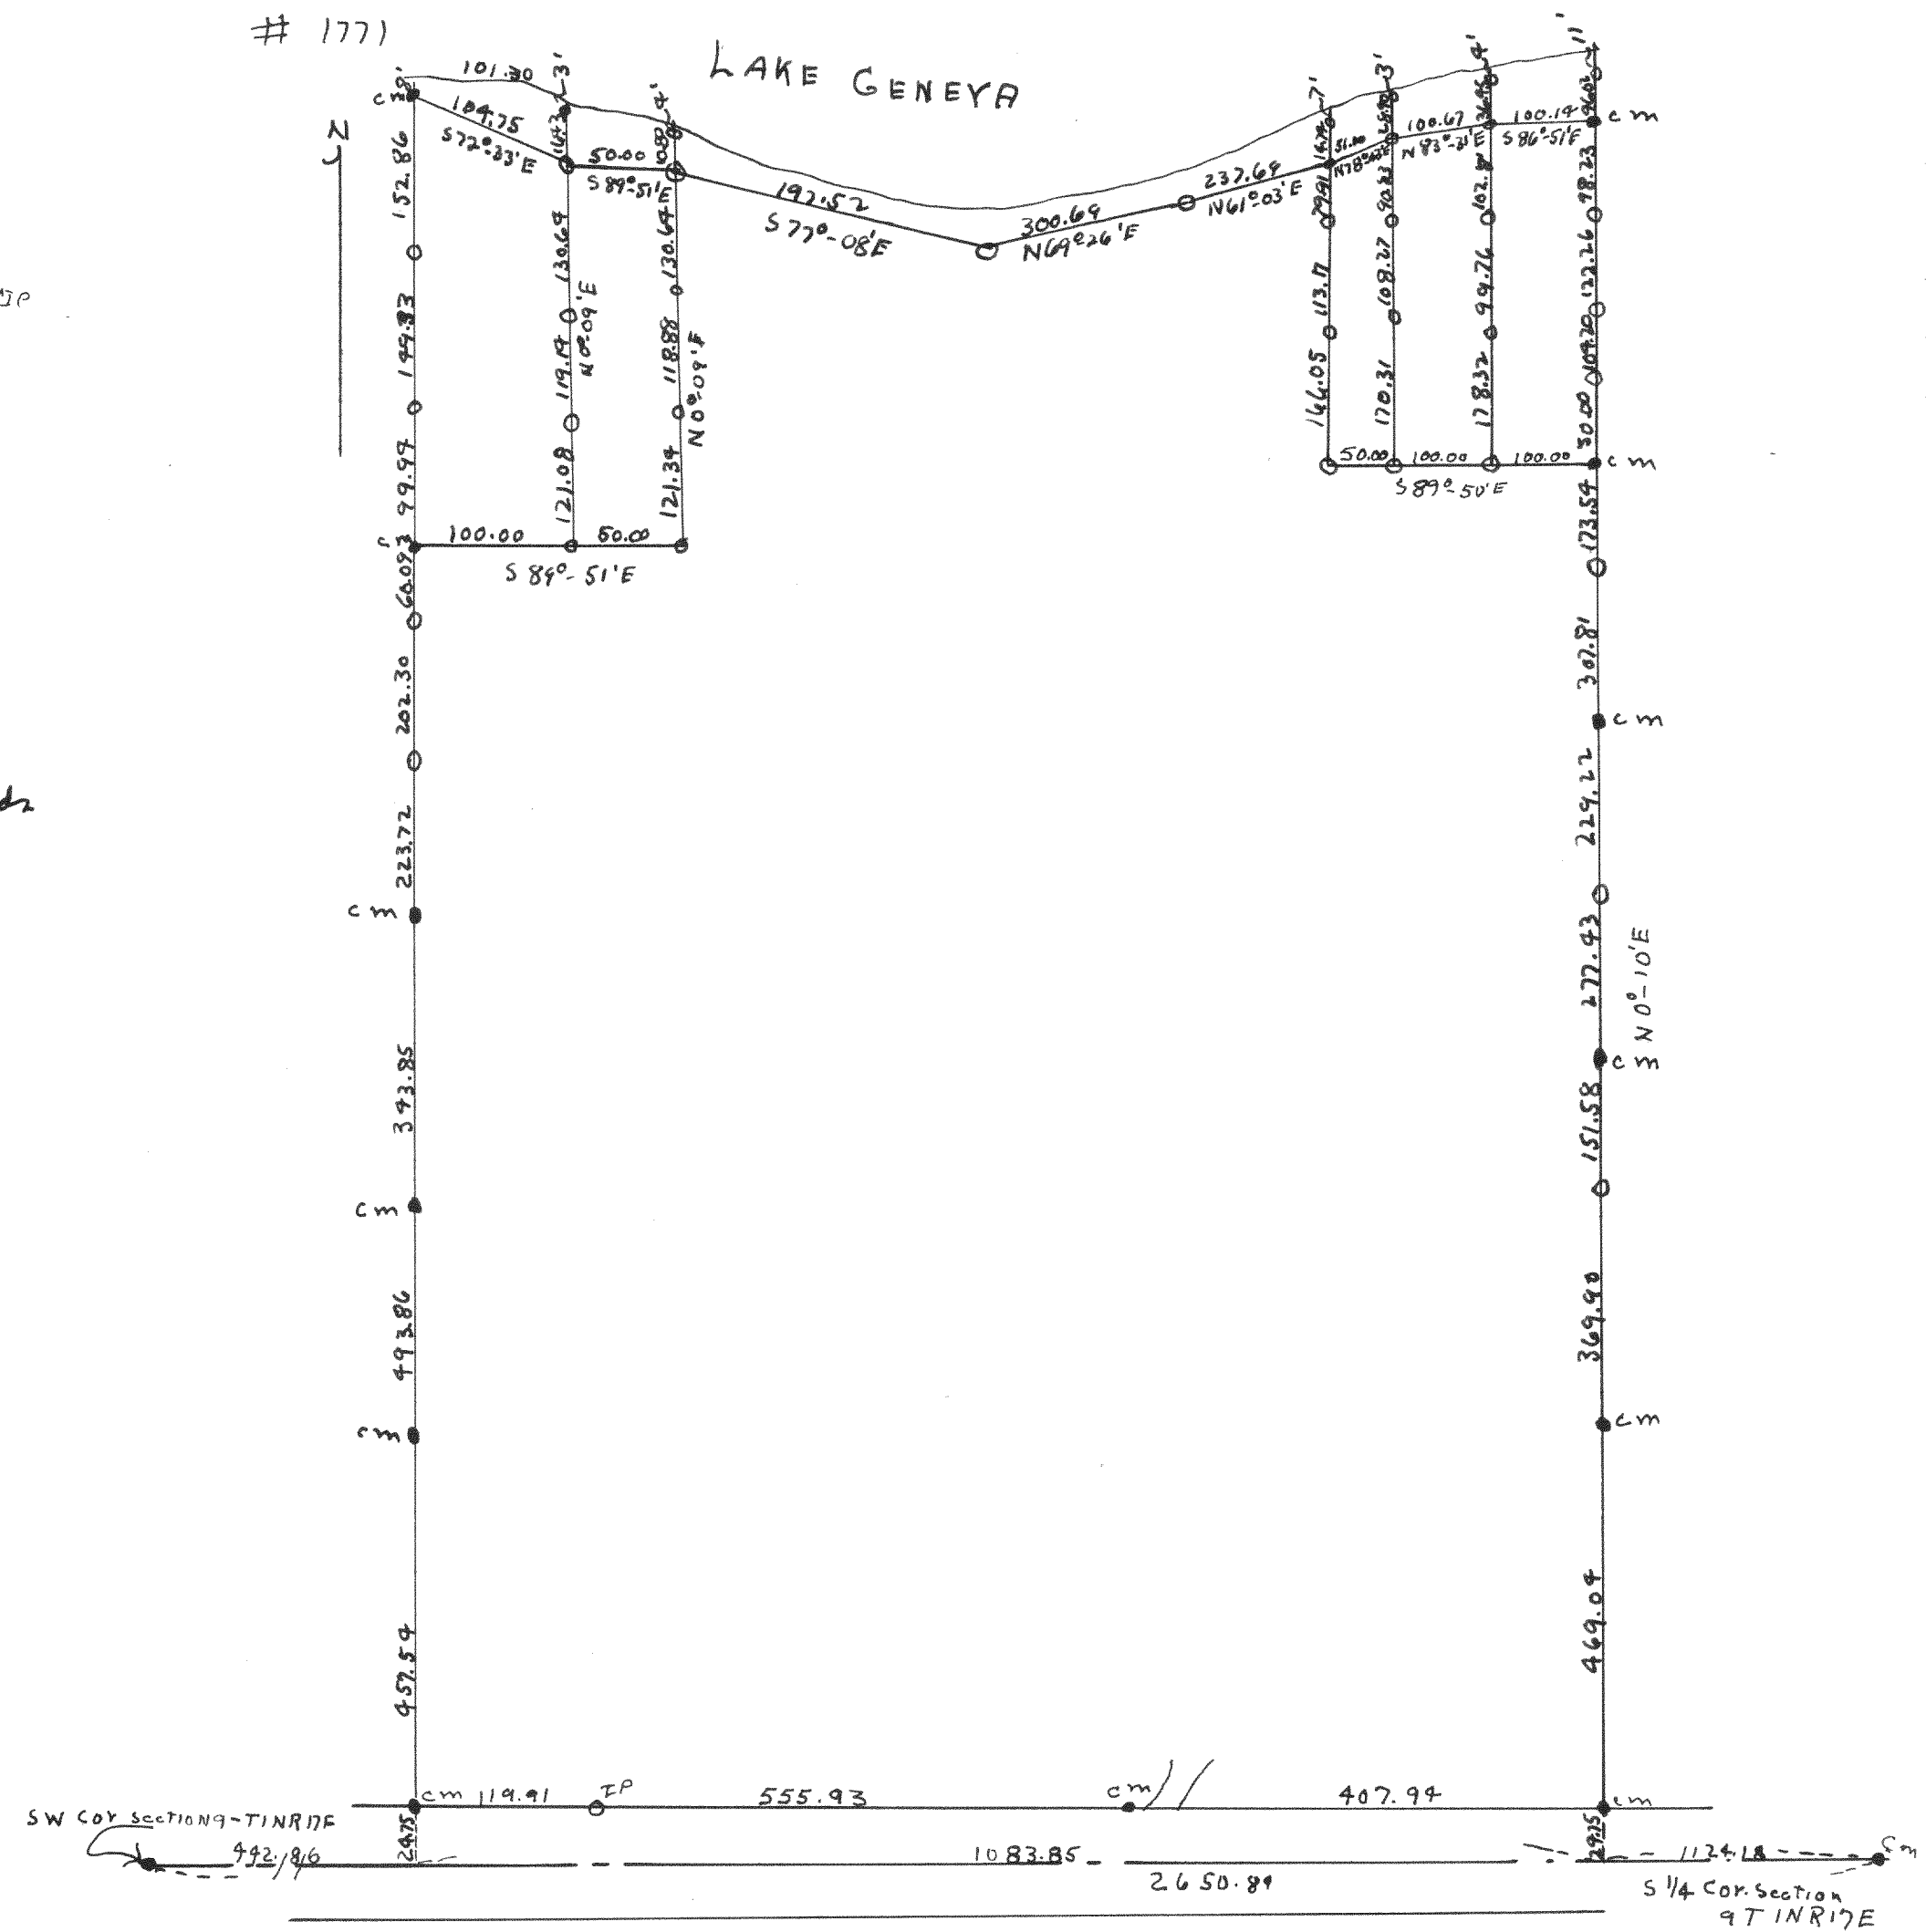

Plot of survey of Tiffin Estate located in Section 9, T1N R17E
of Mahoning County, Wisconsin
January 1948
Floyd I Jensen

Floyd I Jensen
County Surveyor
[Signature]