


#1781

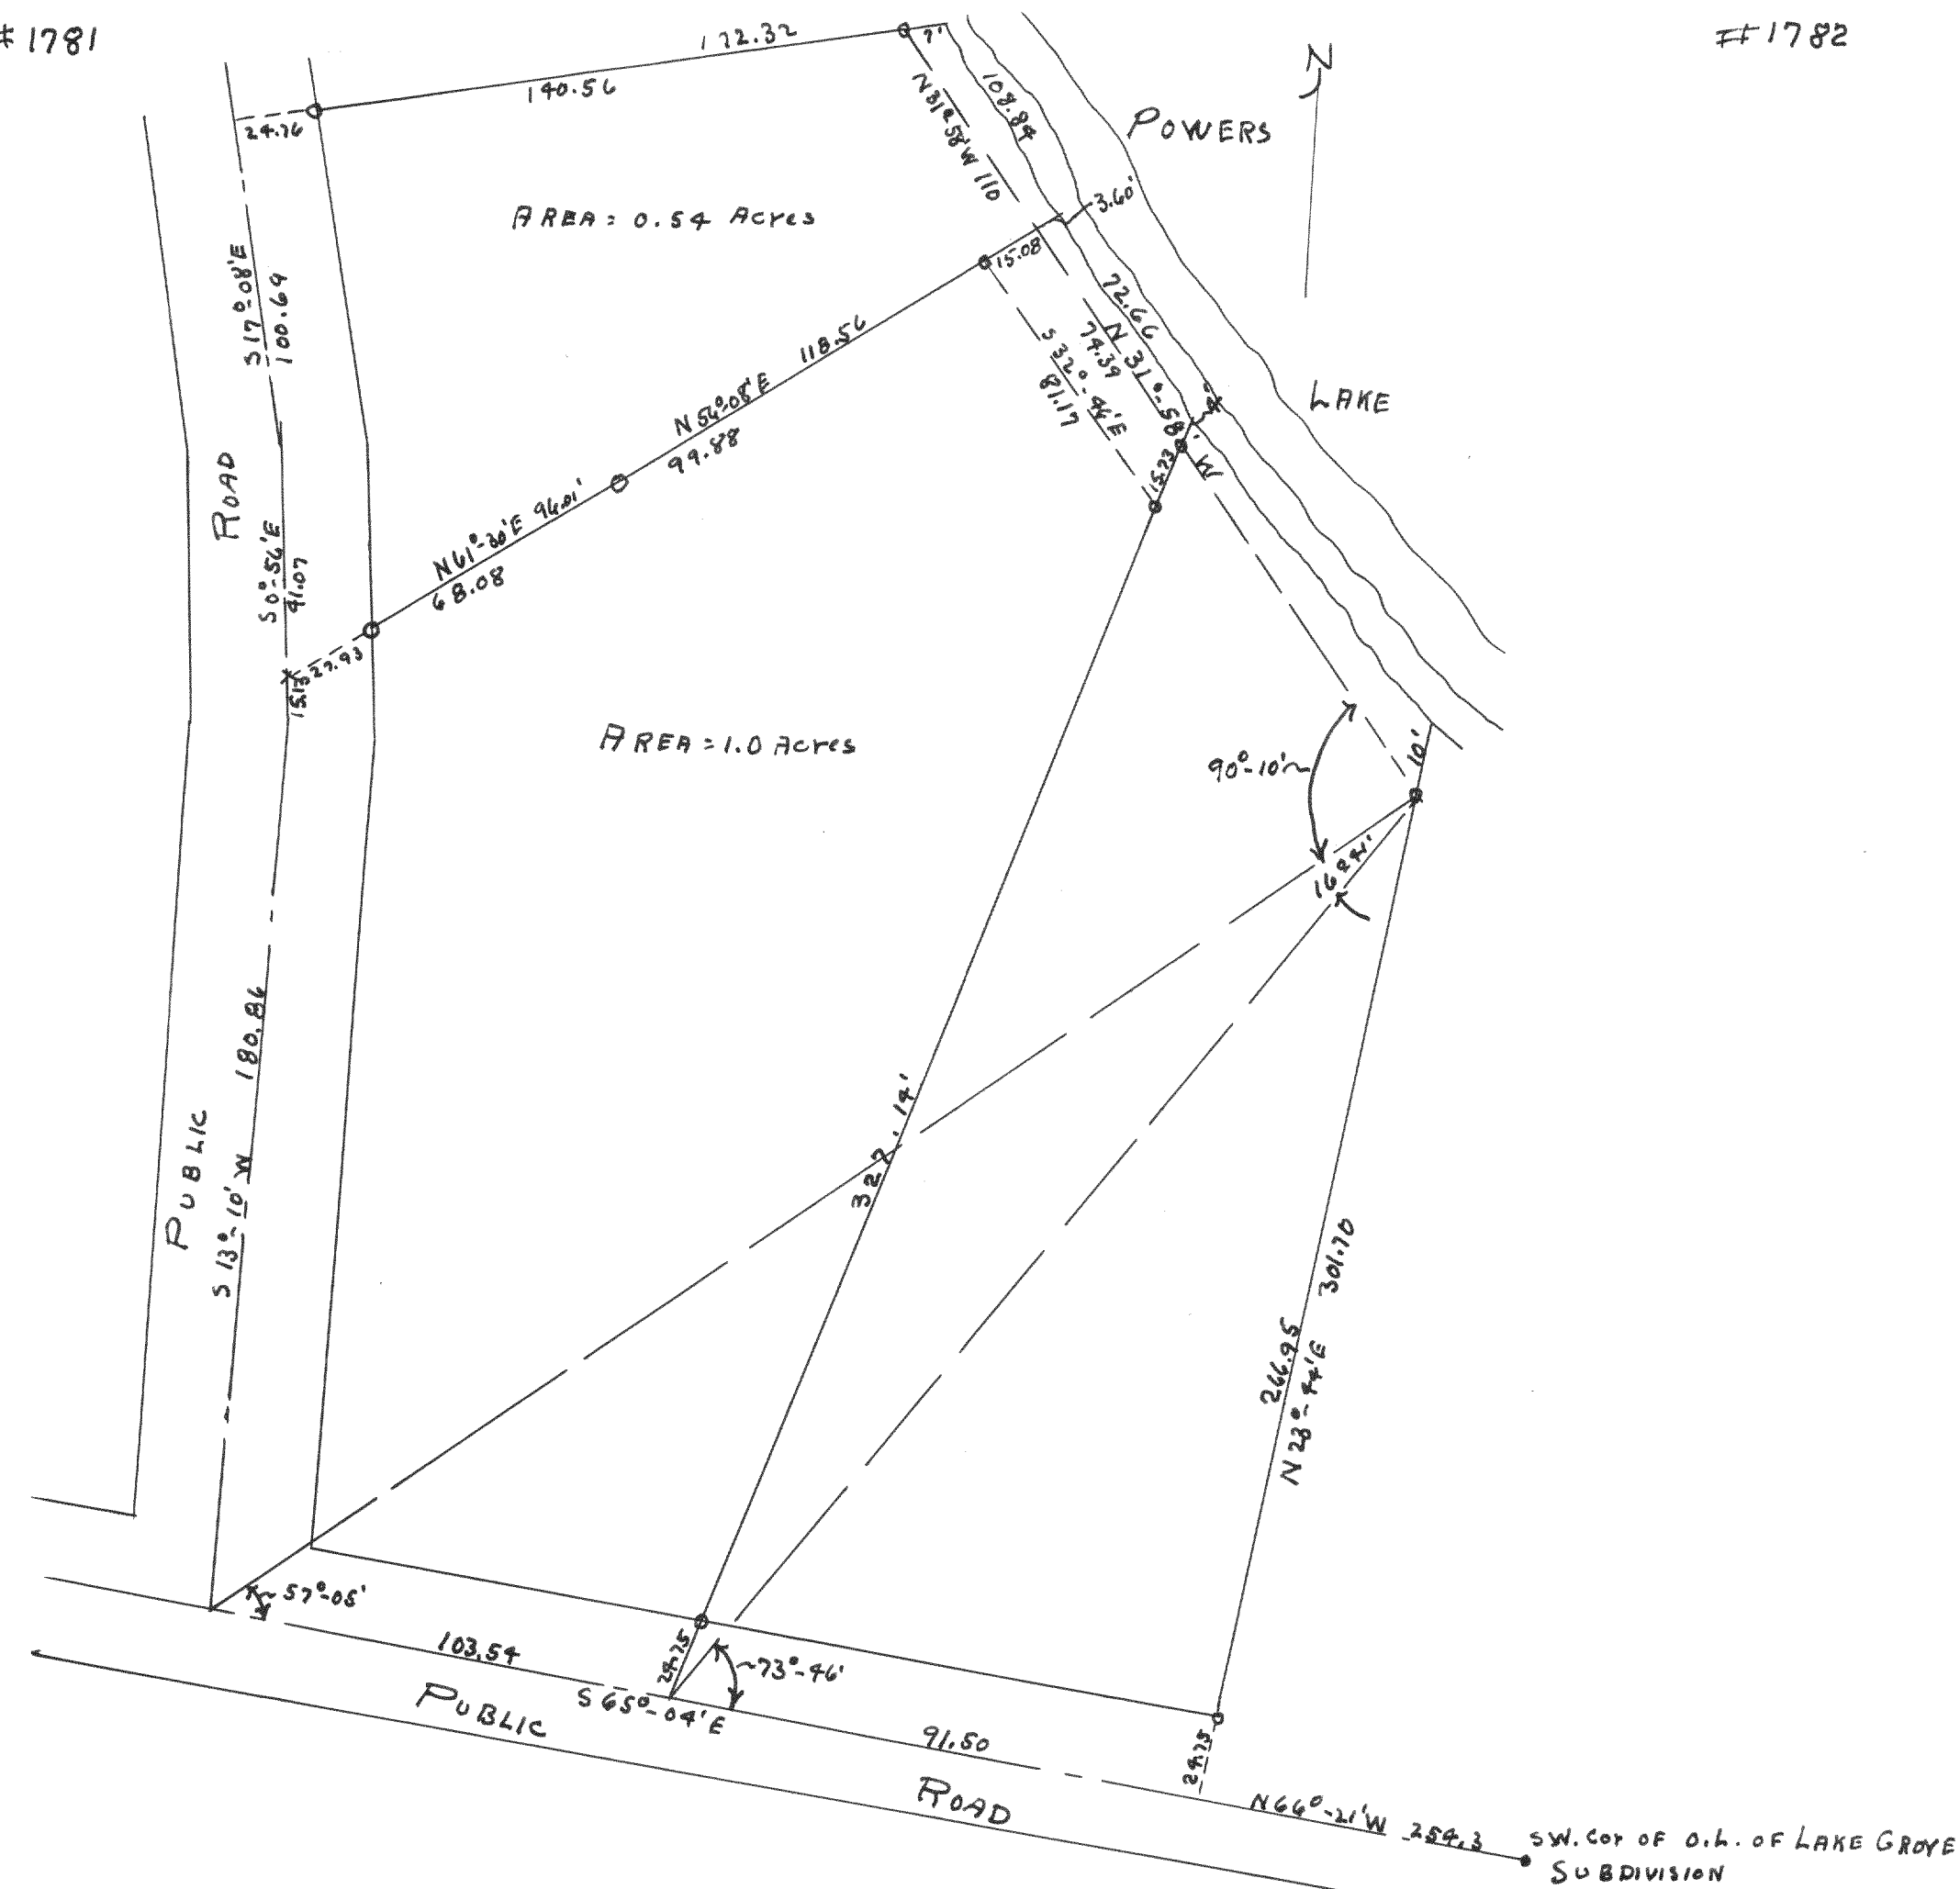


Plot of survey of a parcel of land located in the SE fractional 1/4 of Section 13-T1N-18E of Walworth County, Wisconsin

Apr. 1947

Floyd & Jensen
County Surveyor
etc

#1782

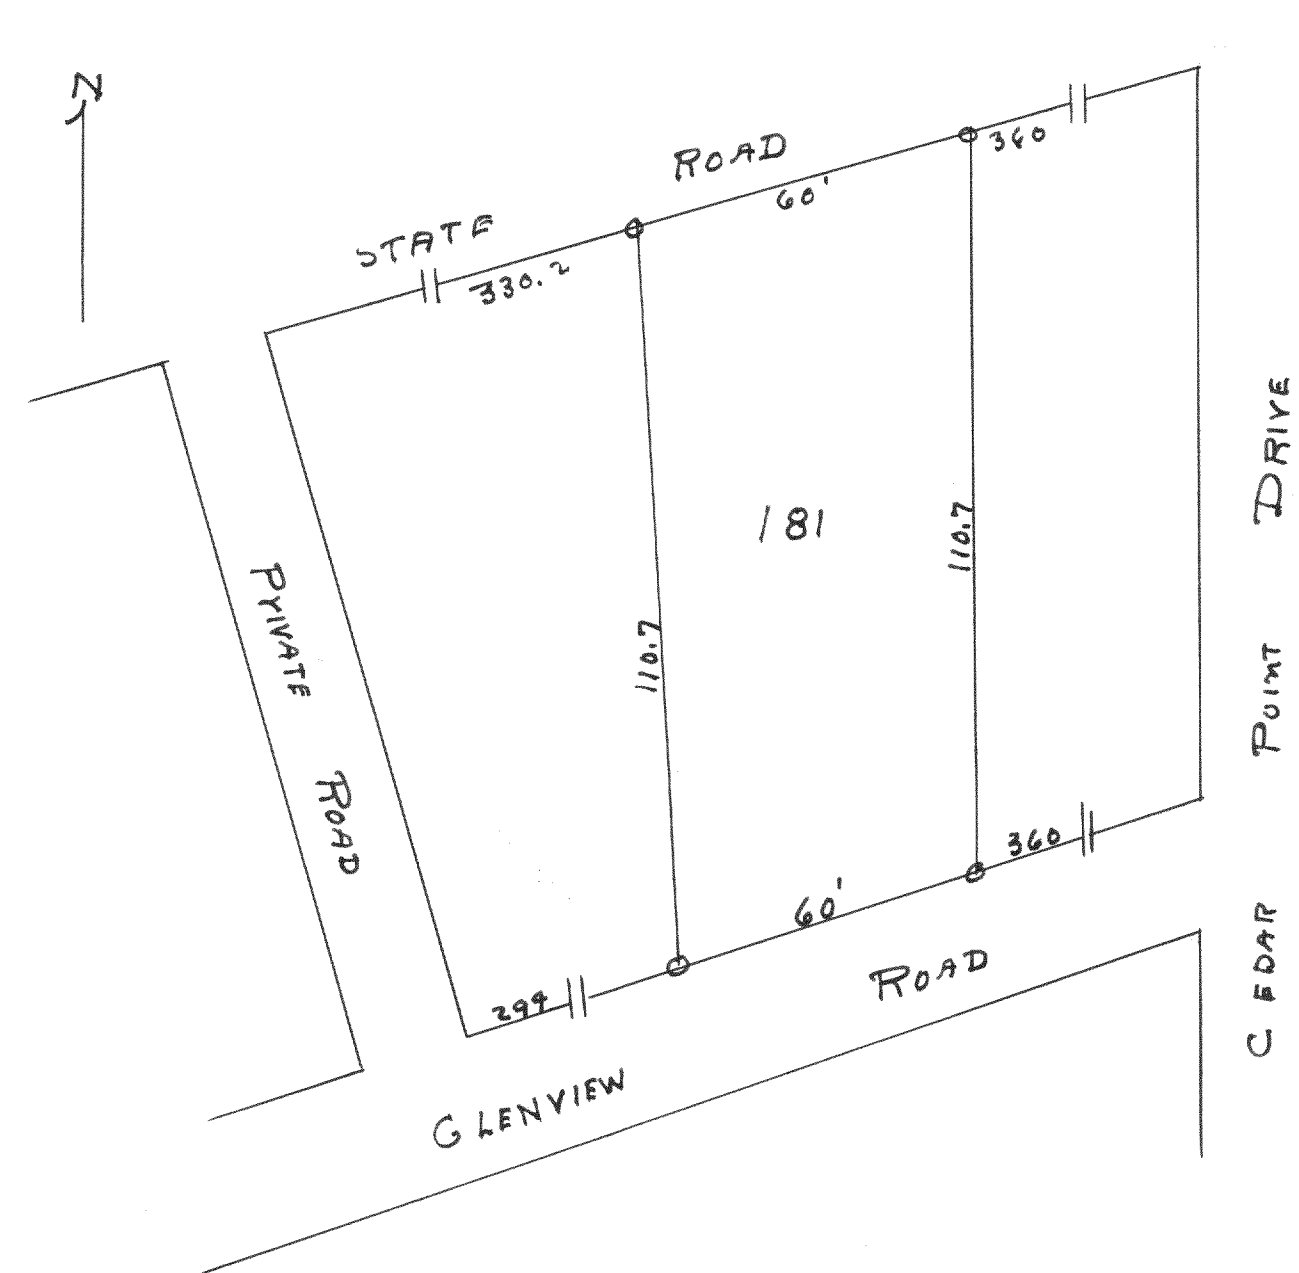

Plot of survey of lot 181 in 2nd addition to Cedar Point Park subdivision, Village of Williams Bay, Walworth County, Wisconsin

April 5, 1947

Floyd & Jensen
County Surveyor
etc