


#1787

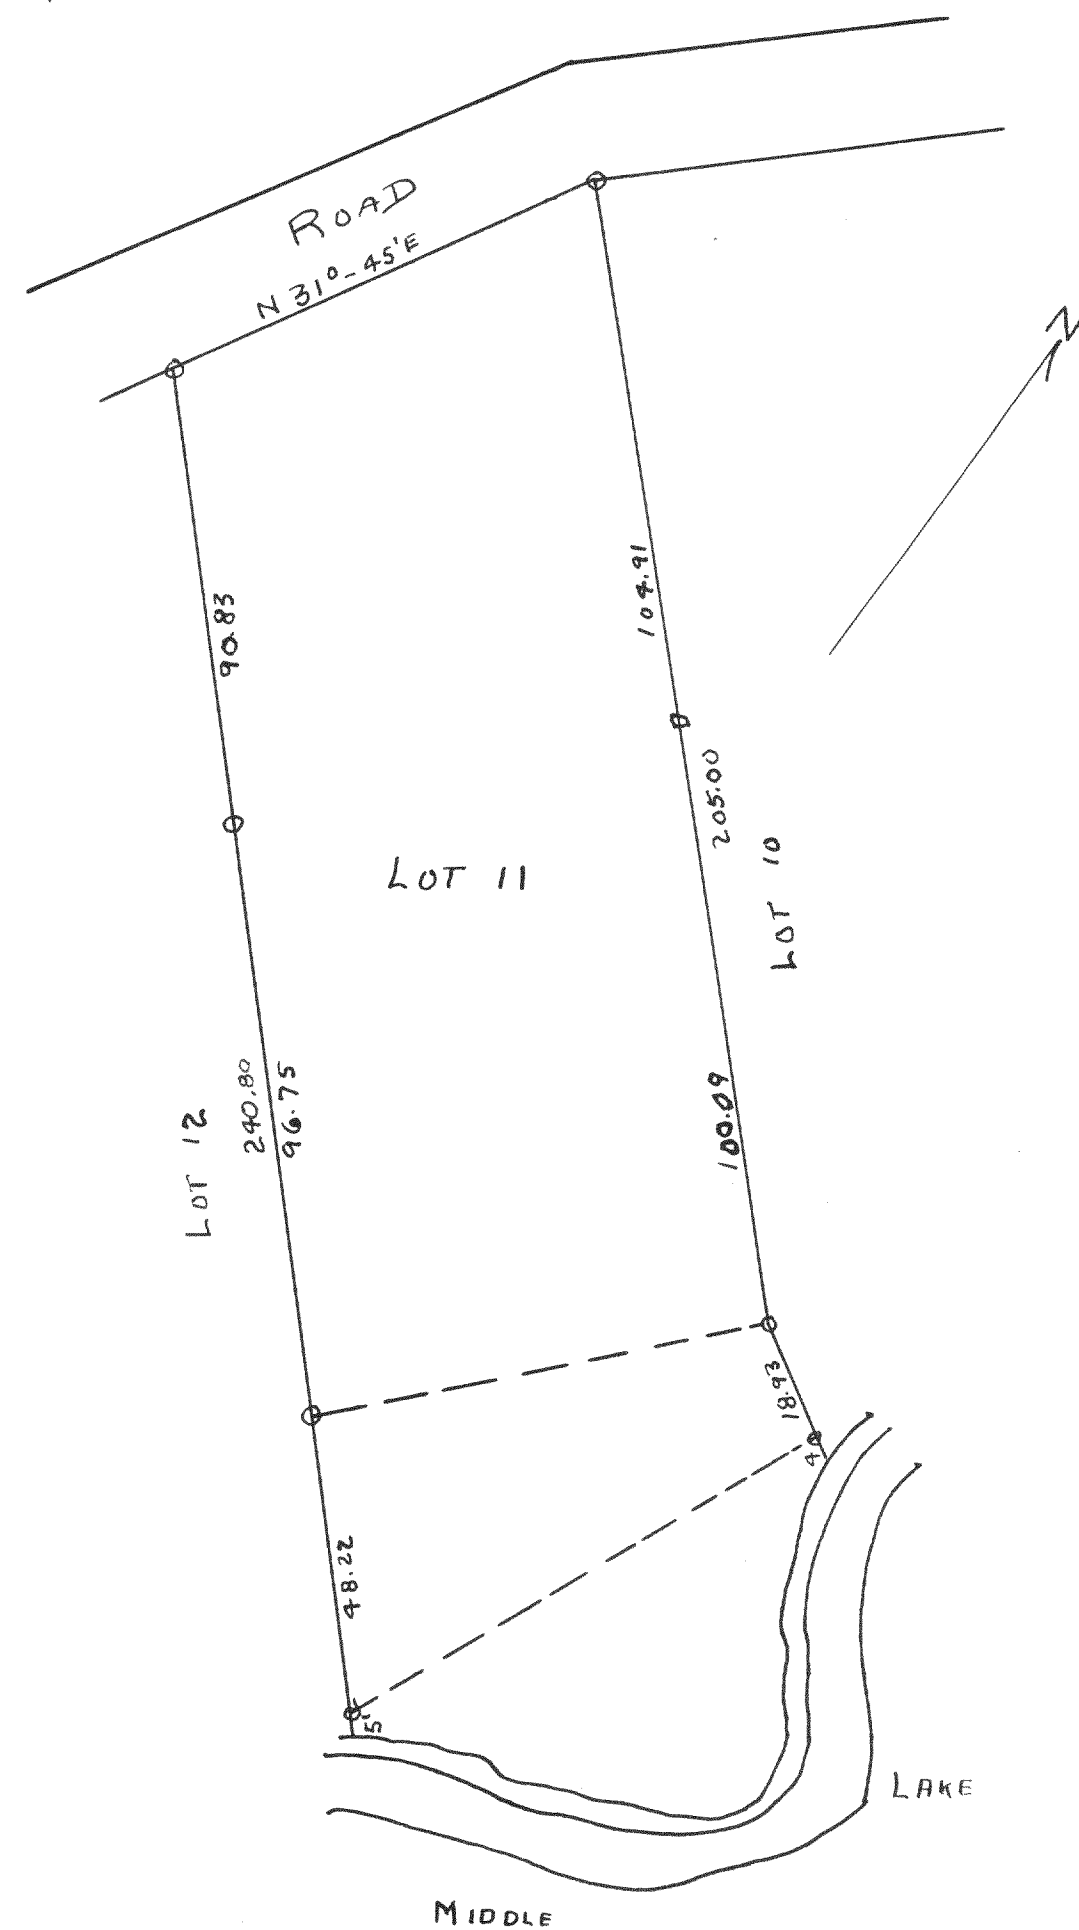


Plot of survey of Lot 11 of Oak Park Subdivision  
located in Section 26 T4N R16E of Walworth County  
Wisconsin

1946

Lloyd E Jensen  
County Surveyor  
*[Signature]*

#1788

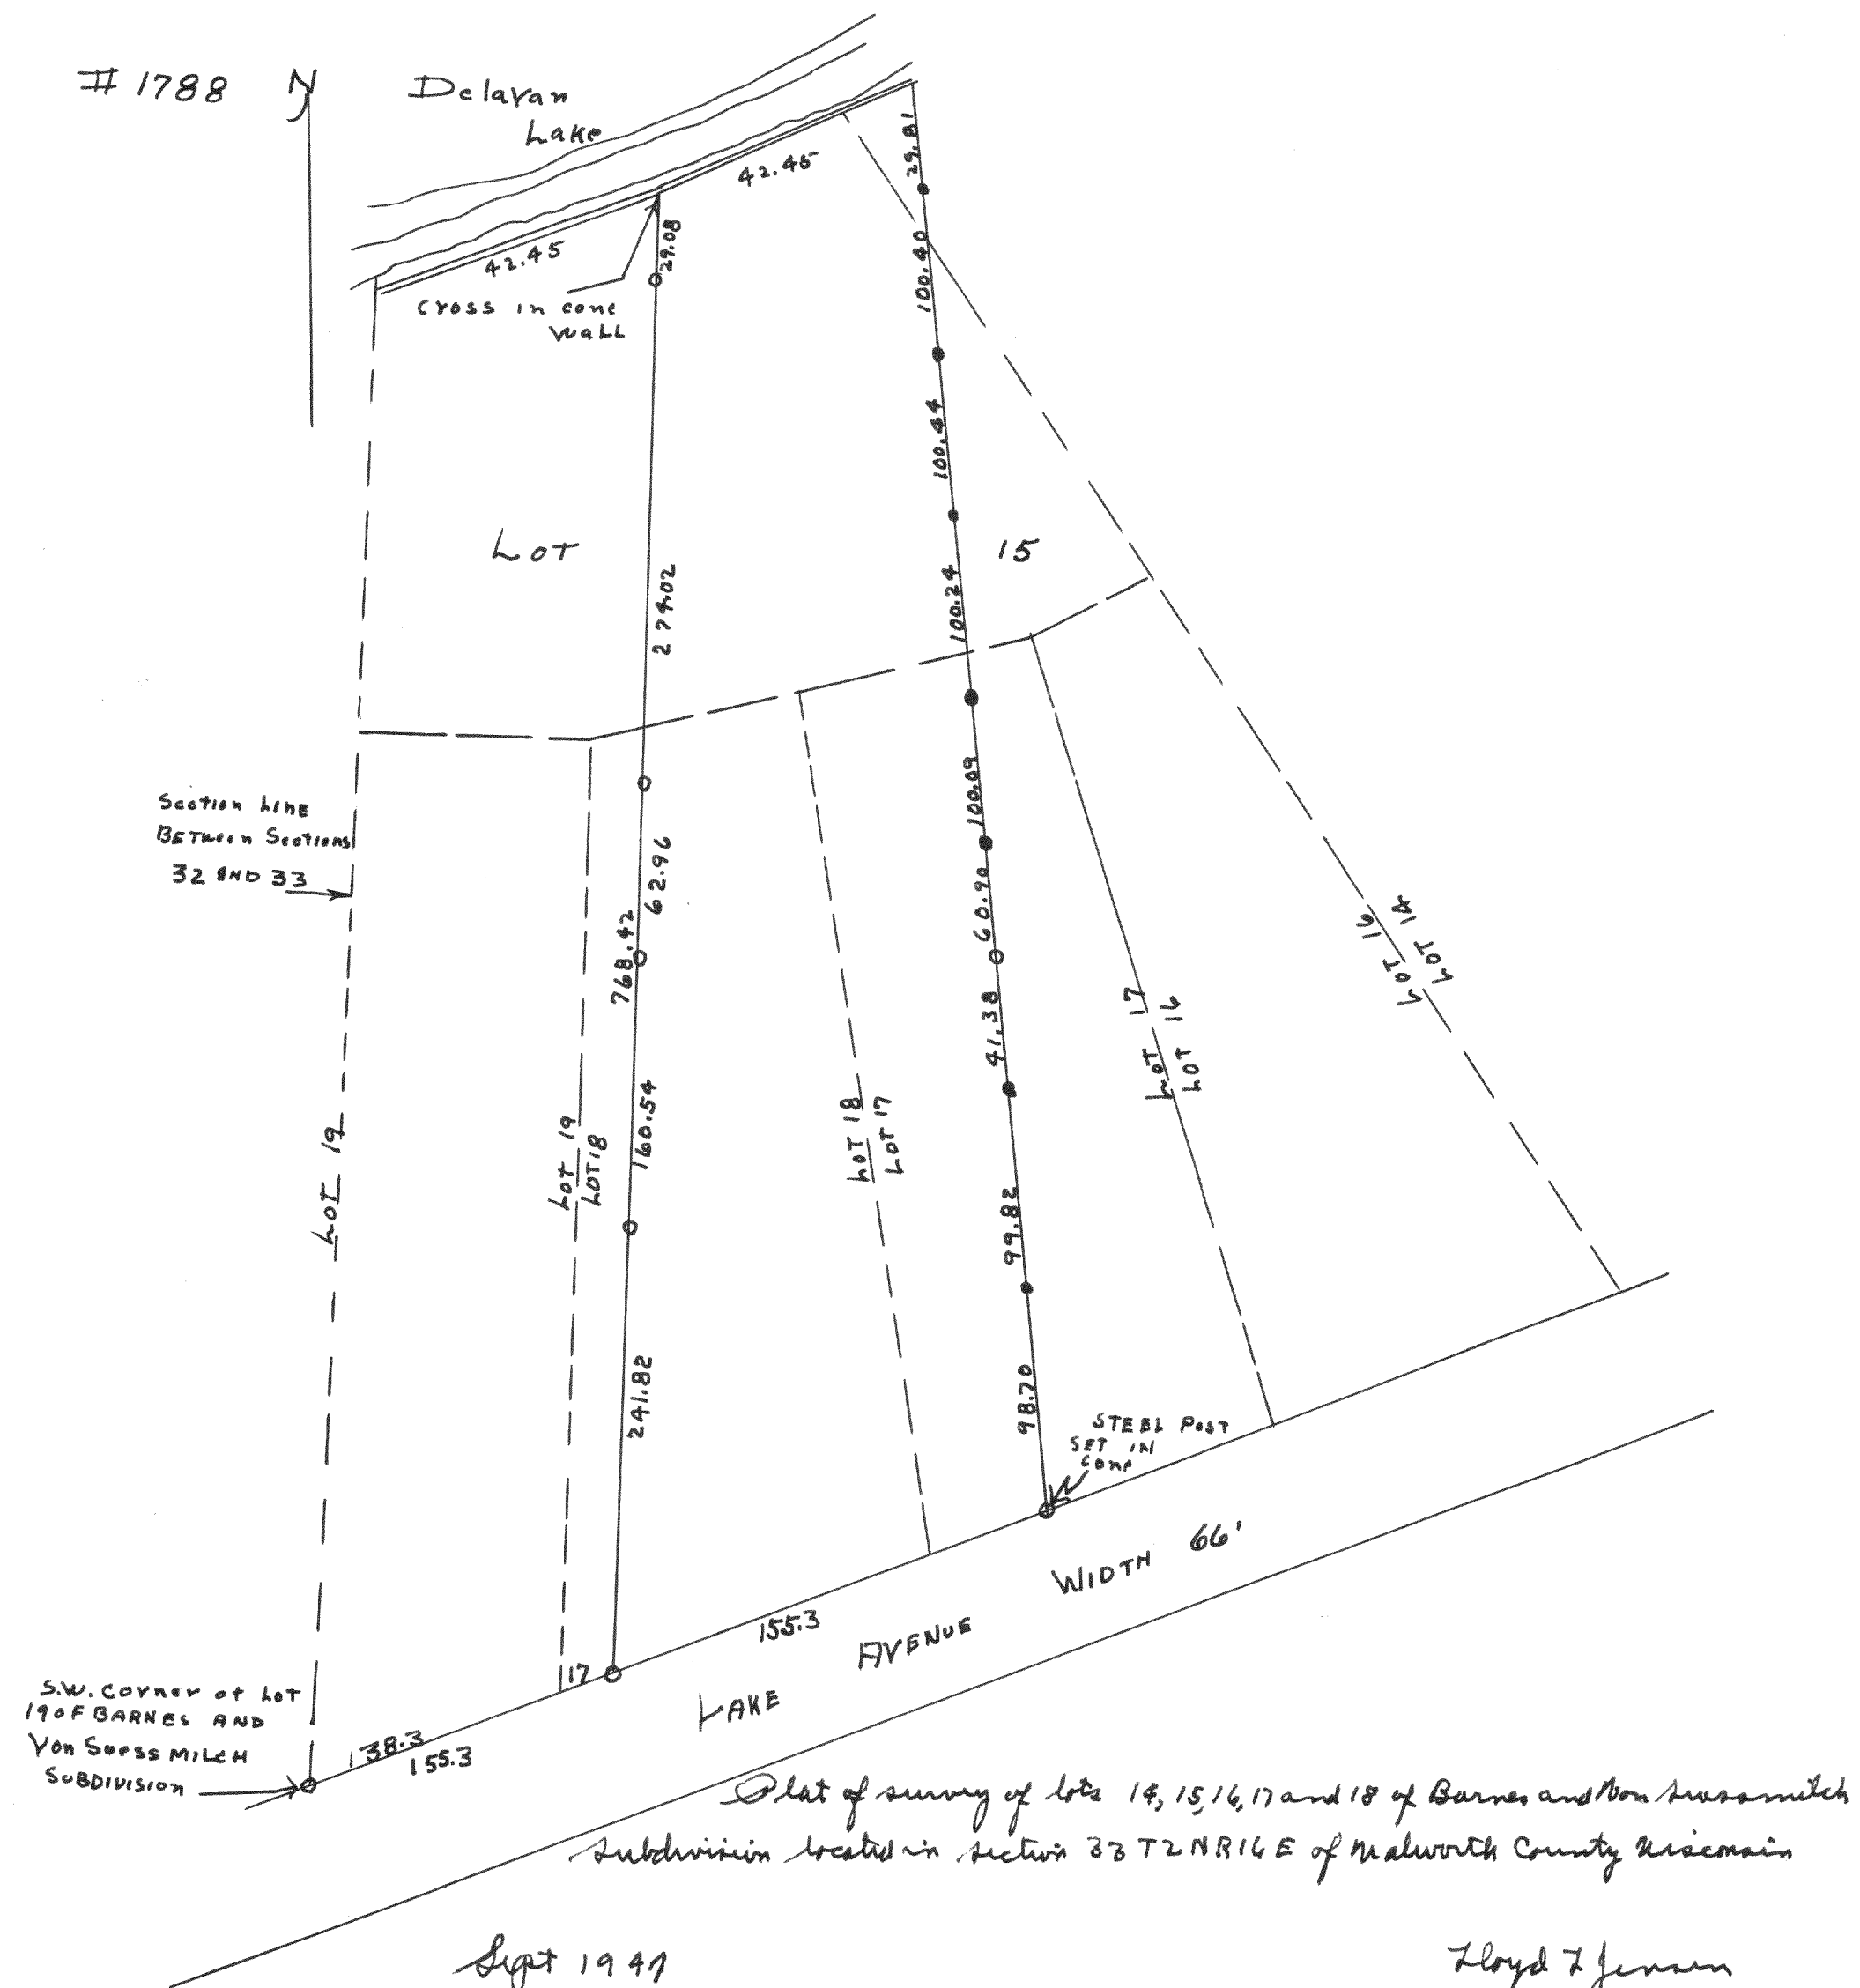

S.W. corner of Lot  
19 of Barnes and  
Von Sussmitch  
Subdivision

Plot of survey of lots 14, 15, 16, 17 and 18 of Barnes and Von Sussmitch  
Subdivision located in Section 33 T2N R16E of Walworth County Wisconsin

Sept 1947

Lloyd E Jensen  
County Surveyor  
*[Signature]*