



#1801

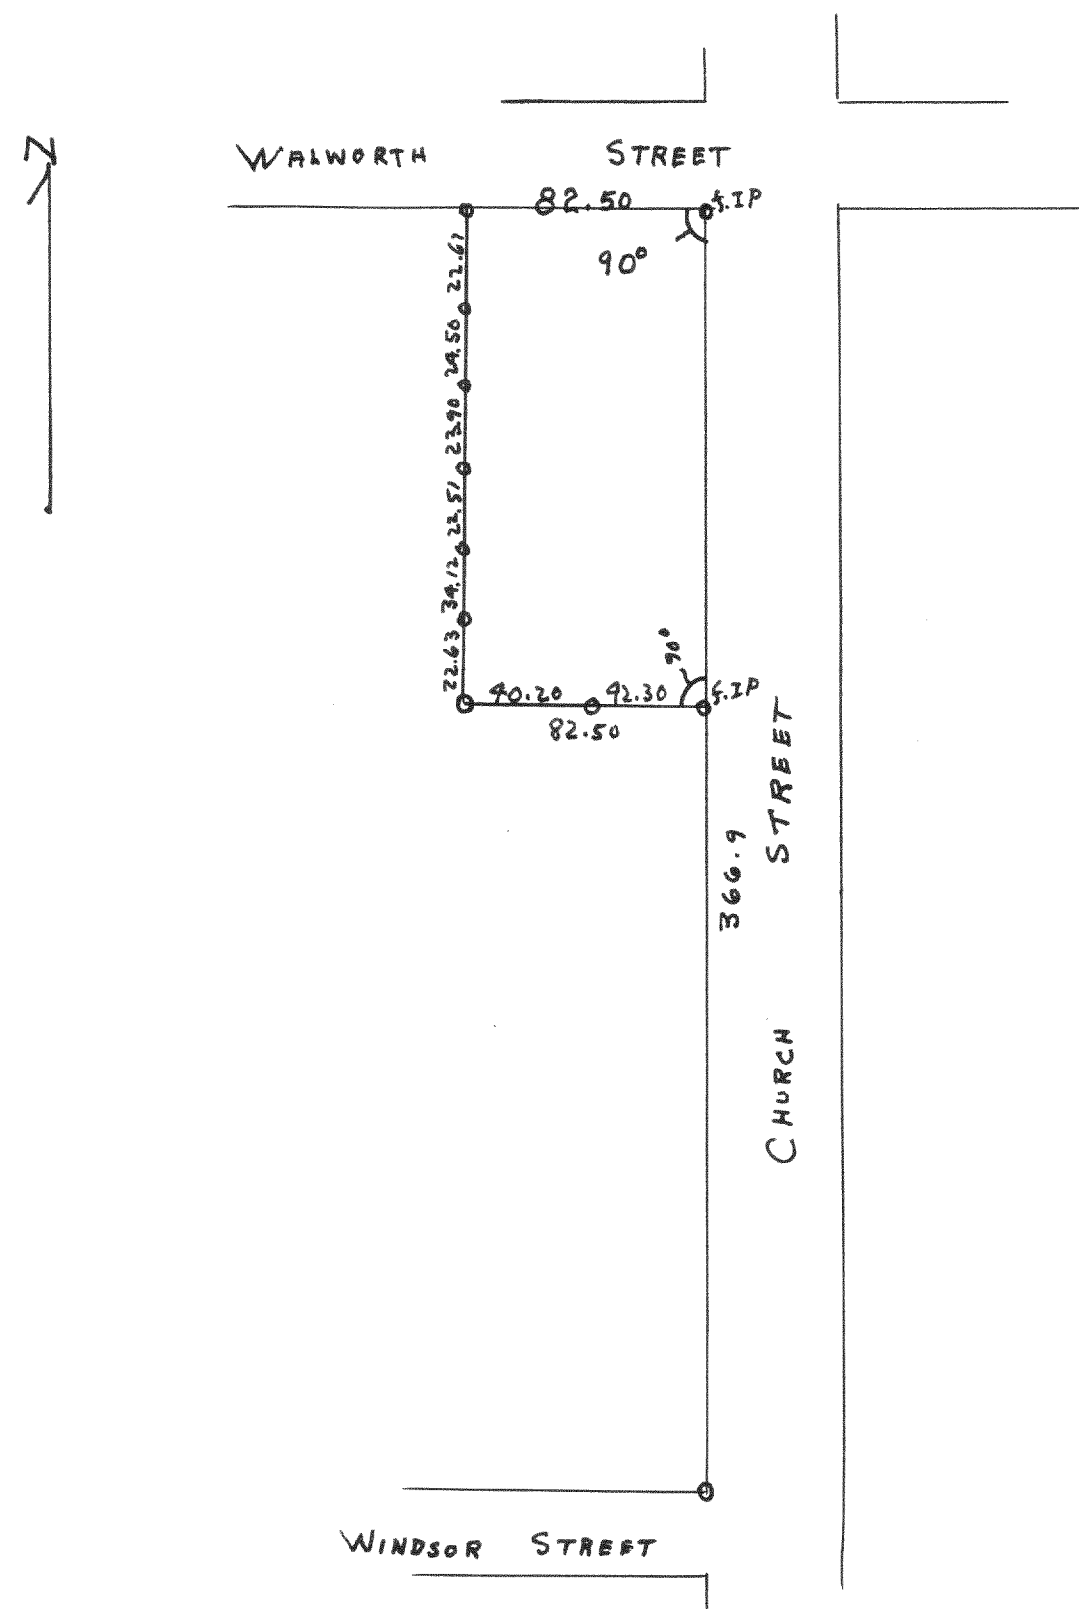

Plot of survey of the Demer Property located in
the City of Ekron, Walworth County Wisconsin
1947
Lloyd S Jensen
County Surveyor
LSD

#1802

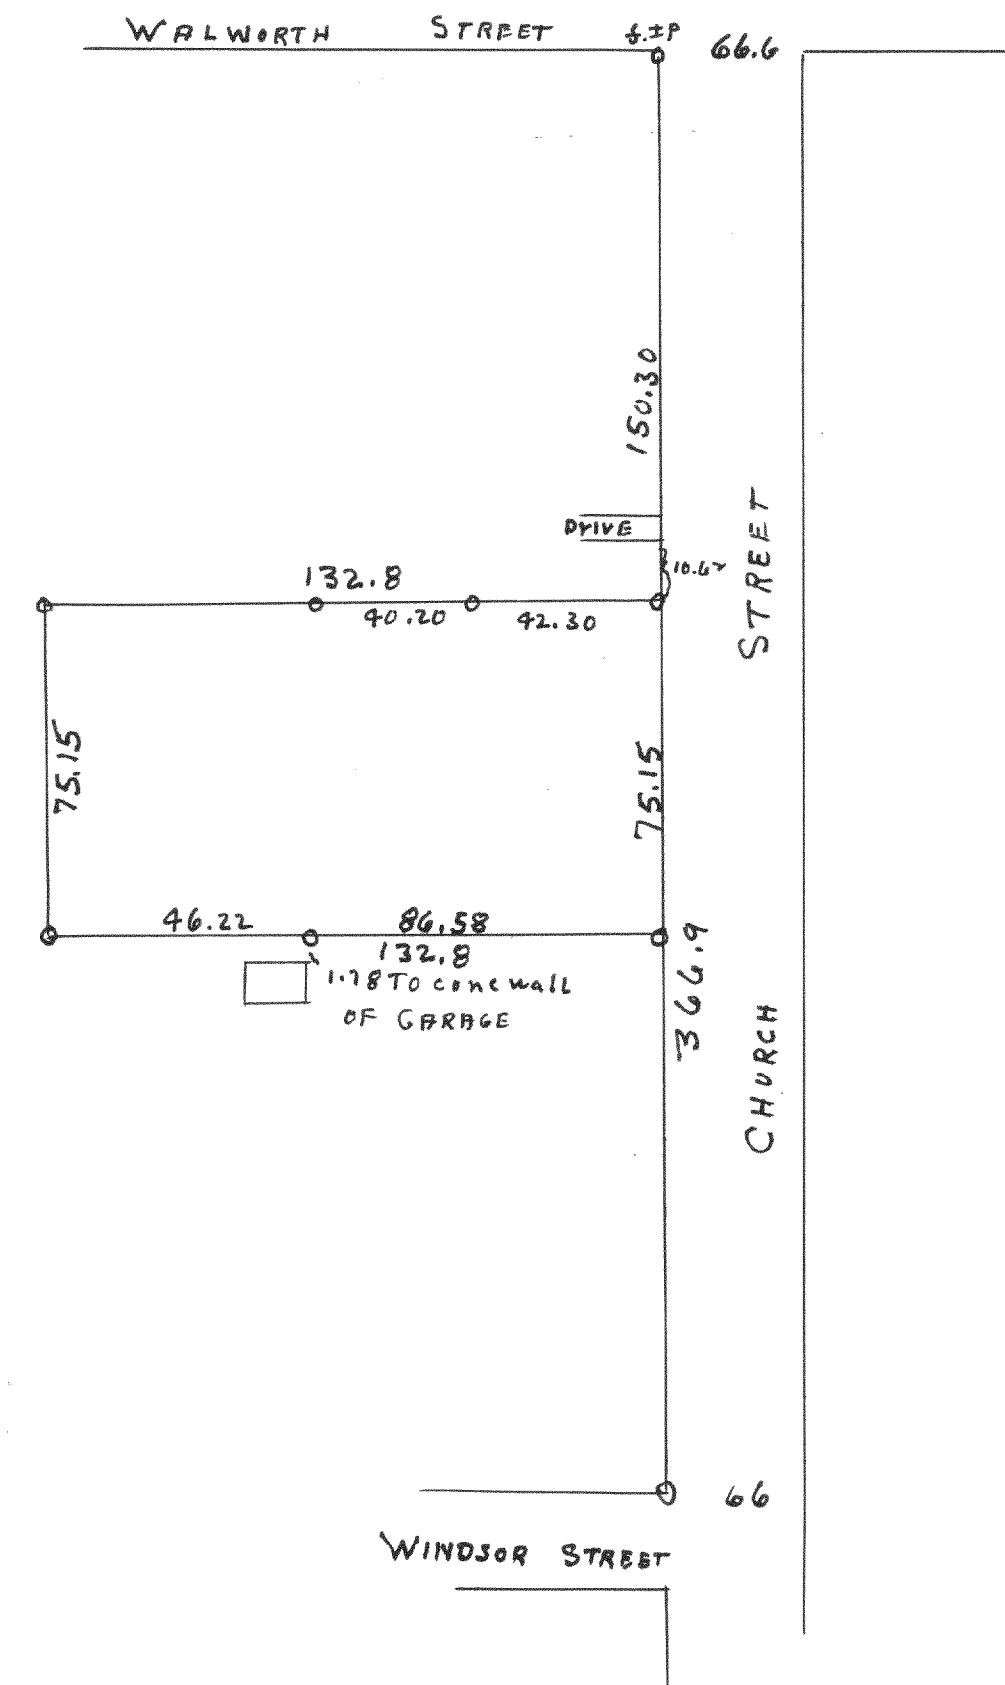

Plot of survey of Belmer property located in the City
of Ekron, Walworth County, Wisconsin
1947
Lloyd S Jensen
County Surveyor
LSD