


#1803

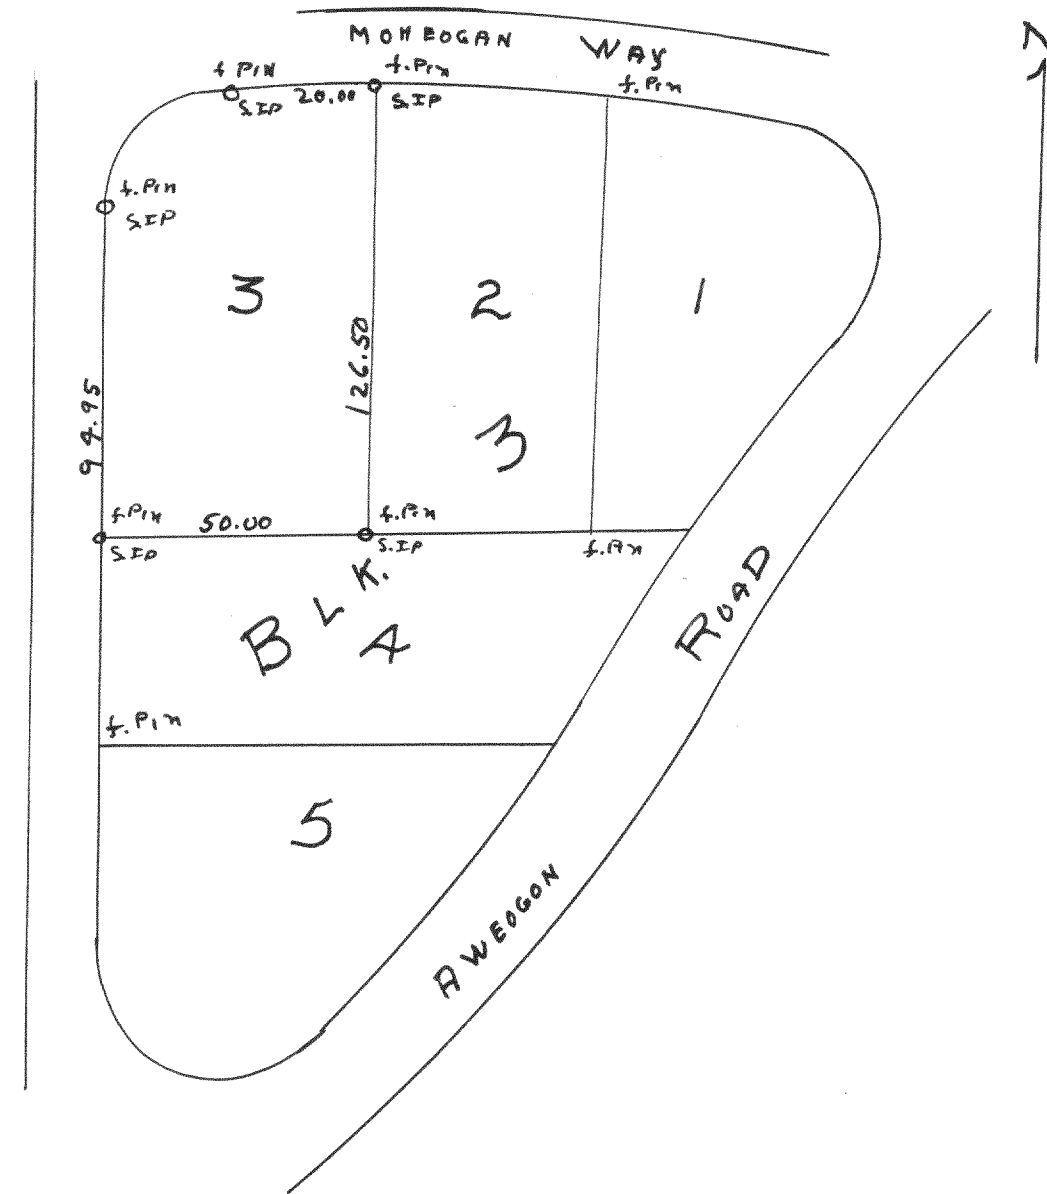


Plot of survey of lot 3 Block 3 of Indian Hills 1st Addition located in Fontana, Walworth County Wisconsin

May 1, 1947

Lloyd L Jensen
County Surveyor
[Signature]

#1804

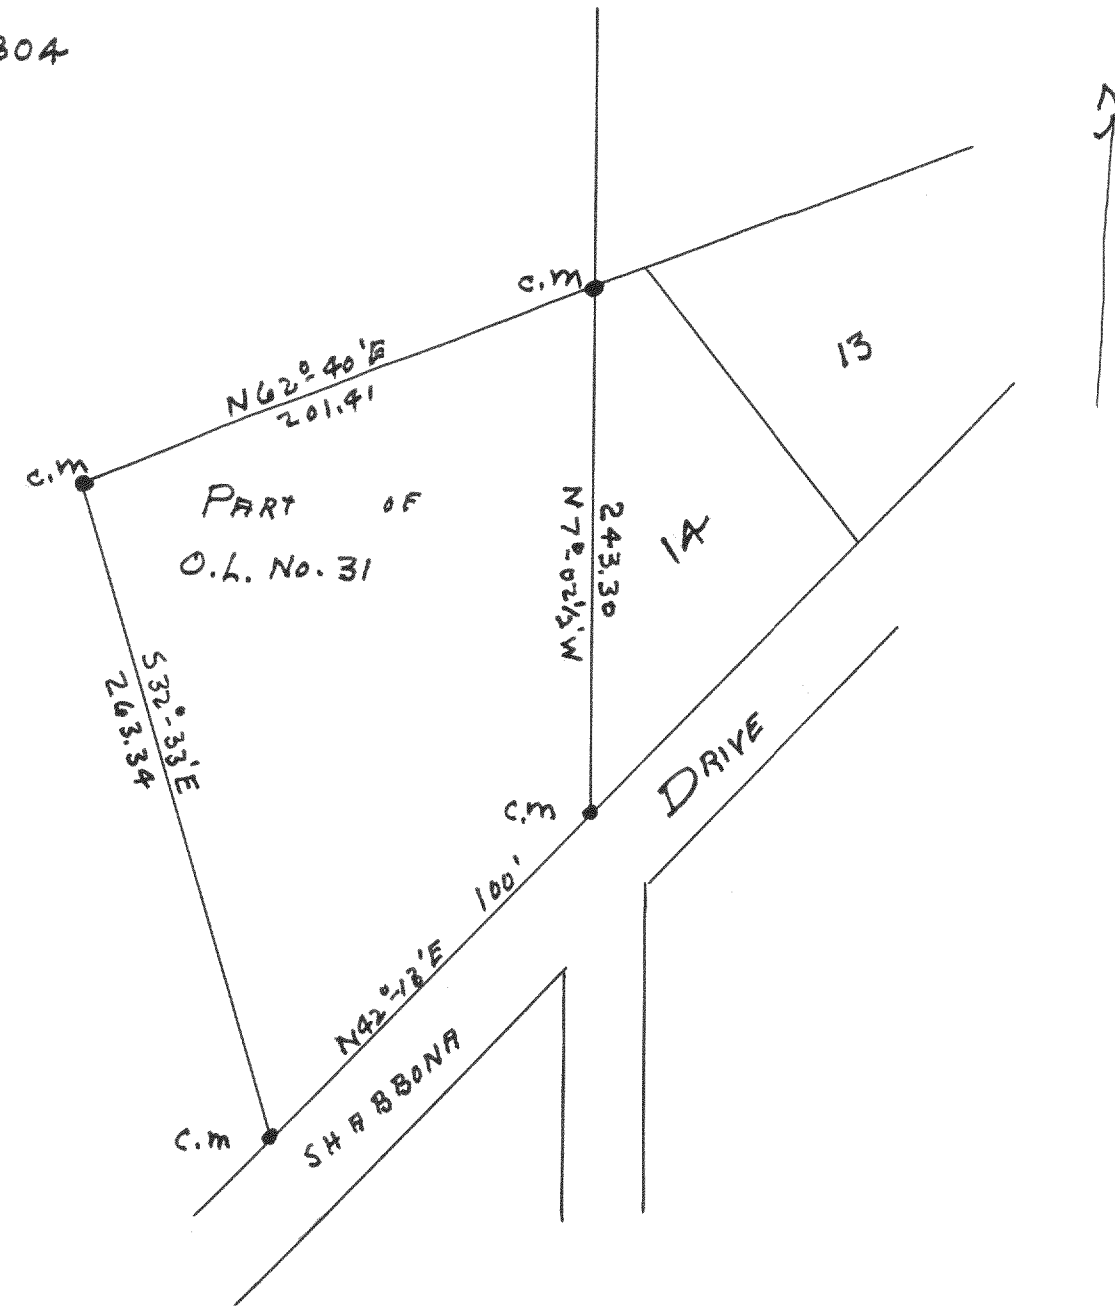

Plot of survey of part of O.L. #31 located in Section 14-T1N R14E Village of Fontana Walworth County Wisconsin

Nov. 12, 1946

Lloyd L Jensen
County Surveyor
[Signature]