



1809

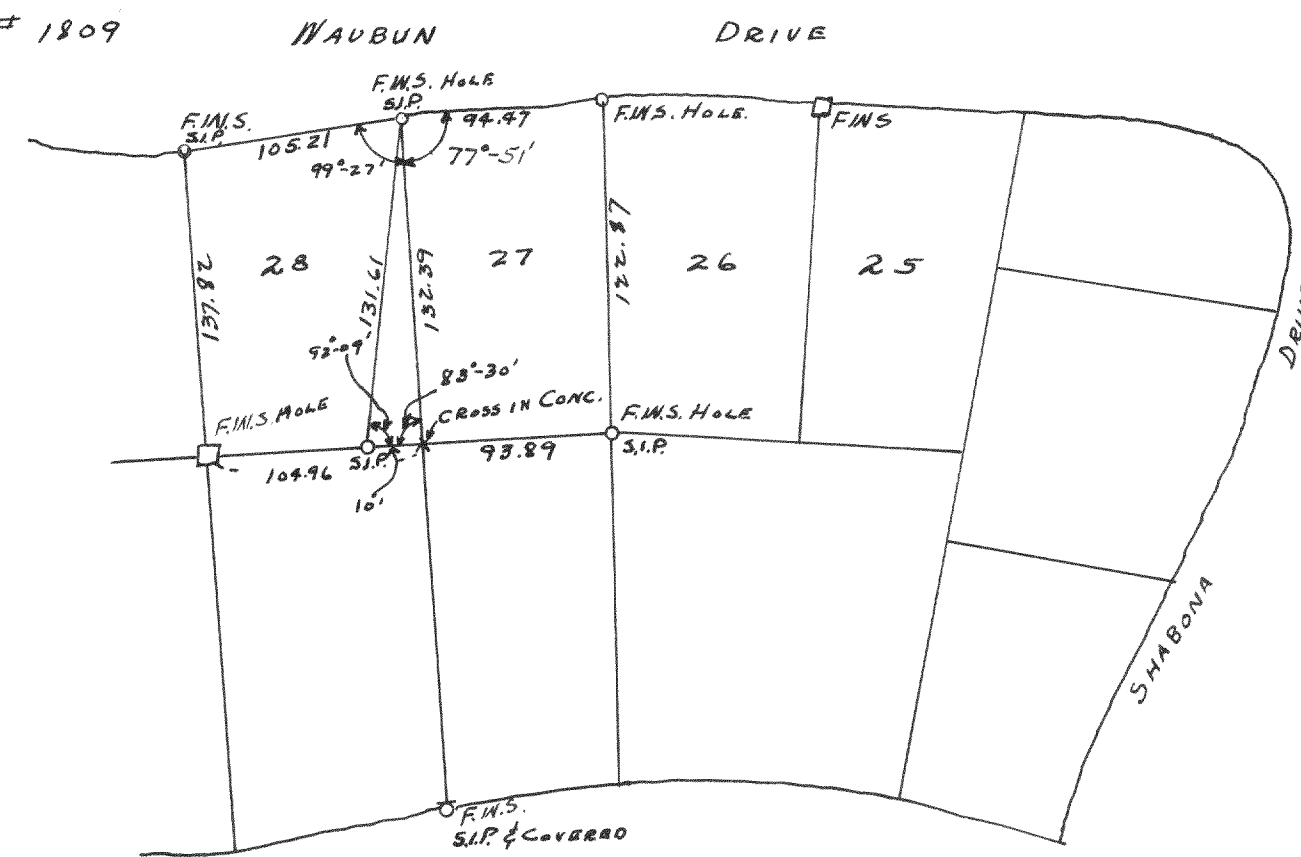

Plat of survey of Lots 27 & 28 in Unit #2 of
Country Club Estates, Village of Fontana
June 30, 1948
Lloyd L. Jensen
C.R.S.

1810

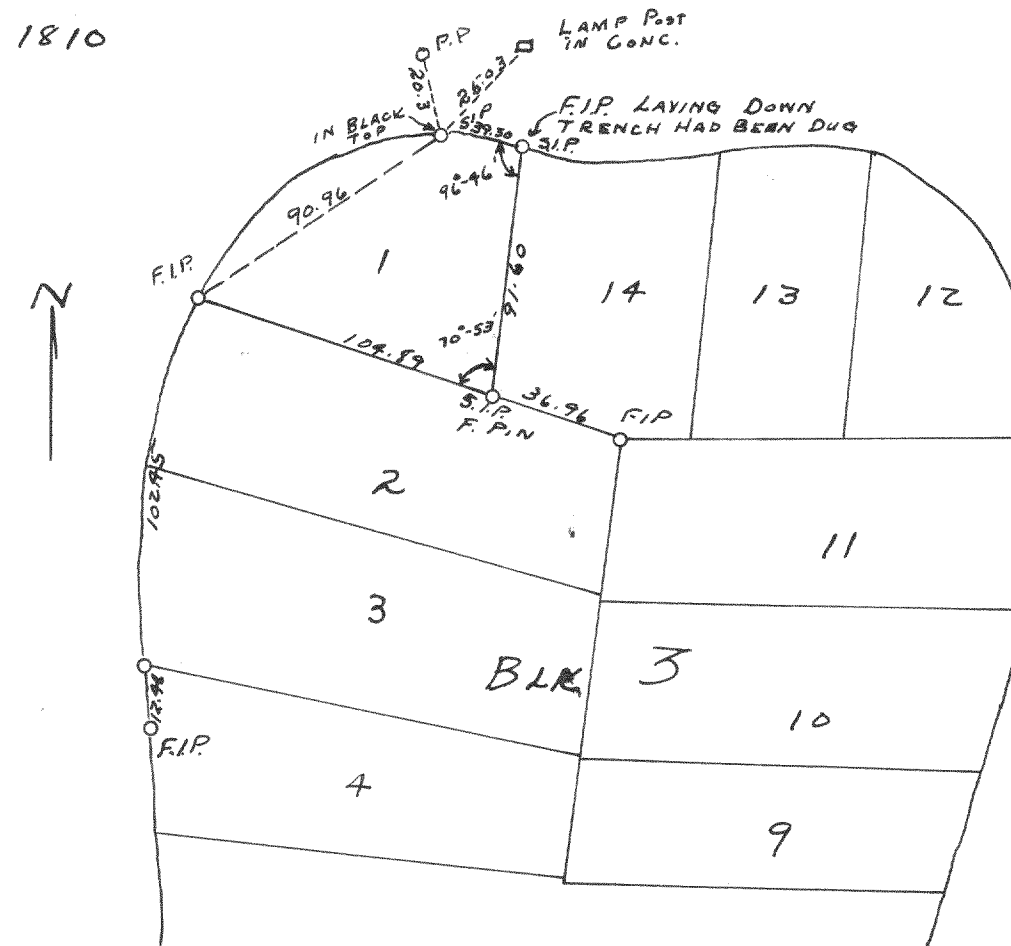

Plat of survey of Lot 1 Block 3 of
Indian Hills in the Village of Fontana
July 1, 1948
Lloyd L. Jensen
C.R.S.