



1814

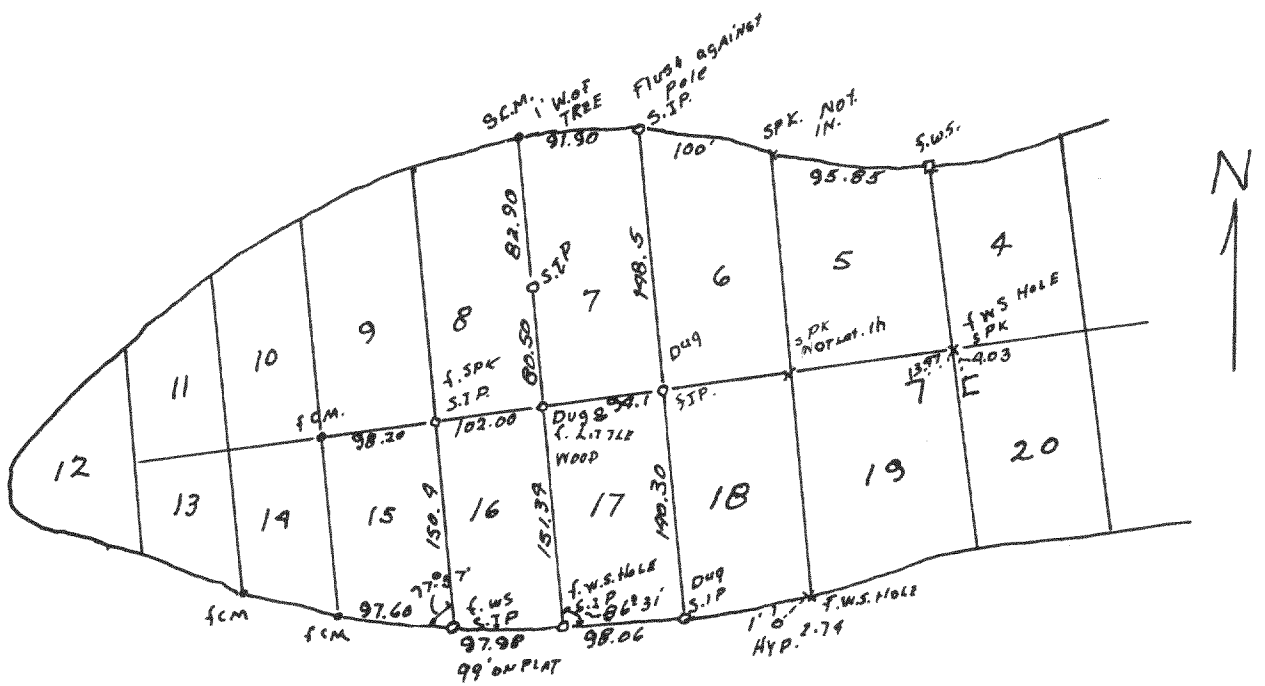

Survey lots 15, 16, 17, & 7 of Unit 2 Country Club Estate in the Village of Fontana, Walworth County.
Dec 17, 1948
July 6, 1948
Lloyd L Jansen
County Surveyor.
CL.

1815

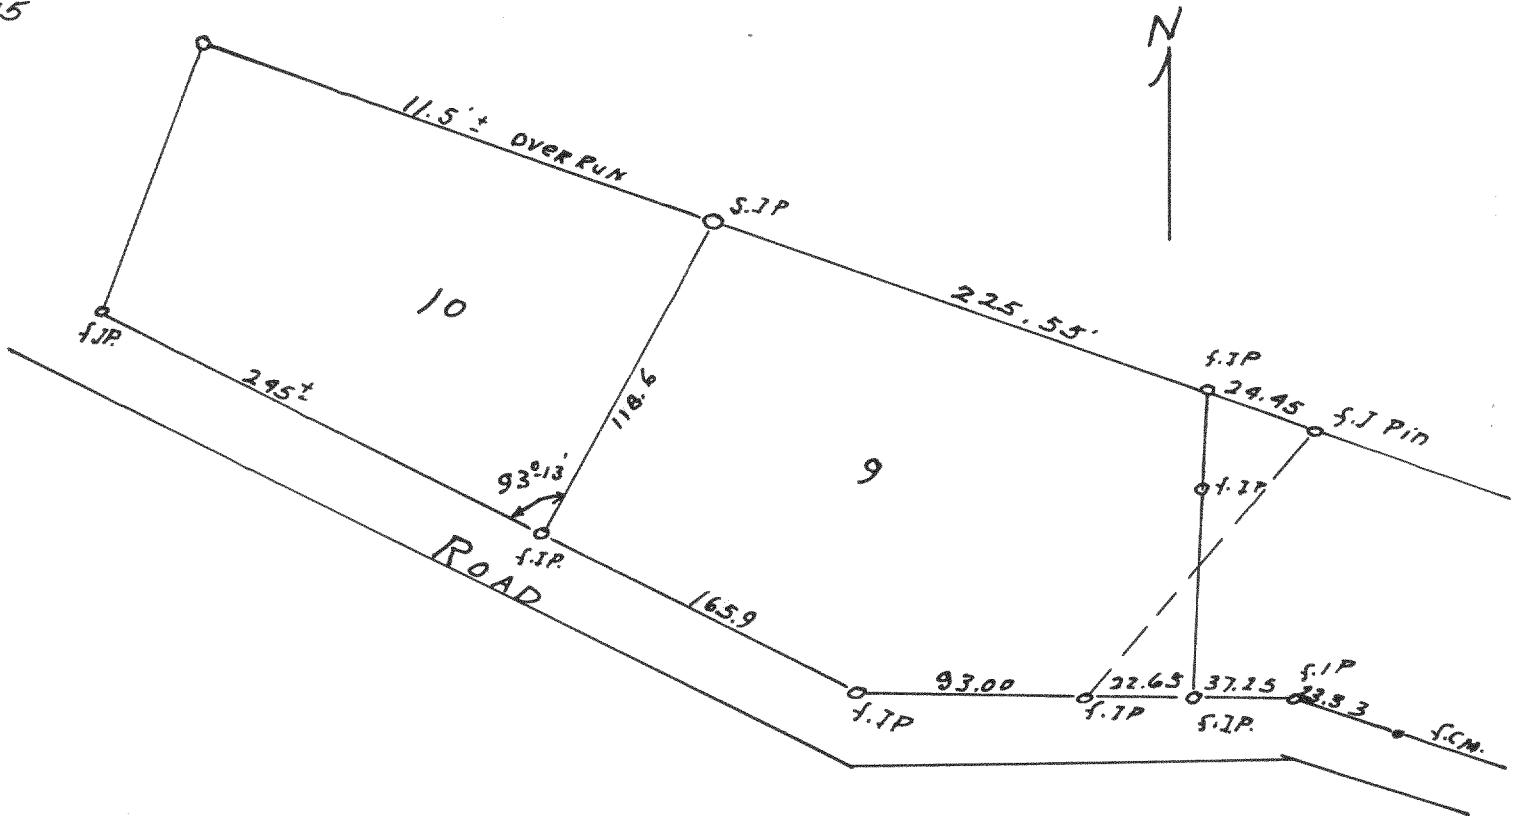

Plot of survey of Lot 9 in the Hardins, Village of Fontana, Walworth, County.
July 2, 1948
Lloyd L. Jansen.
County Surveyor.
CL.