



1836

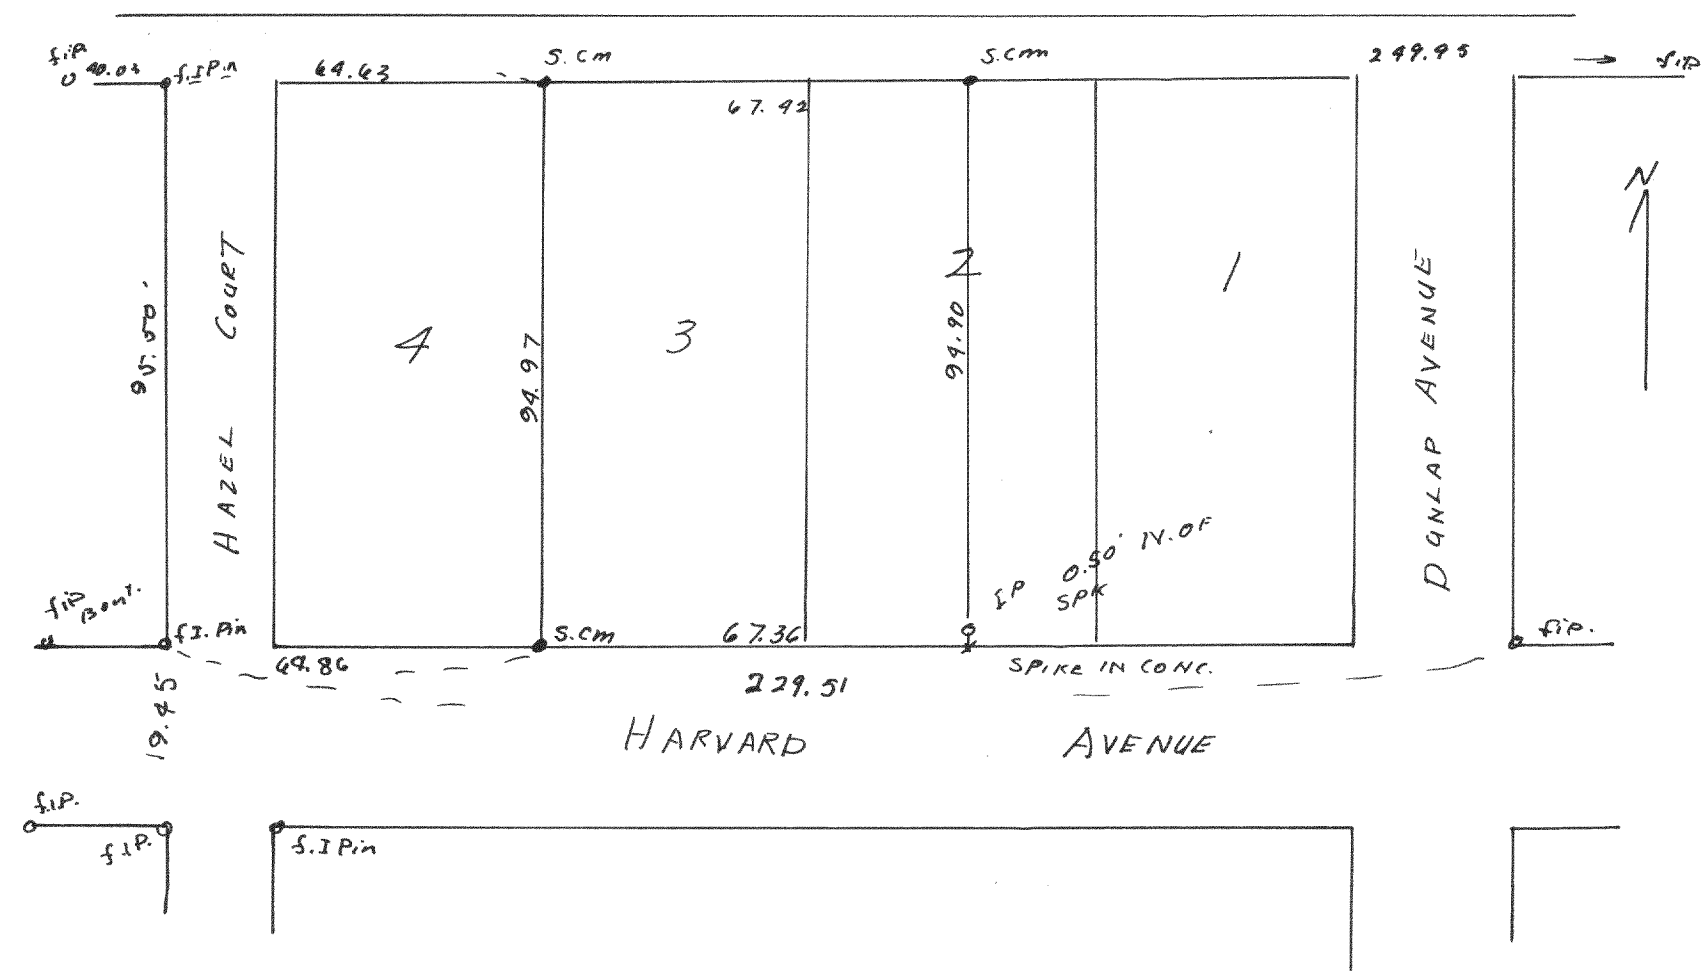

Plot of Survey of the W 1/2 of lot 2 and lot 3 Block 6 in
Glenwood Springs, Village of Fontana, Walworth County,
Oct. 1948.
Lloyd L. Jensen
County Surveyor.
C.S.

1837

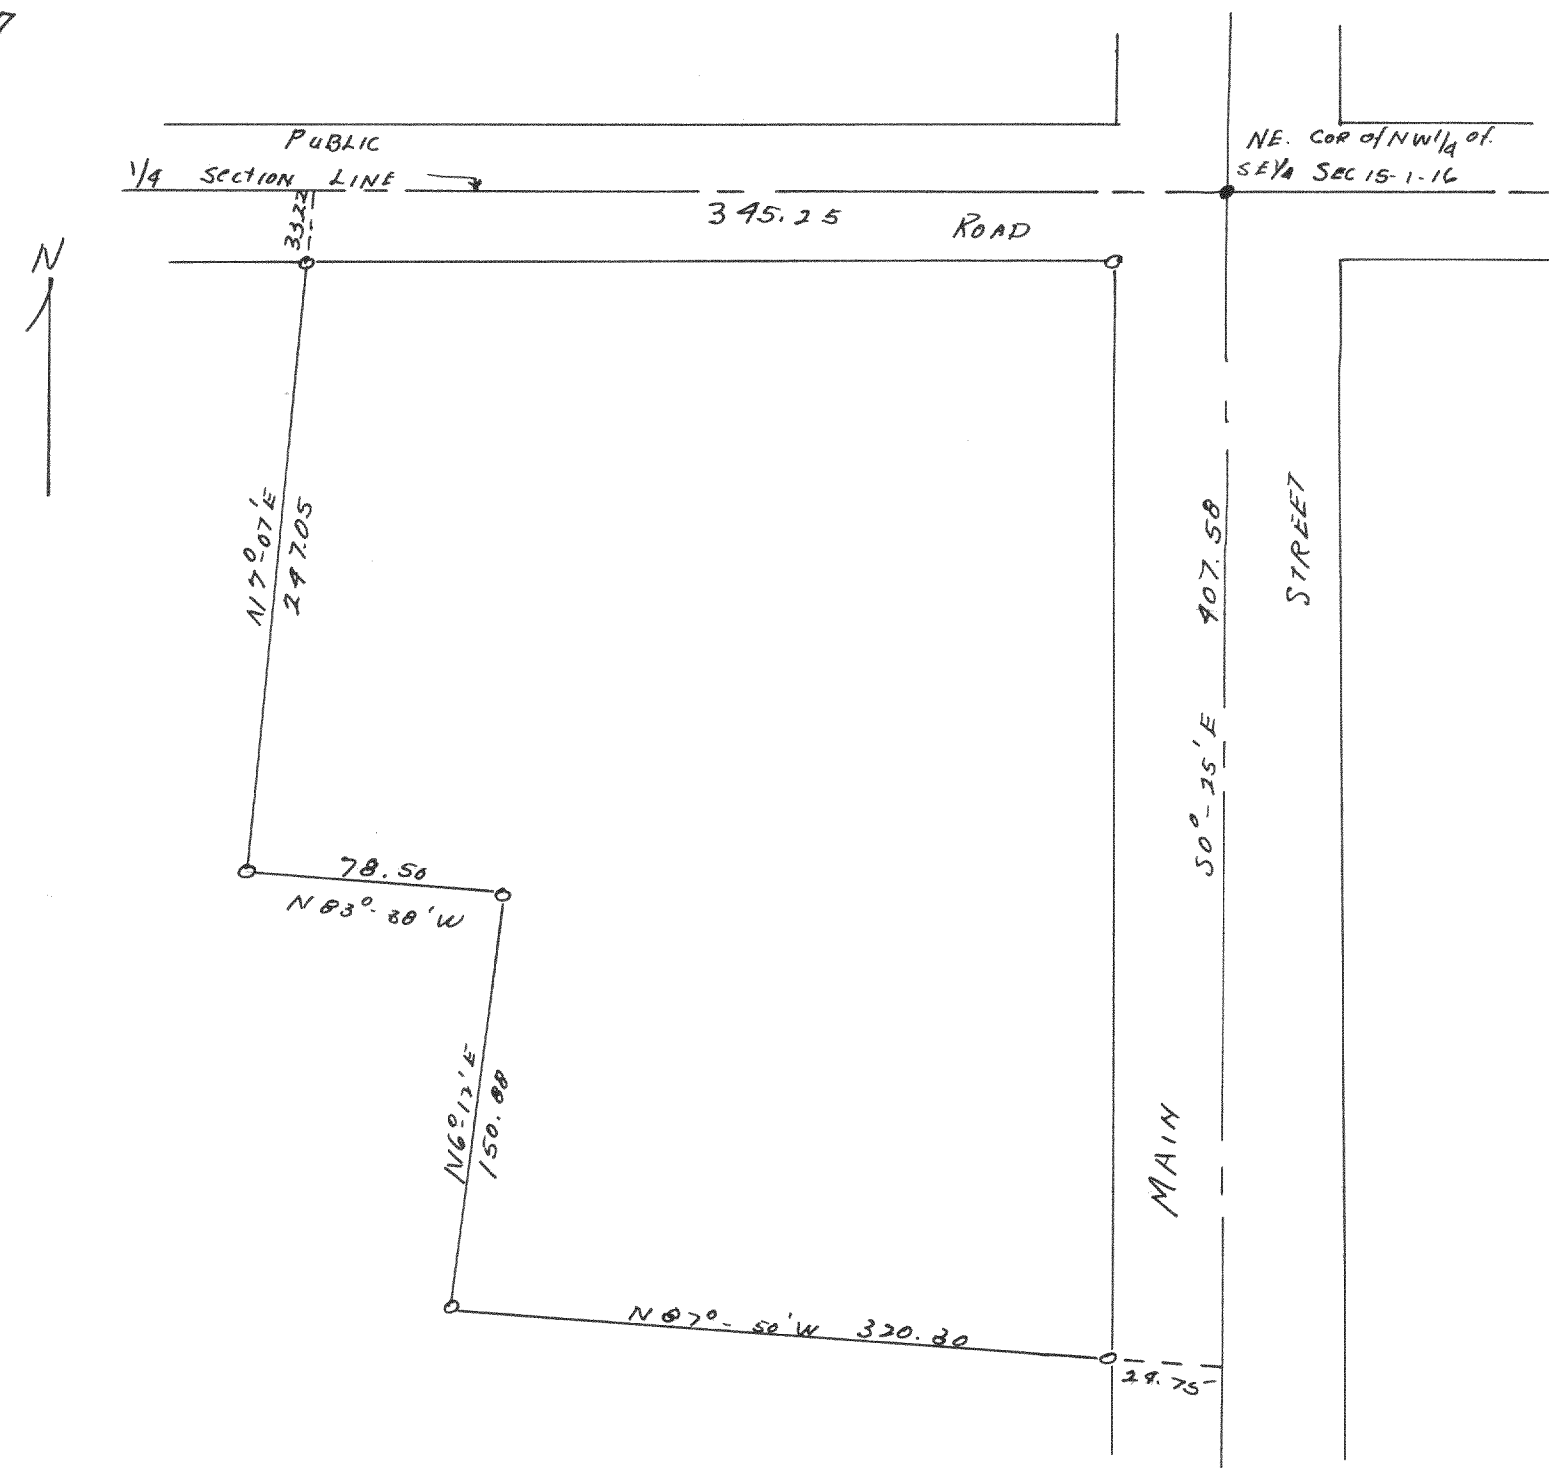

Plot of survey of part of lot 19 of the Village of
Fontana, Walworth County
March 1948.
Lloyd L. Jensen
County Surveyor.
C.S.