



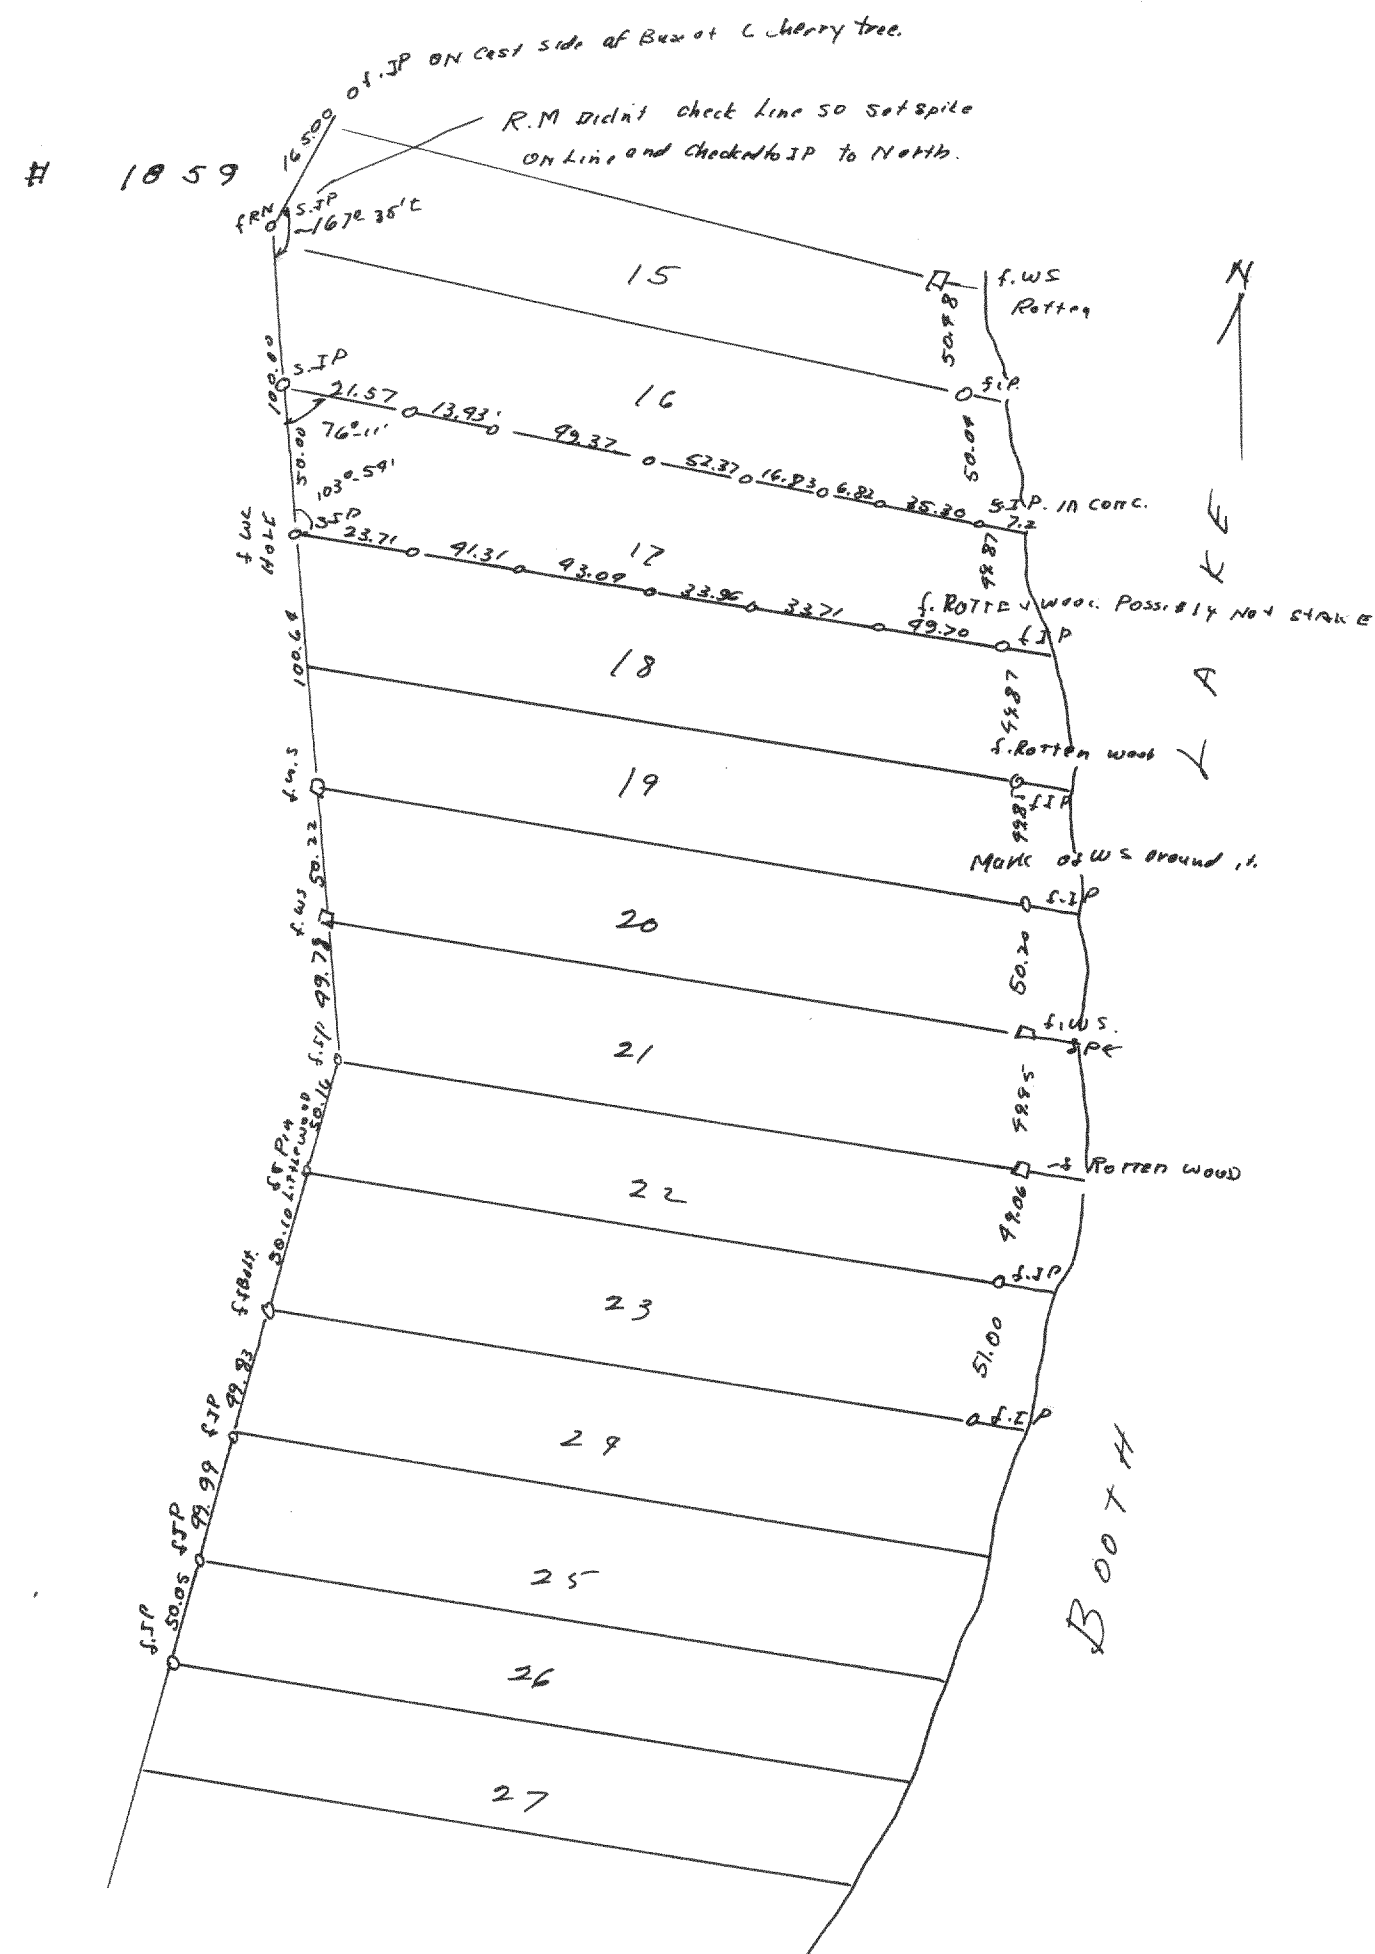

1860

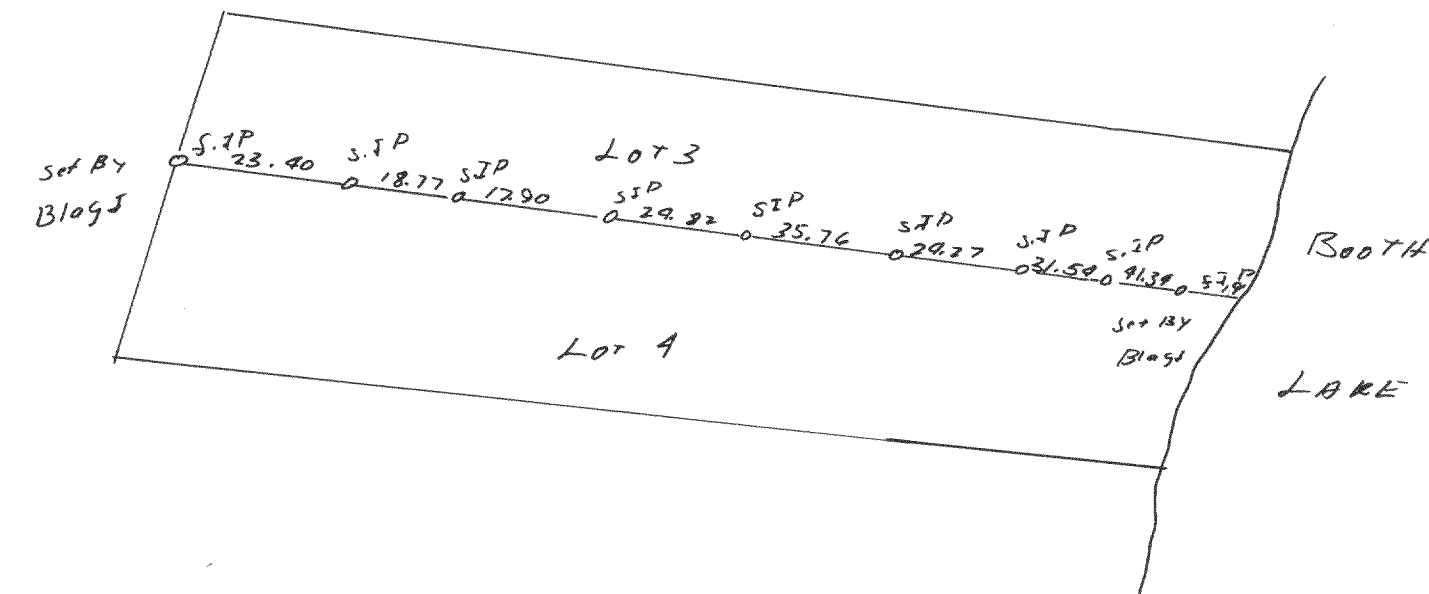

Plat of line of pipe set between Lots 3 & 4 of Booth Lake Heights
Subdivision located in Section ²⁴ ~~12~~ T4N R17E Walworth County
July 27, 1998
Lloyd L Jensen
County Surveyor
et.

Plat of survey of lot 17, Booth Lake Heights Subdivision
located in Section ²⁴ ~~12~~ T4N R17E Walworth County
July 19, 1998
Lloyd L Jensen
County Surveyor
et.