



#1861

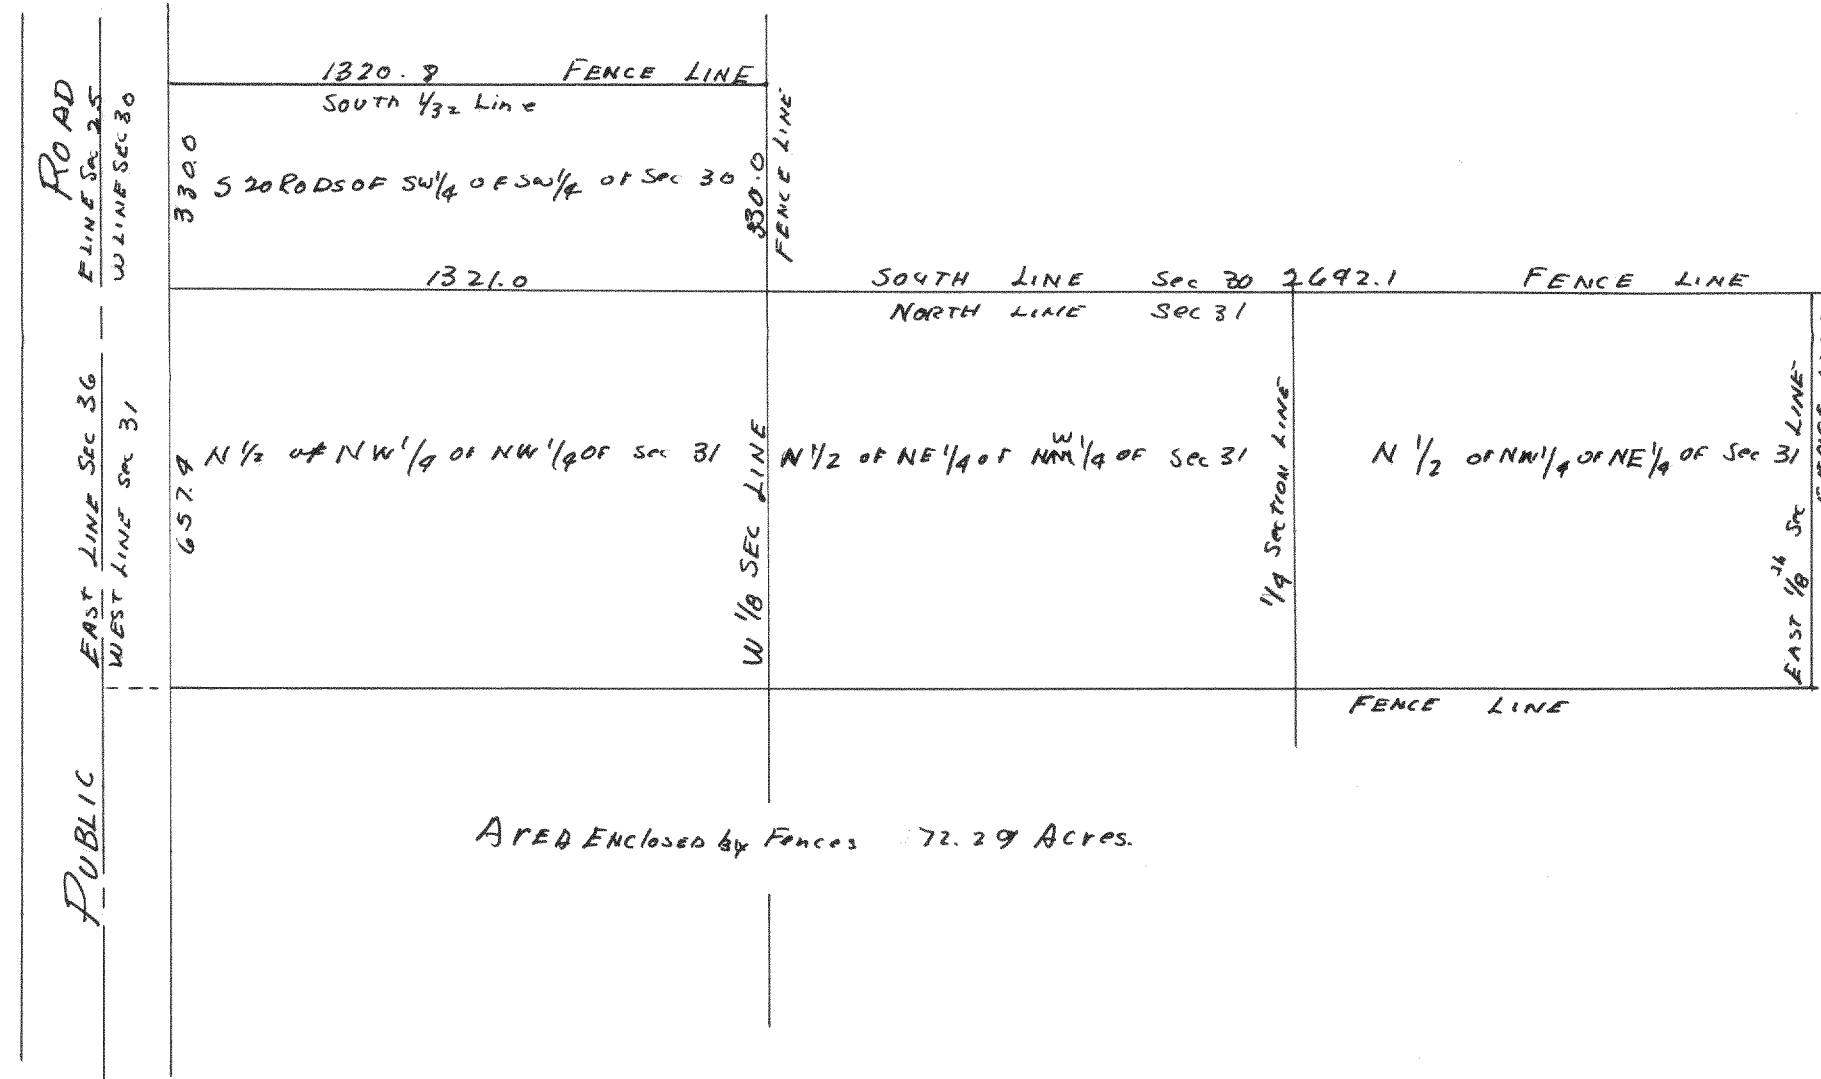

Plot of Survey of the present fence line marking the property known as the Zimma Farm located on Section 30 + 31 of T4N R17E Walworth County April 1, 1948

Lloyd L. Jensen
County Surveyor
C.L.

#1862

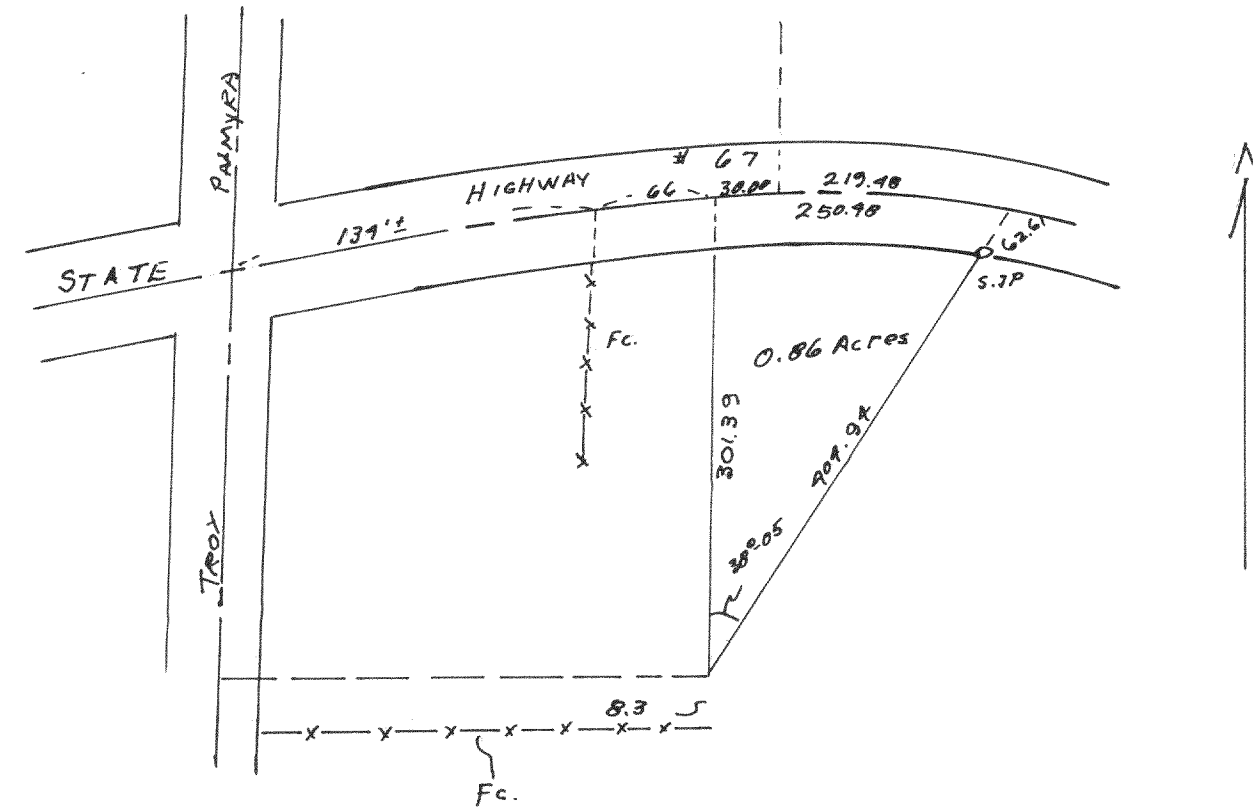

Plot of survey of a parcel of land located in the Northwest 1/4 of Section 6, T4N R17E Walworth County
Sept 16, 1948

Lloyd L. Jensen
County Surveyor
C.L.