



1874

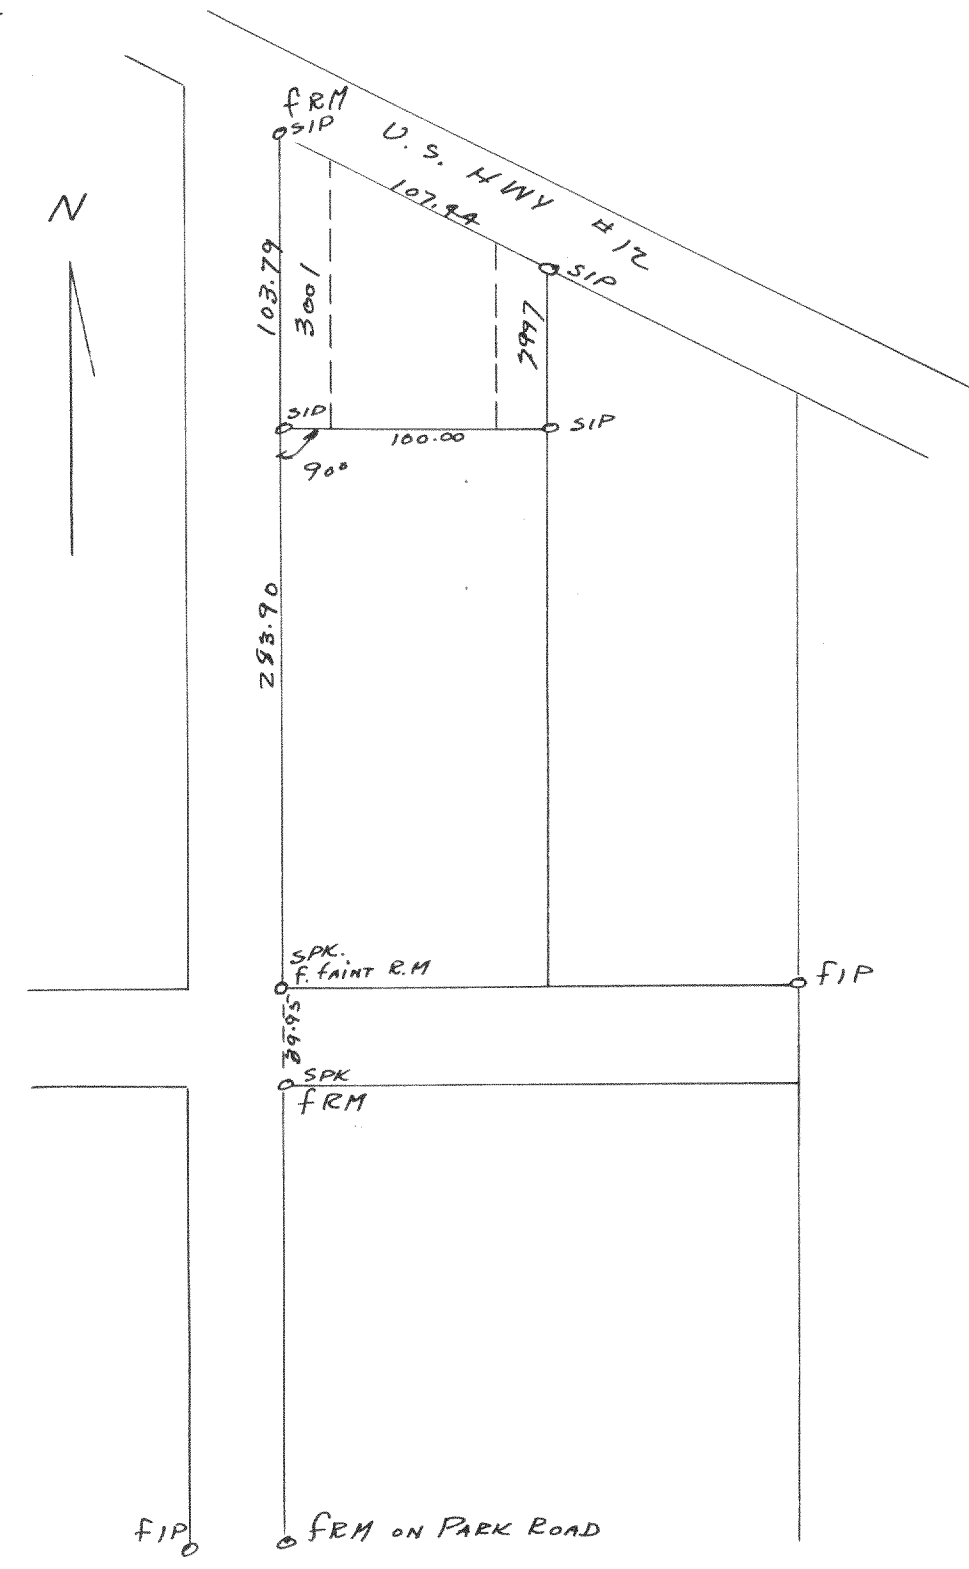

1875

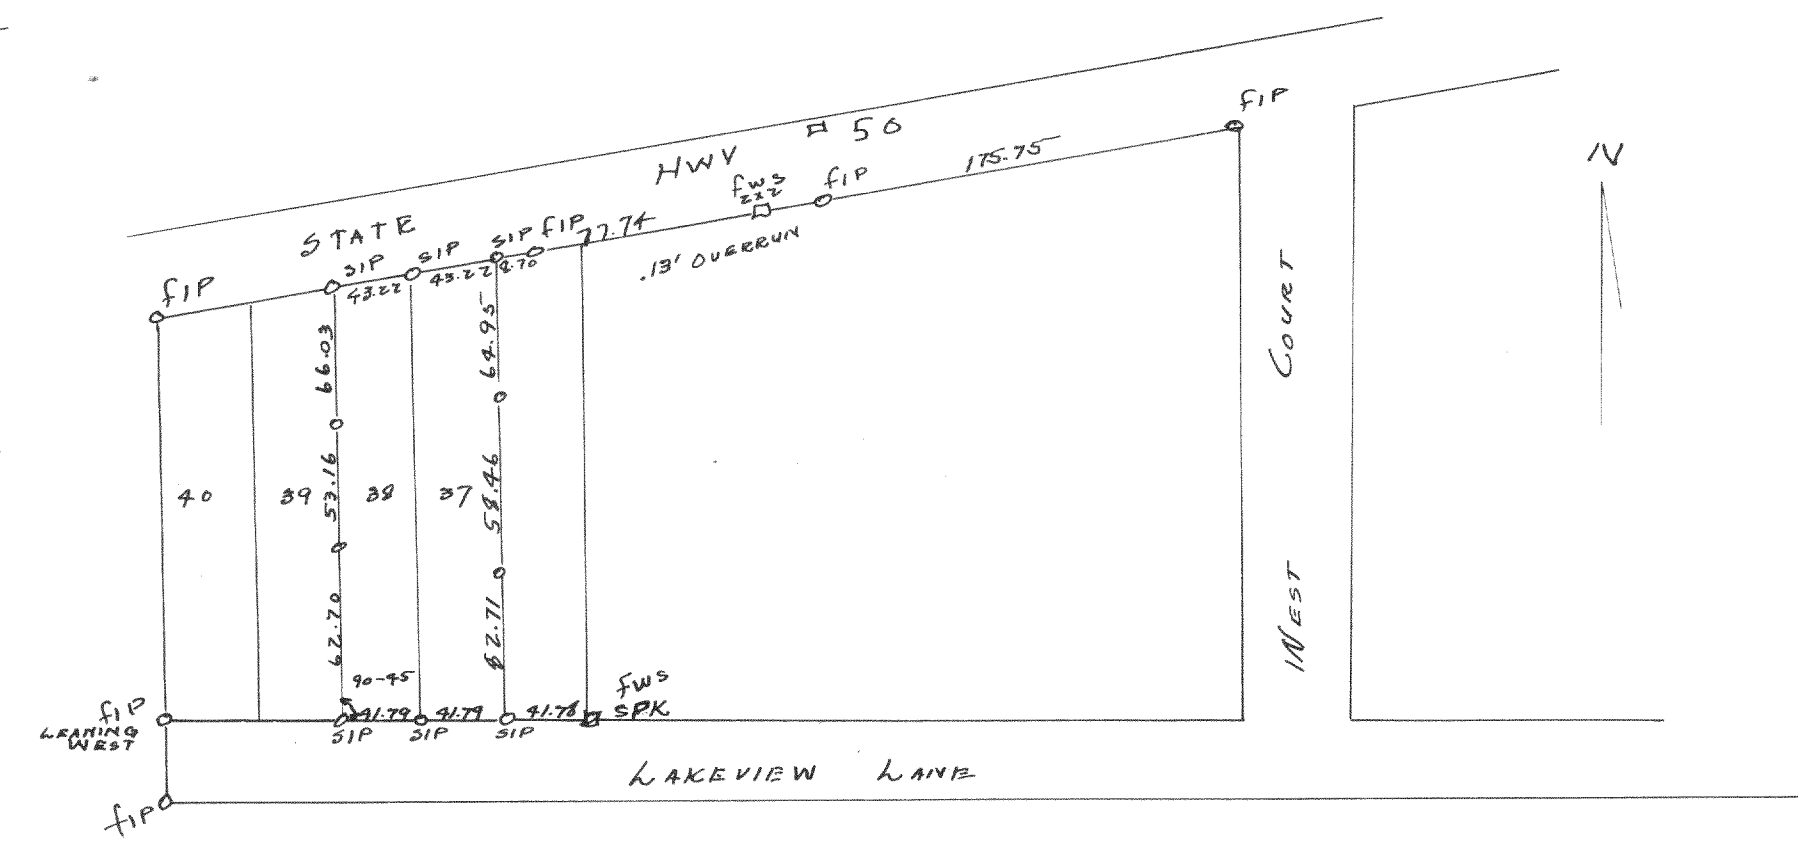

Plat of Survey of lots 37 & 38 in Lake Geneva Knoll Subdivision
located in Section 32, T2N R17E Walworth County.
Aug 27, 1948 Lloyd S. Jensen
CWS.

Plat of Survey of lots 2997-3001 Lake Corso Beach
Subdivision located in Section 21 & 22 T2N R17E Walworth County
Aug 18, 1948 Lloyd S. Jensen
CWS.