



1891

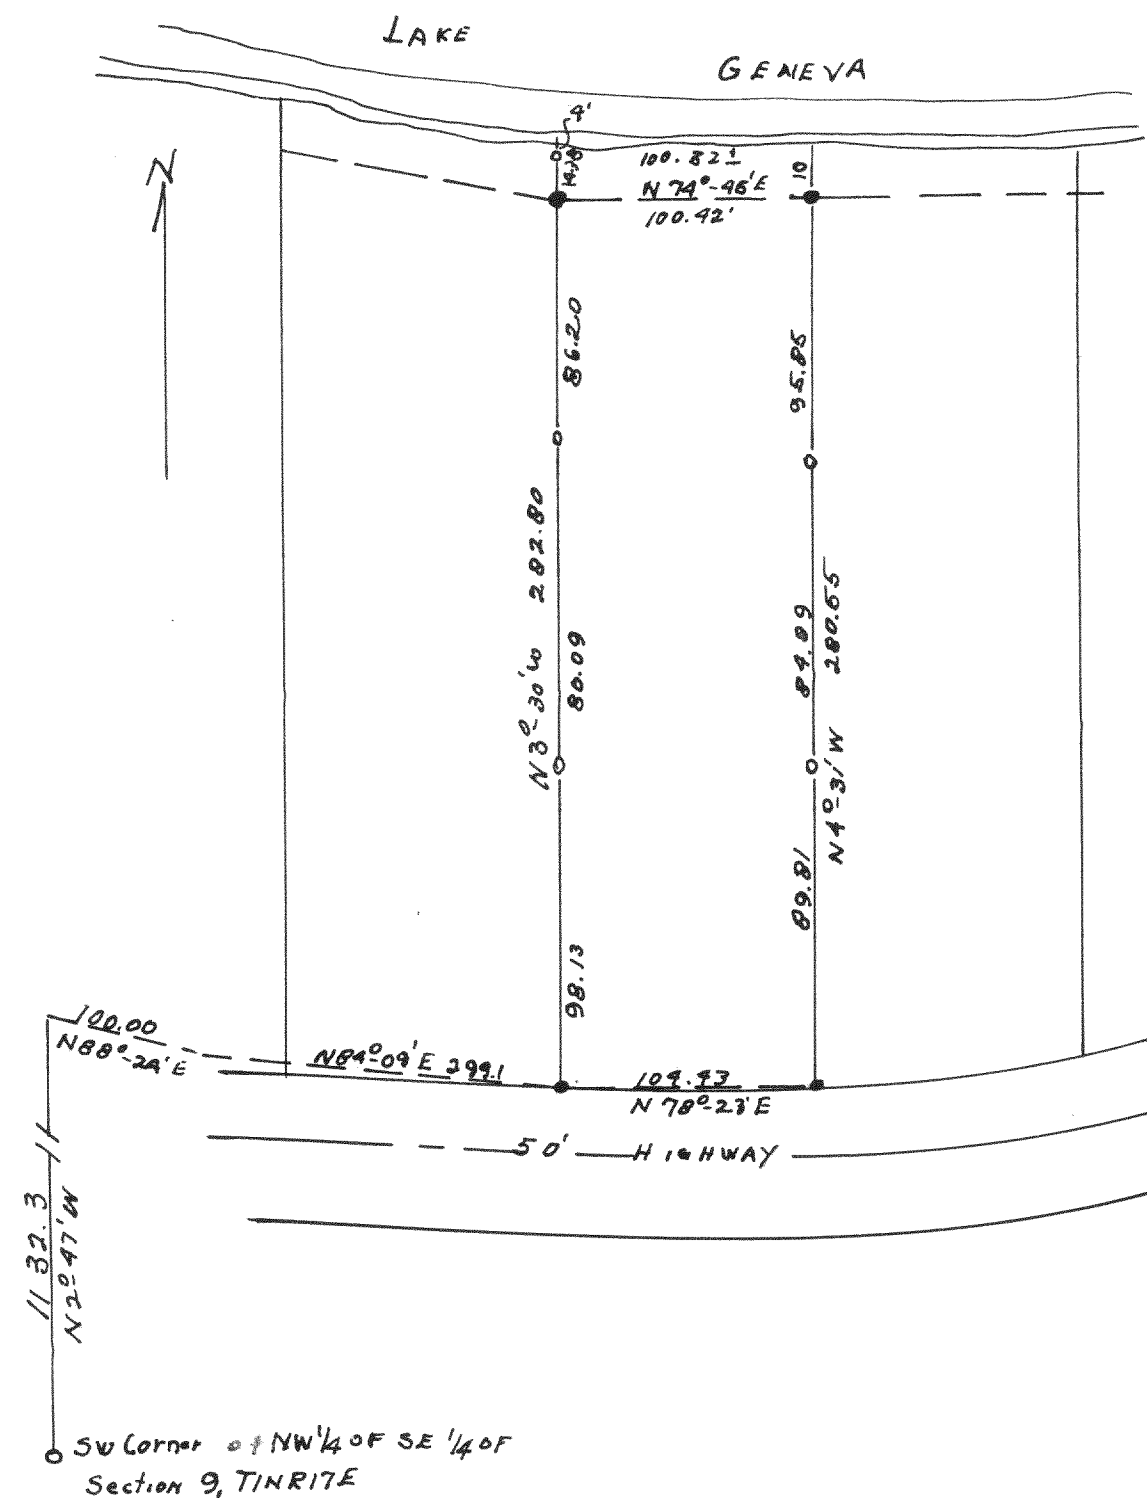

Plat of survey of a parcel of land located in
Section 3 T1N R17E Walworth County
Aug. 25, 1998 Lloyd L. Jensen
County Surveyor
C.S.

1892

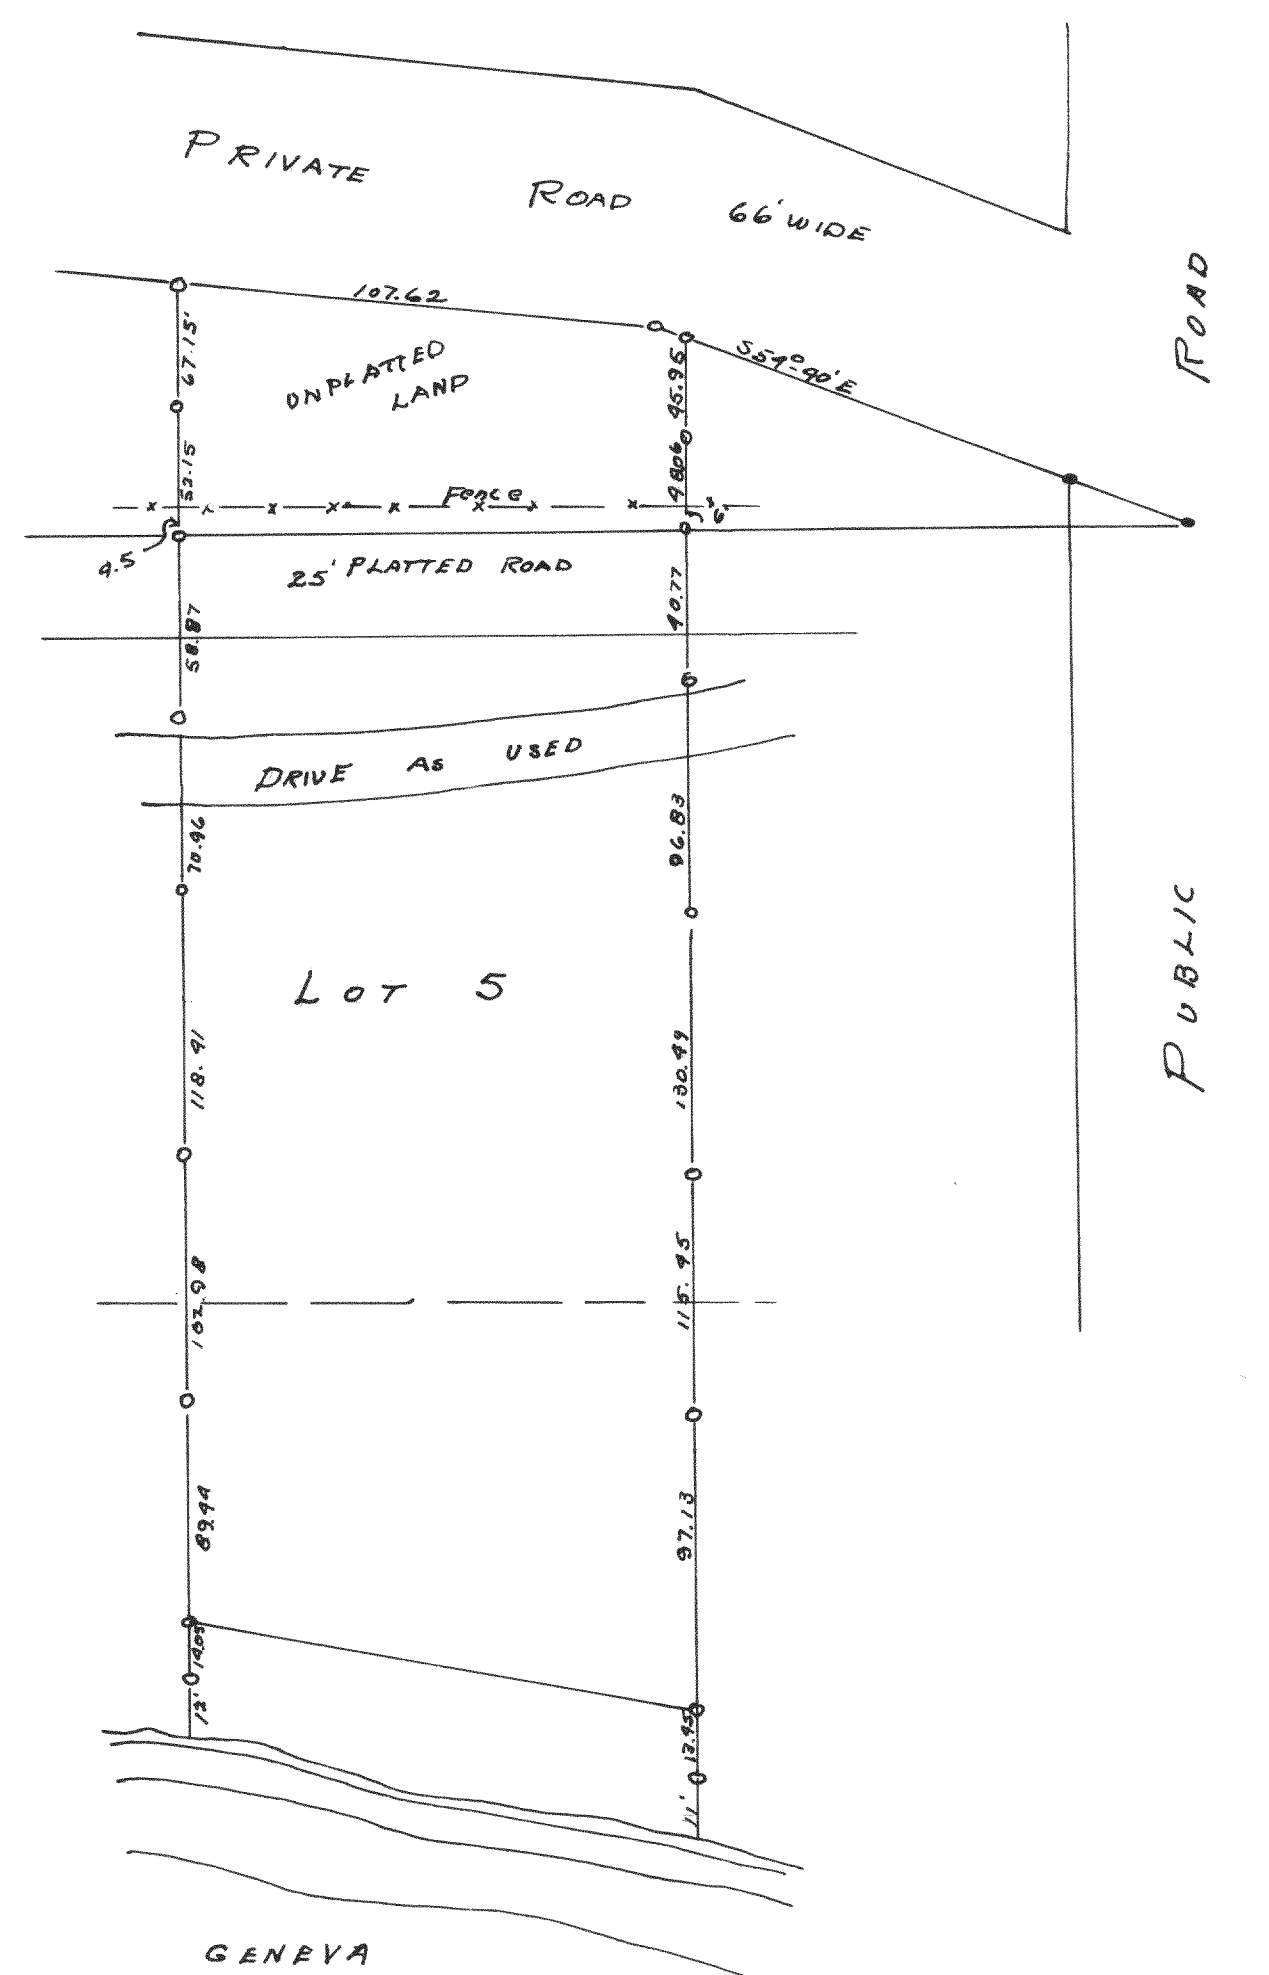

Plat of survey of Lot 5 of the SB Chapina Subdivision located
in Fractional Section 9, T1N R17E Walworth County
APRIL 1948 Lloyd L. Jensen
County Surveyor
C.S.