



#1921

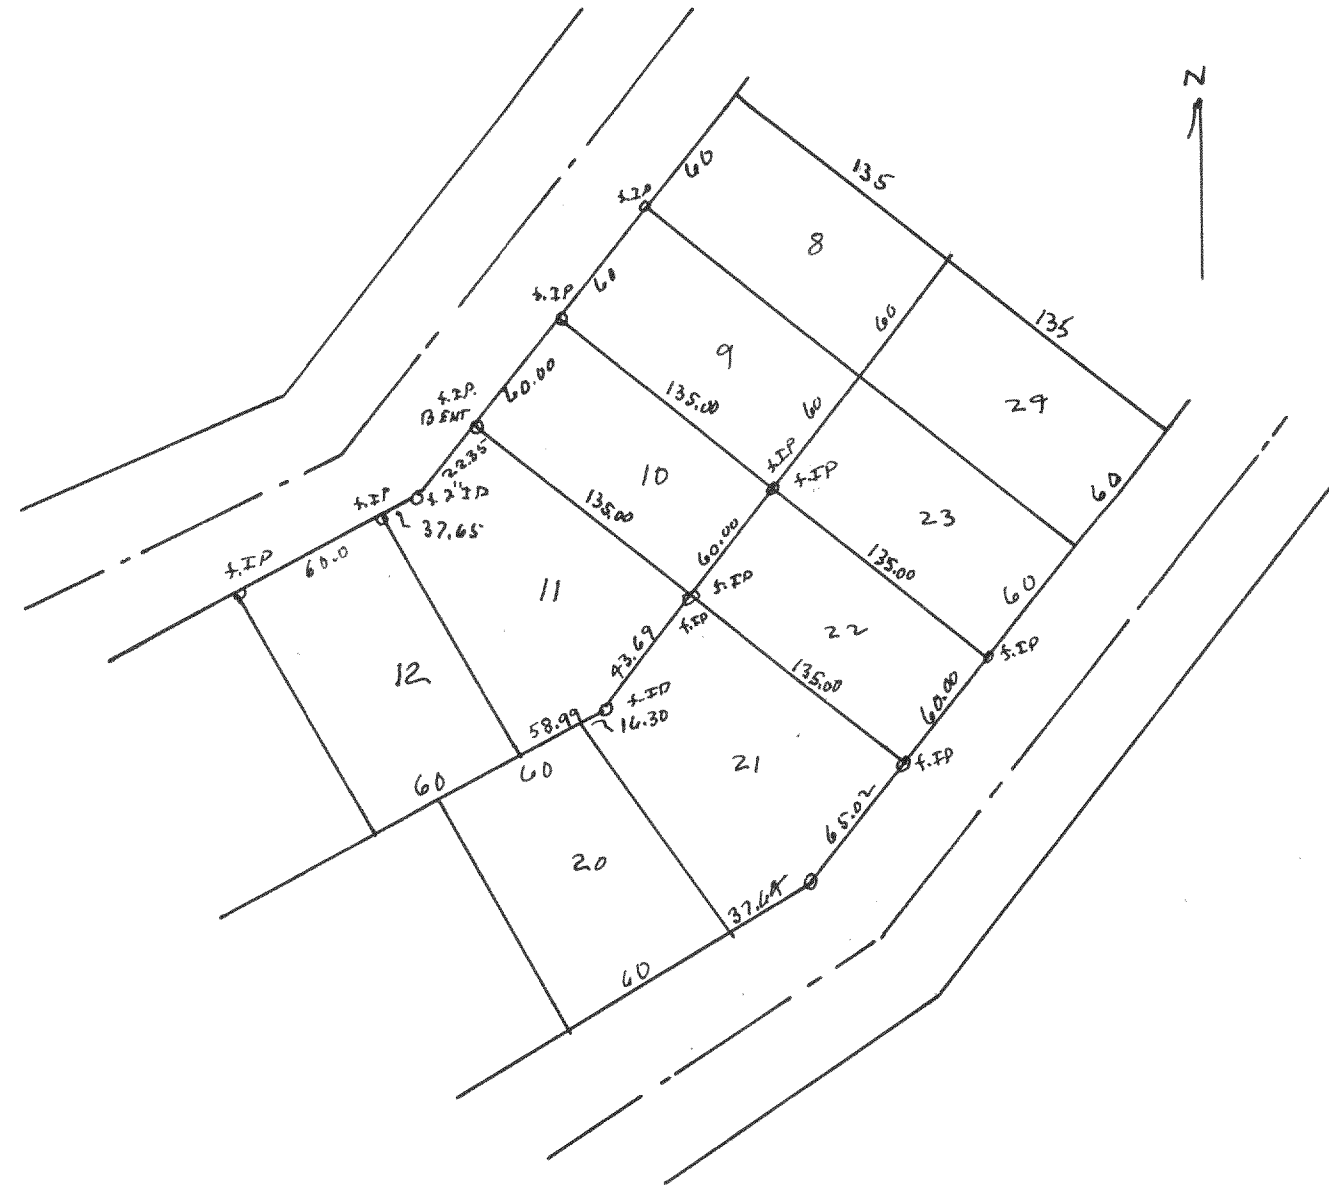

Plot of survey of lots 10 & 22 in Block 1 of Delmar subdivision
located in section 27 T2N R16E Walworth County Wisconsin
July 16, 1978
Floyd Jensen
County Surveyor

#1922

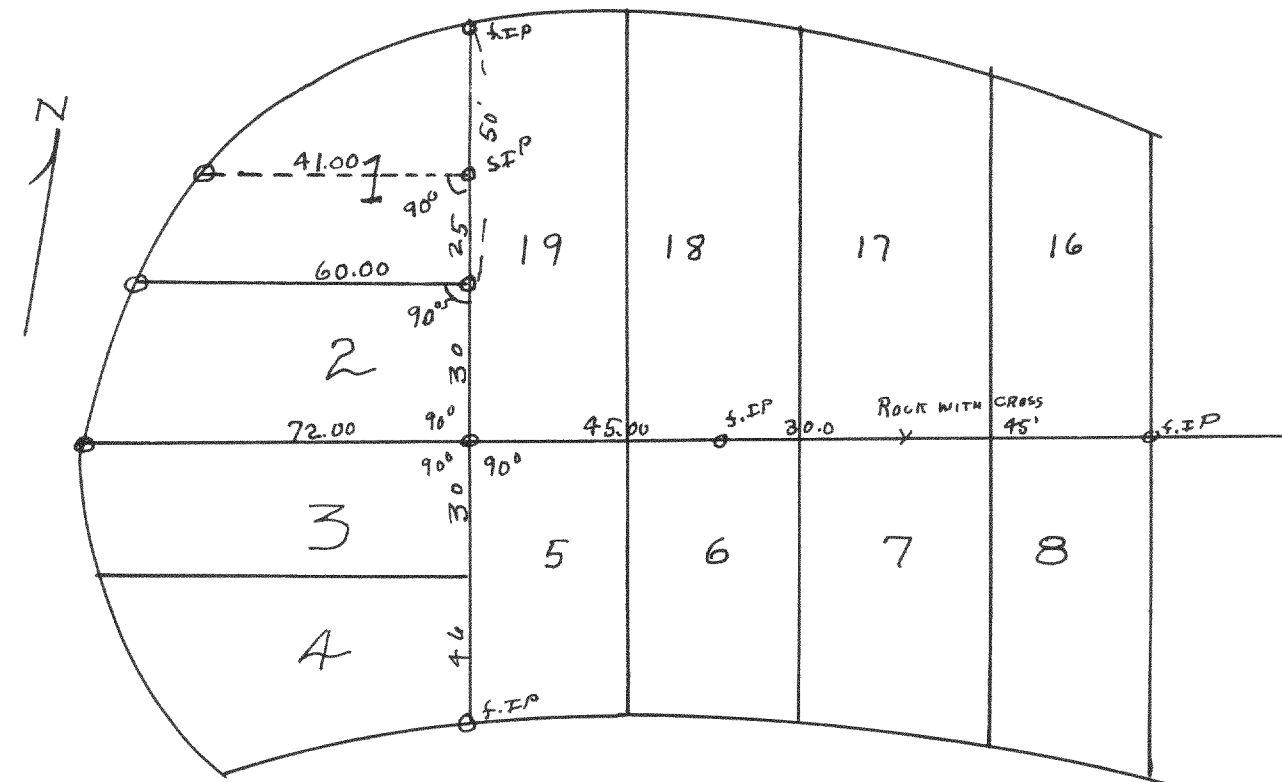

Plot of survey of lots 2 & 5 1/2 lot 1 Block 9 Delmar Lake
Assembly grounds located in section 21 T2N R16E Walworth County
July 16, 1978
Floyd Jensen
County Surveyor