



1939

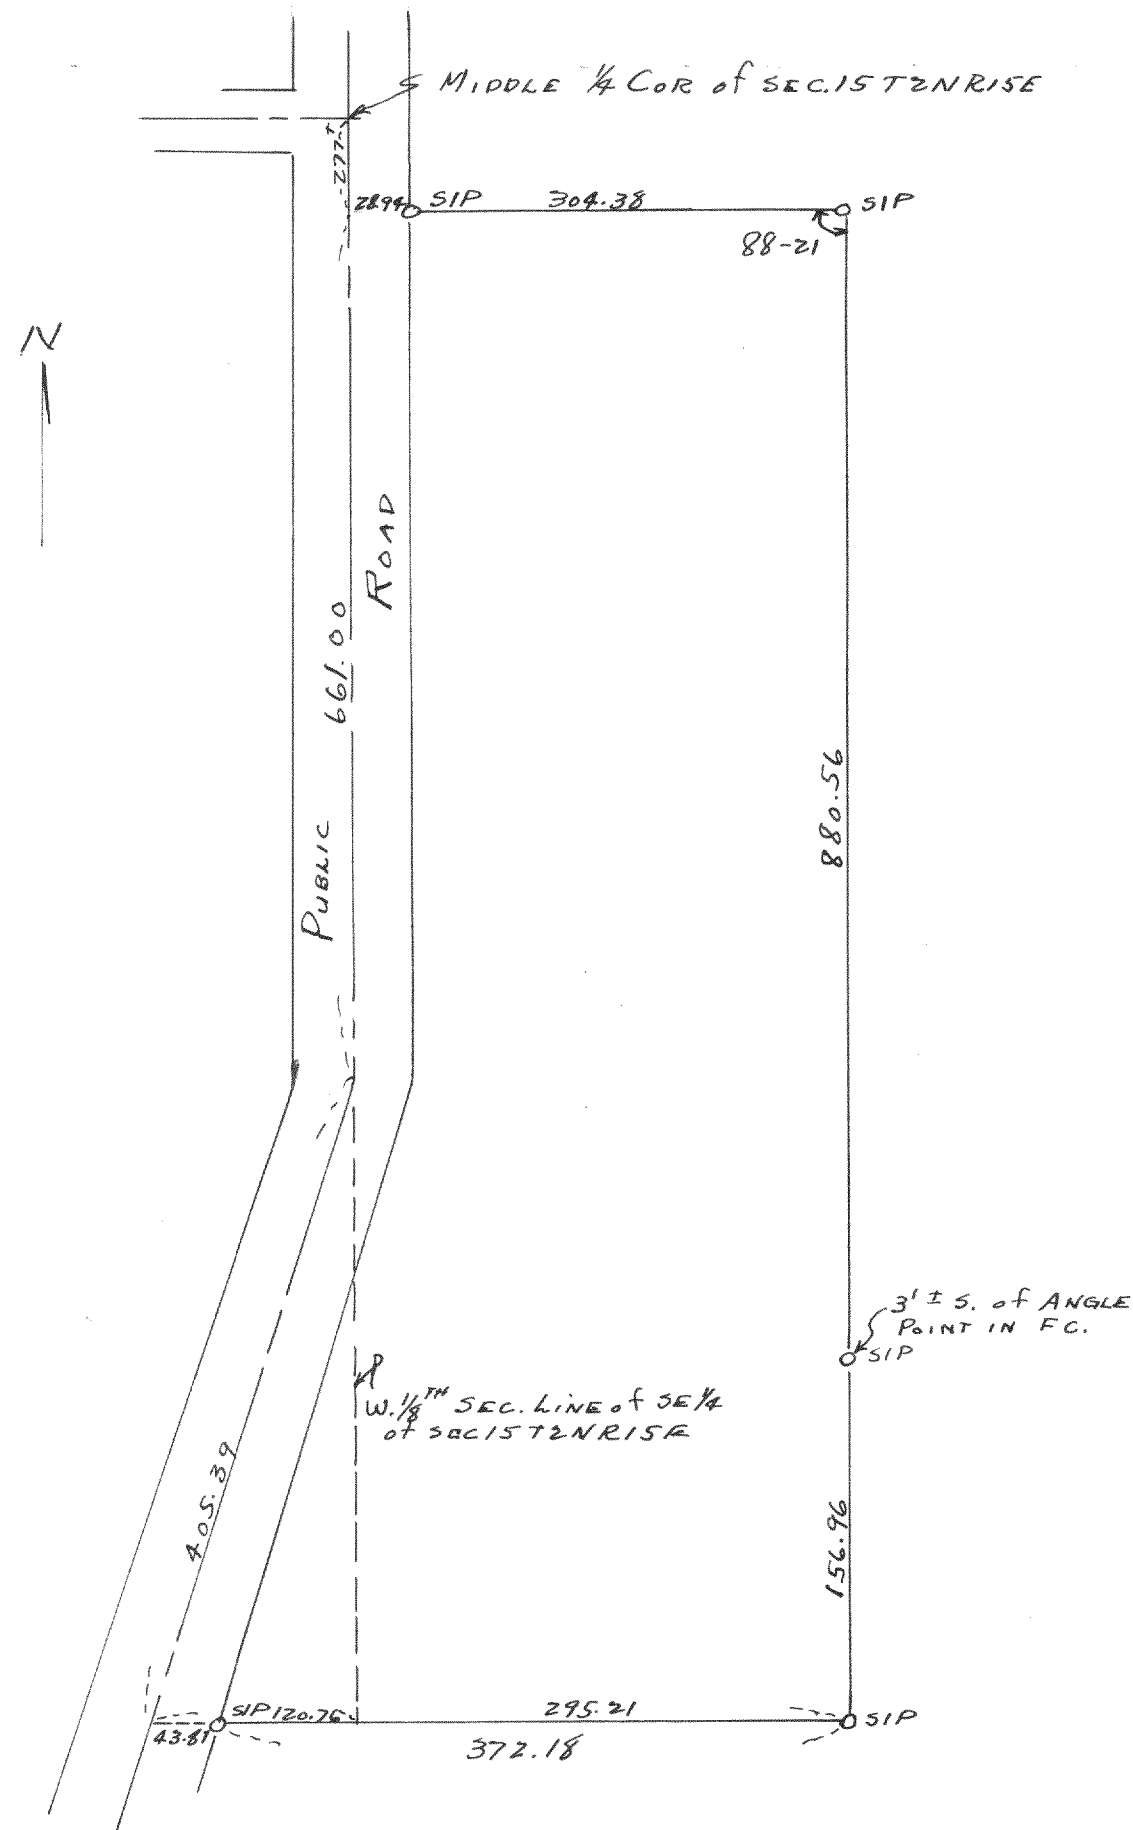

Plot of survey of a parcel of land located in the S 1/2 of
Section 15 T2N R15E Walworth County
Aug 30, 1948
Lloyd L Jensen
CWS

1940

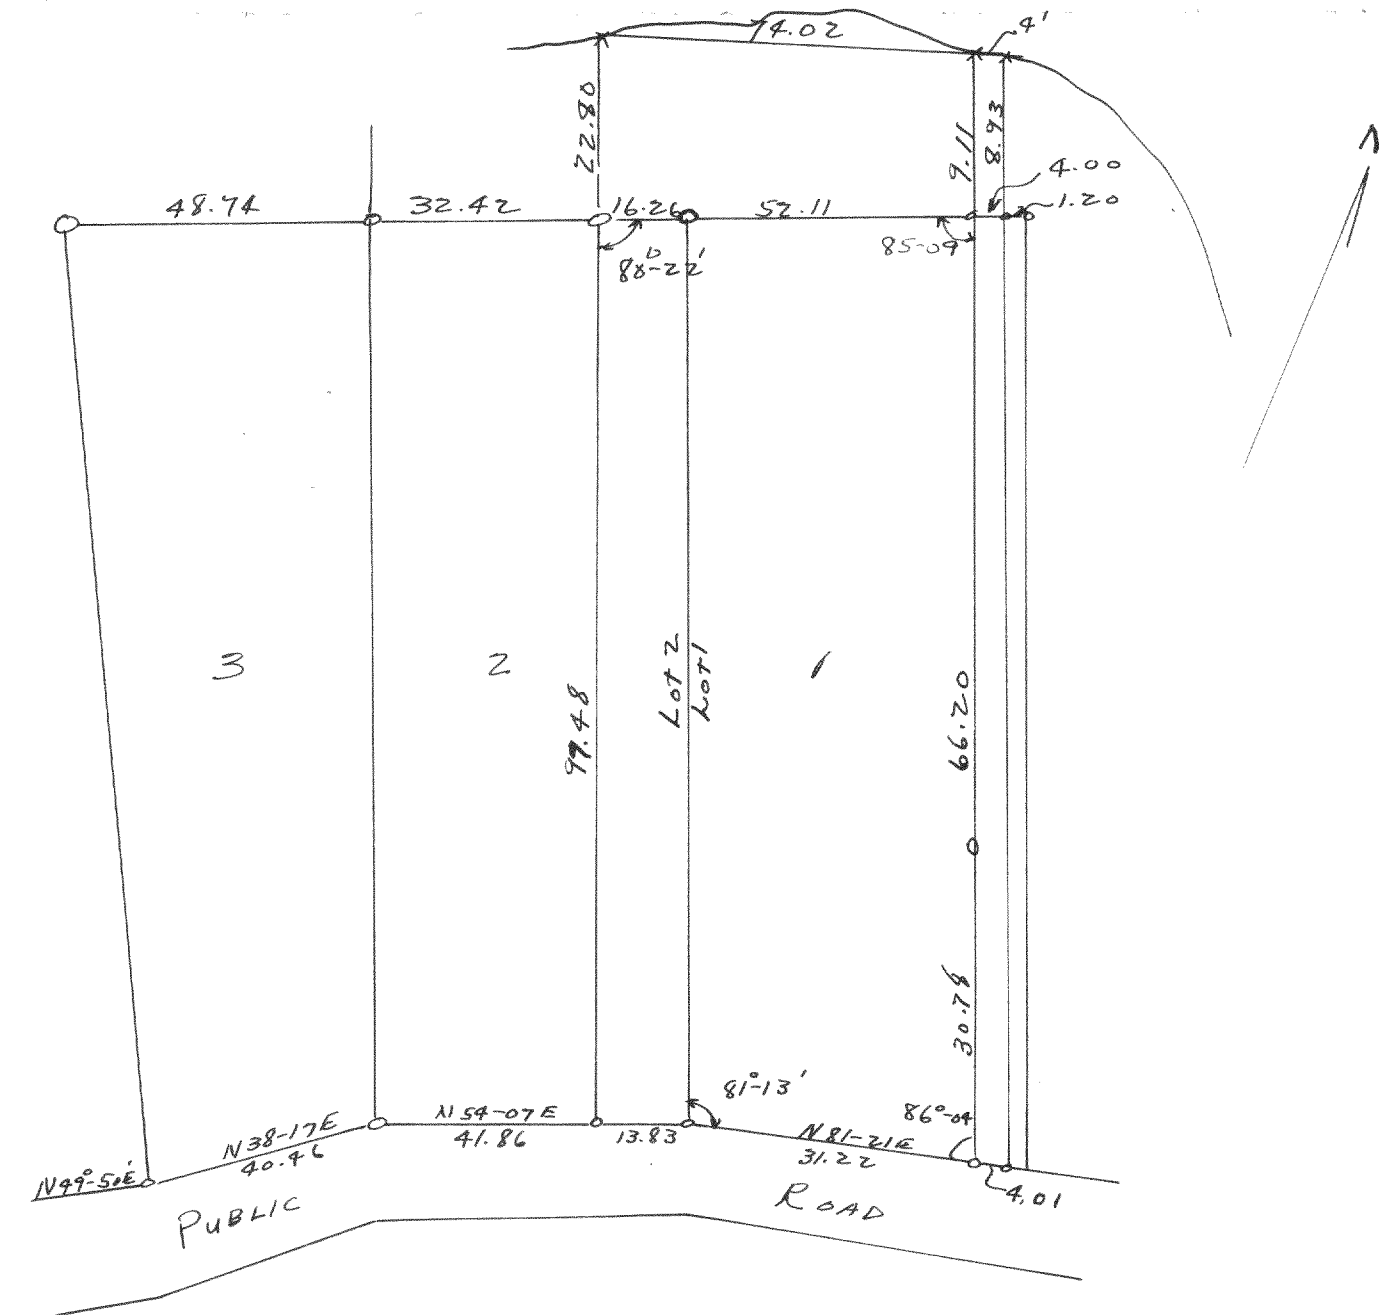

Plot of survey of parts of lots 1 & 2 Green Island Subd.
Landsdale Lakes in S.E 1/4 Section 26 T4N R16E Walworth County
May 14, 1948
Lloyd L Jensen
CWS