



1945

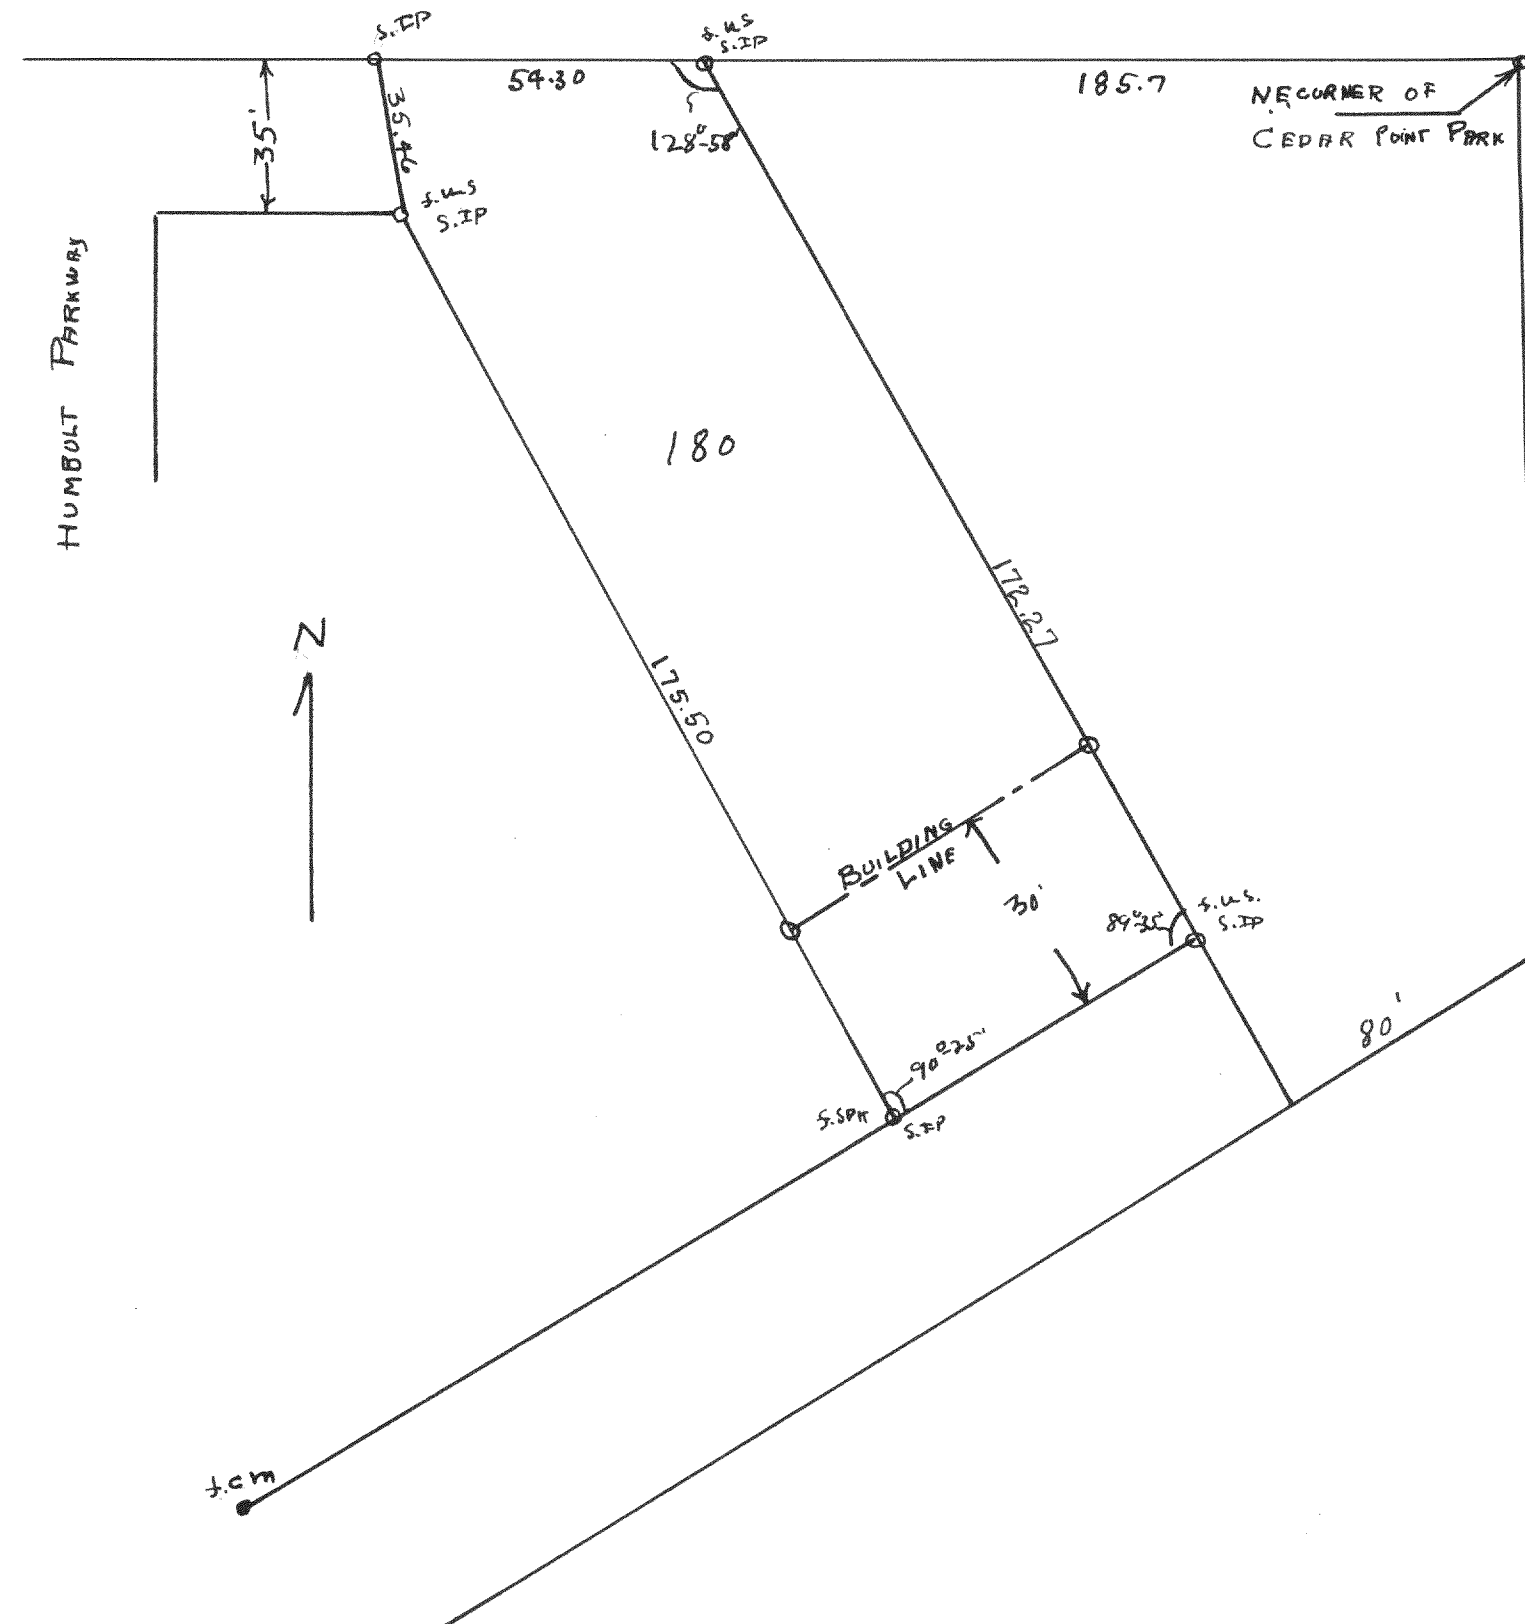

Plot of survey of Lot 180 Cedar Point Park Original Plot in the Village of Williams Bay
November 18, 1998

Floyd & Jensen
County Surveyor
FJS

1946

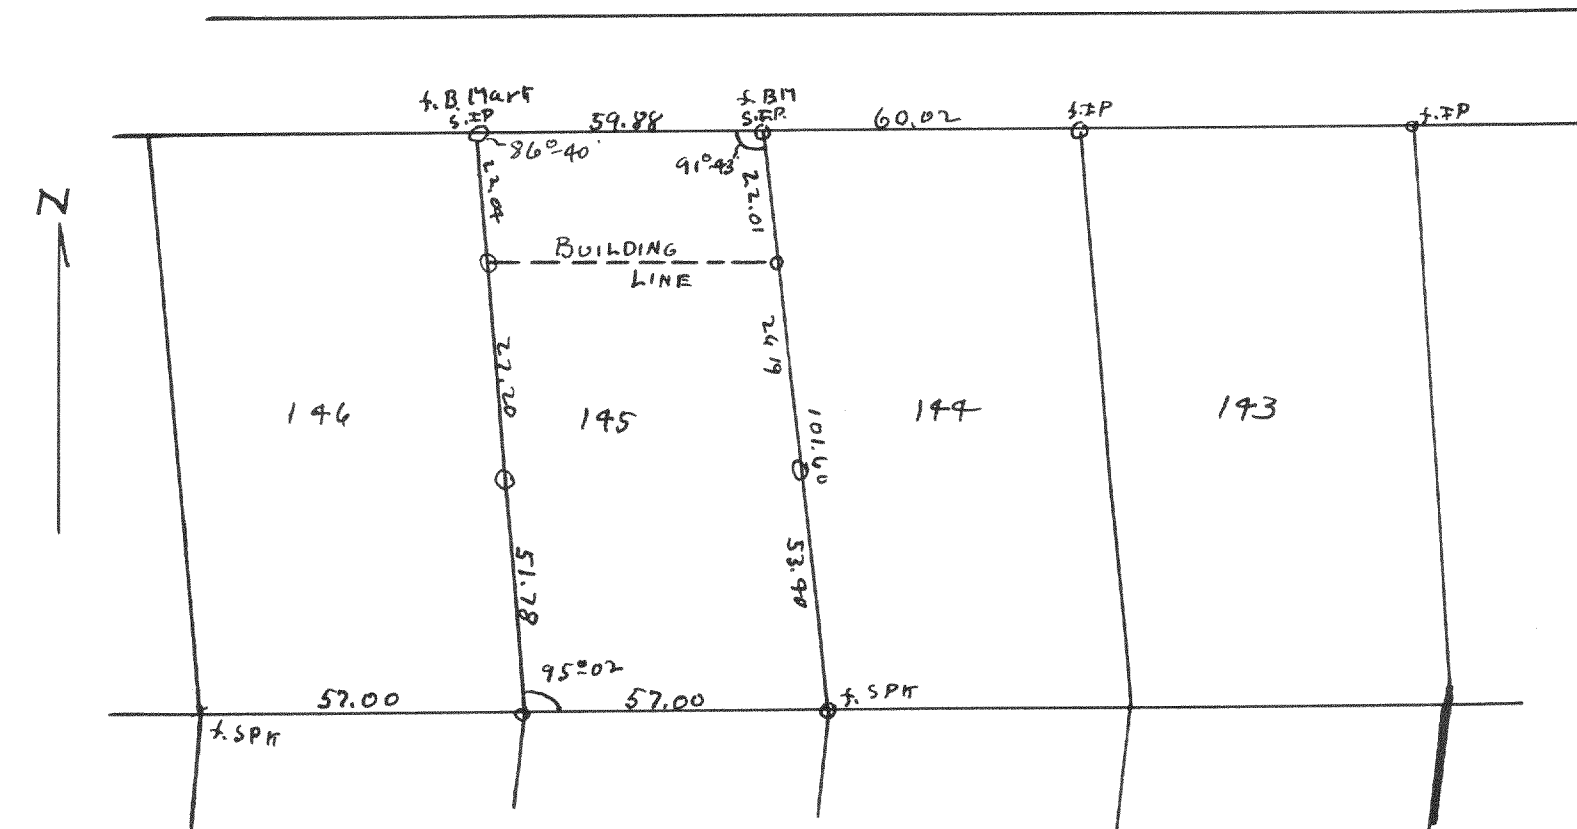

Plot of survey of lot 145 Cedar Point Park 2nd addition
in the Village of Williams Bay, Walworth County, Wisconsin
Sept 1998

Floyd & Jensen
County Surveyor
FJS