



394

1964

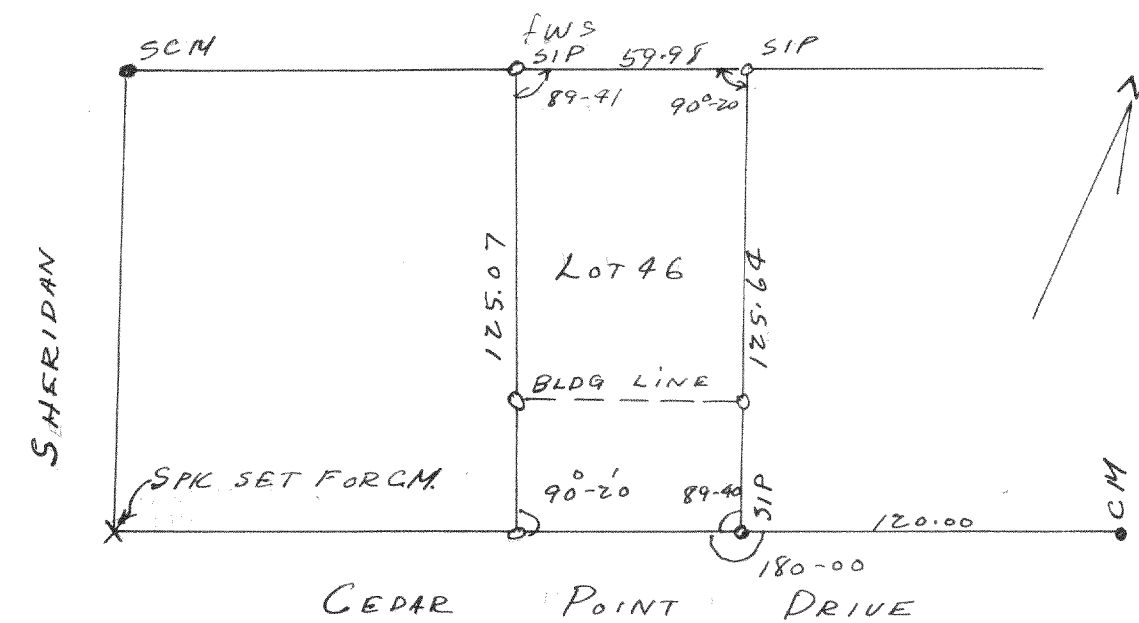


Plot of Survey of Lot 46 Cedar Point Park
Village of Williams Bay, Walworth County
1948
Floyd L. Jensen
CWS

1966

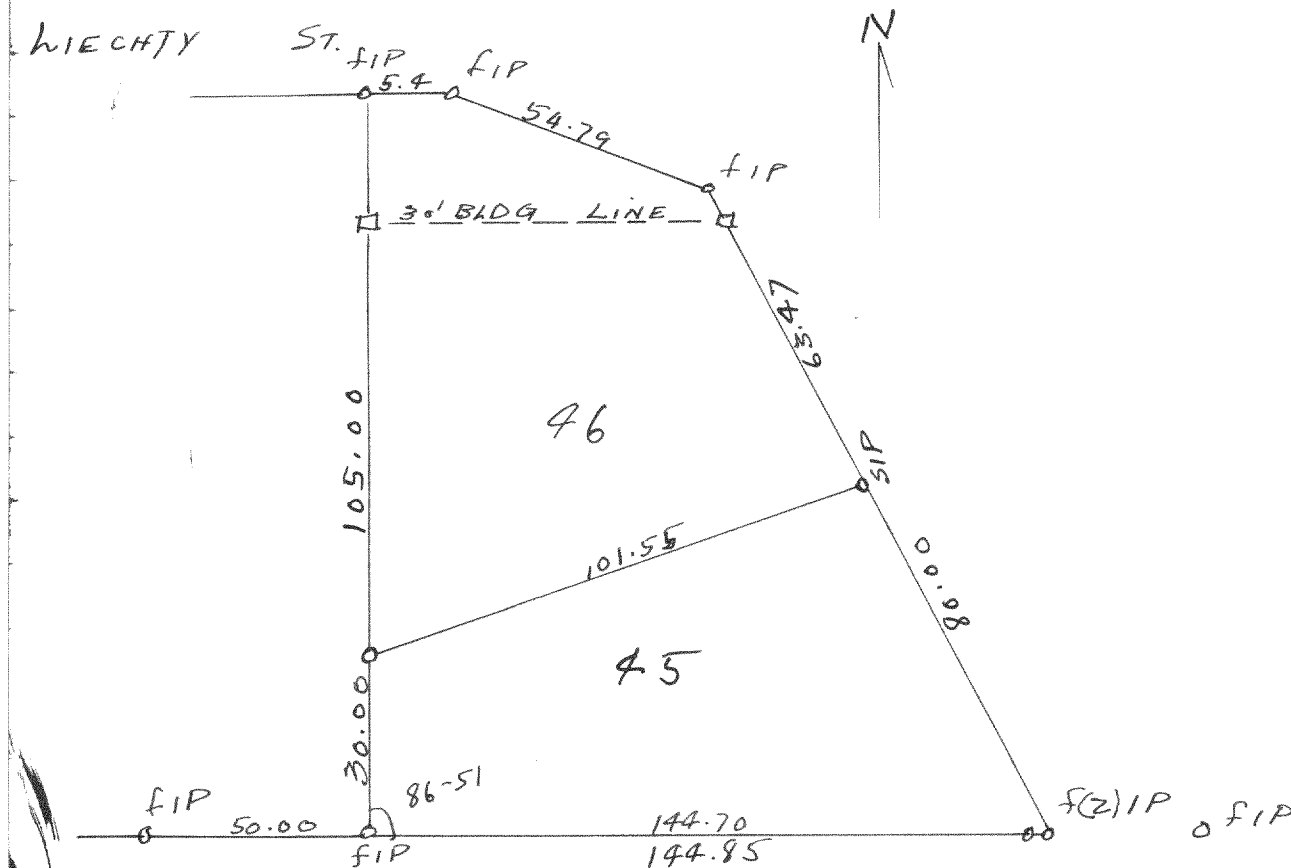


Plot of Survey of lots 45 & 46 Summer Haven Subd
Village of Williams Bay, Walworth County
1948
Floyd L. Jensen
CWS

1965

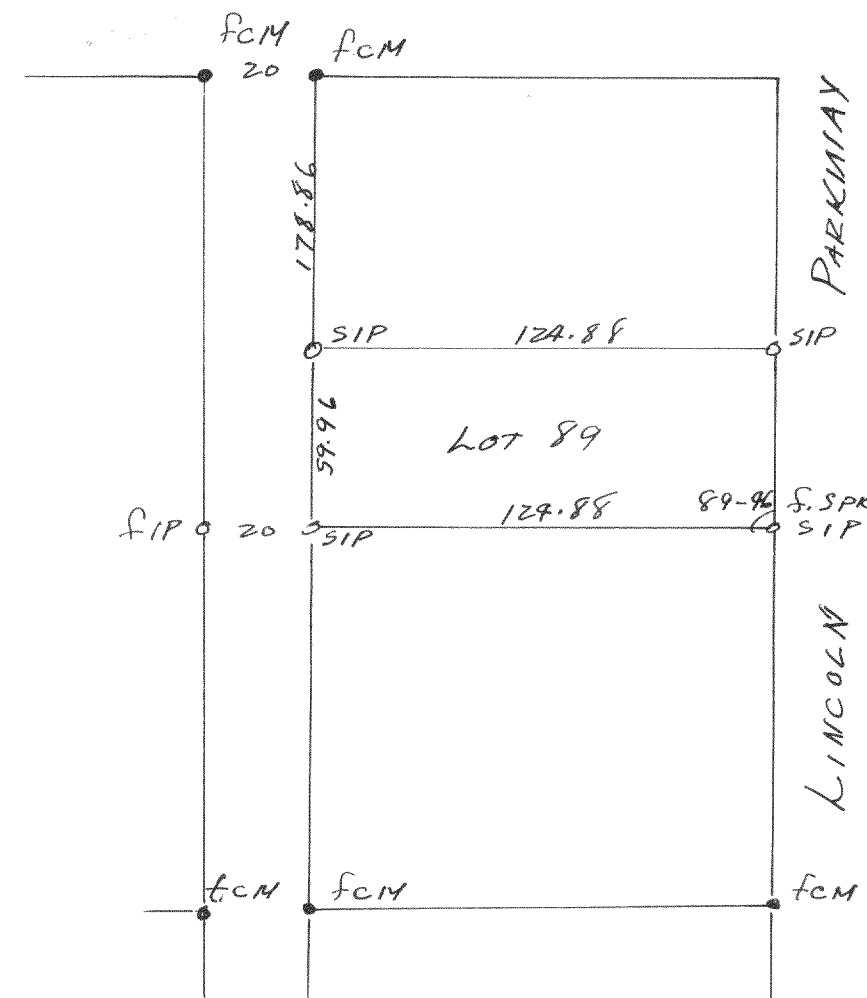

Plot of Survey of Lot 89, Cedar Point Park,
Village of Williams Bay, Walworth County
June 1948
Floyd L. Jensen
CWS

1967

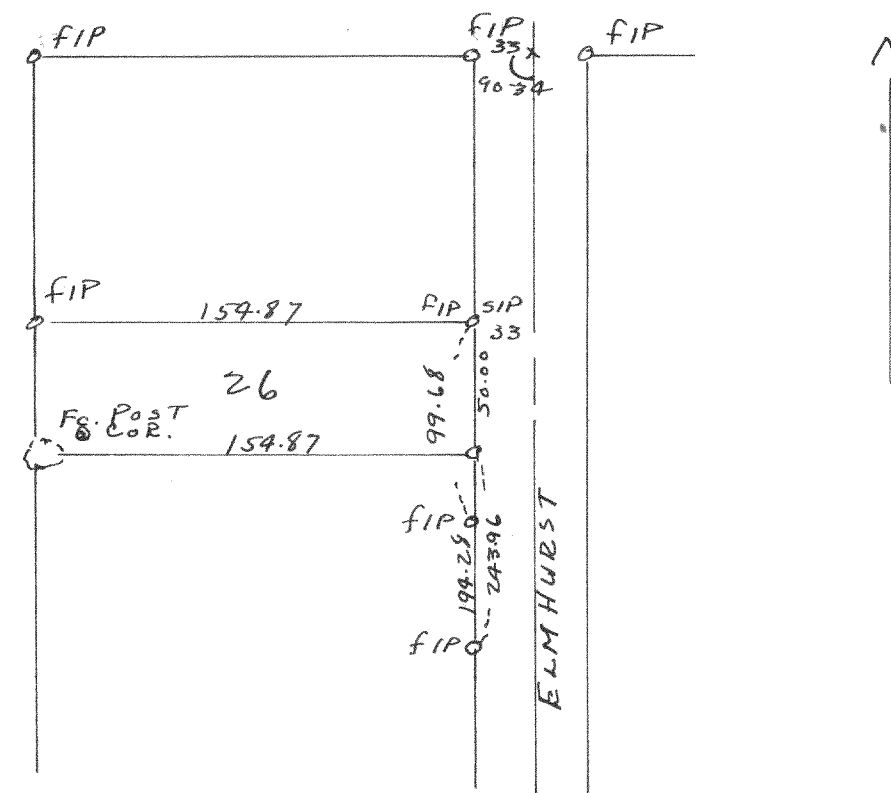

Plot of Survey of Lot 26 Block 1 of Stokes Subdivision
Village of Williams Bay, Walworth County
1948
Floyd L. Jensen
CWS