



1994

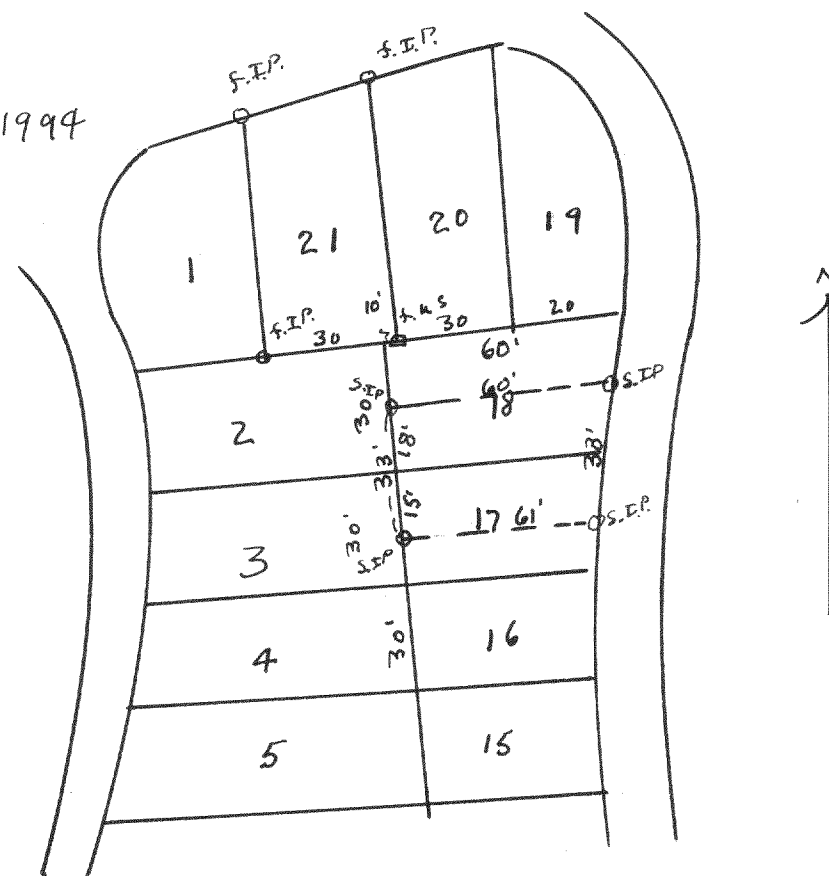

Plot of survey of the NW 1/4 T17 S 4th south 18' of lot 18 in
Block O assembly Park on Delavan Lake located in
Section 21 T2N R16E of Walworth County, Wisconsin
July 17 1998
Lloyd L Jensen

Lloyd L Jensen
County Surveyor
~~212~~

1995

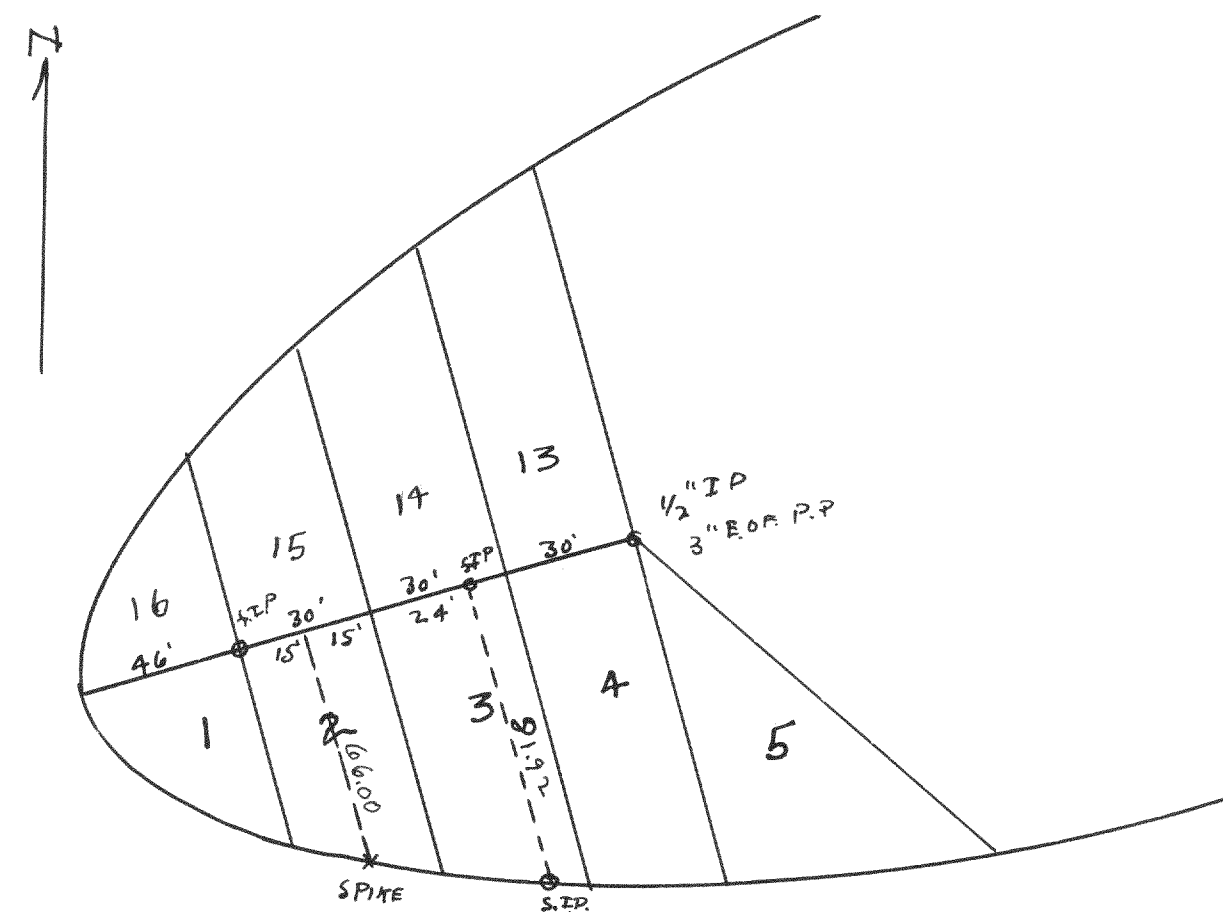

Plot of survey of 15' of lot 2, 24' of lot 3, Block "M" in Assembly
Park subdivision located in Section 21 T2N914E Malmouth County Wisconsin
July 17, 1948
Hoyt S Jensen

Lloyd S Jensen
County Surveyor
