



2021

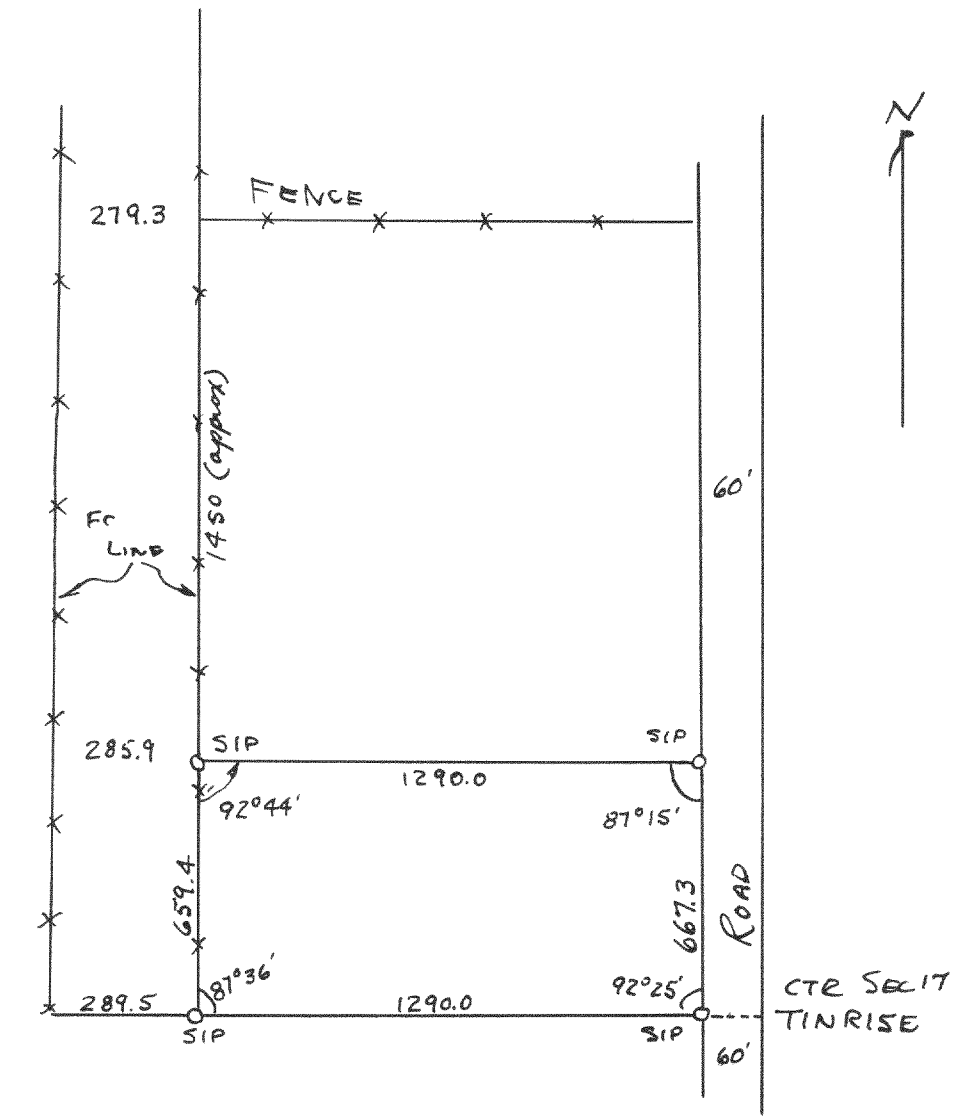

Plat of survey of a parcel of land located in the
S 1/2 of the SE 1/4 of the NW 1/4 Section 17, T1N R1E
Aug 16, 1949
Lloyd L. Jensen
County Surveyor
903

2022

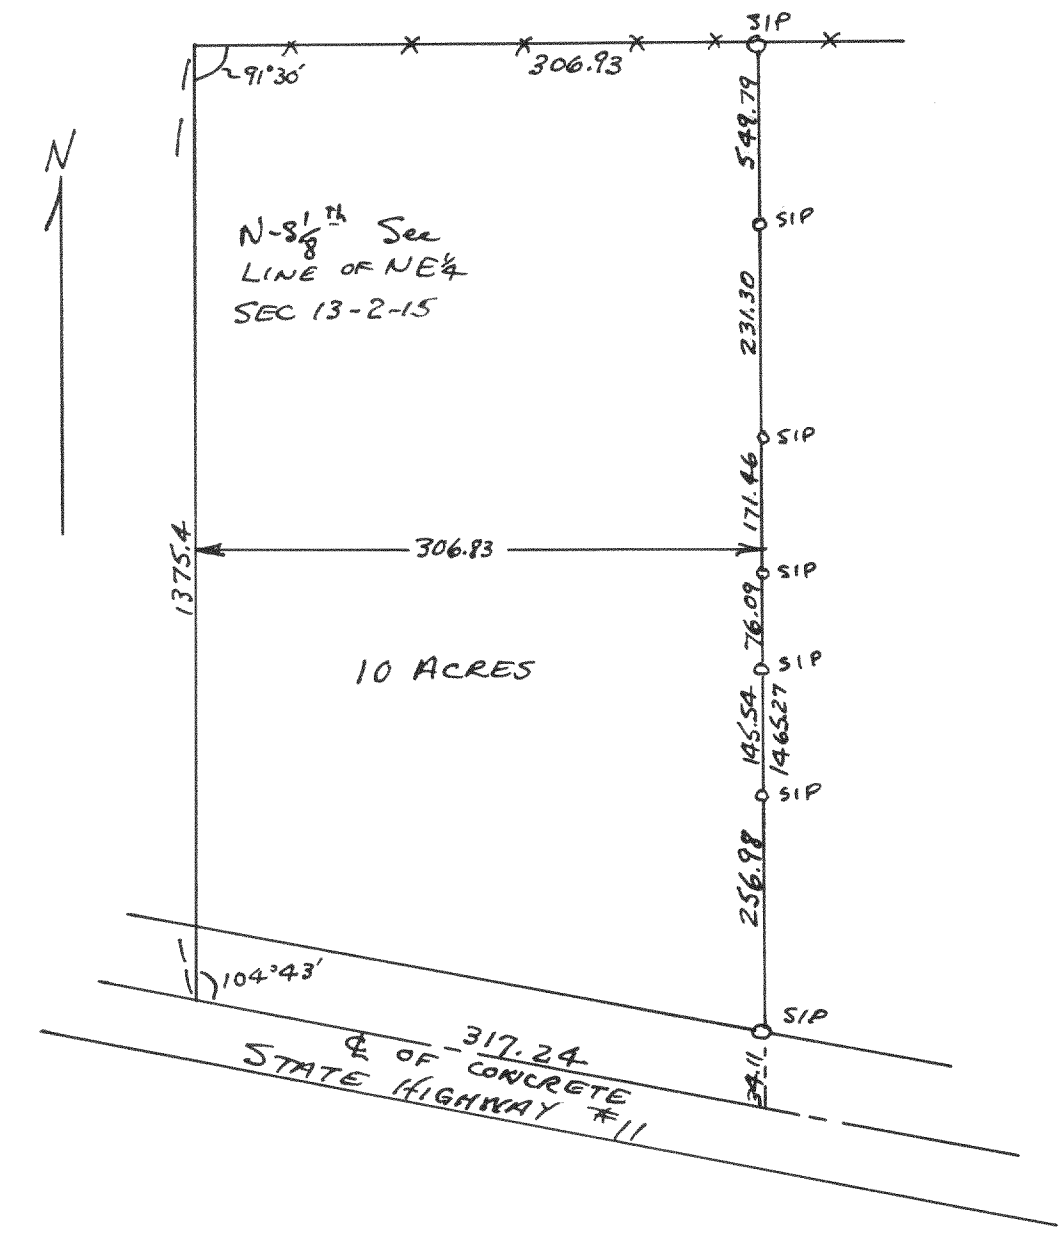

Plat of survey of a 10Acre parcel of land located in
the NE 1/4 of Section 13, T2N R1E
1949
Lloyd L. Jensen
County Surveyor
903