



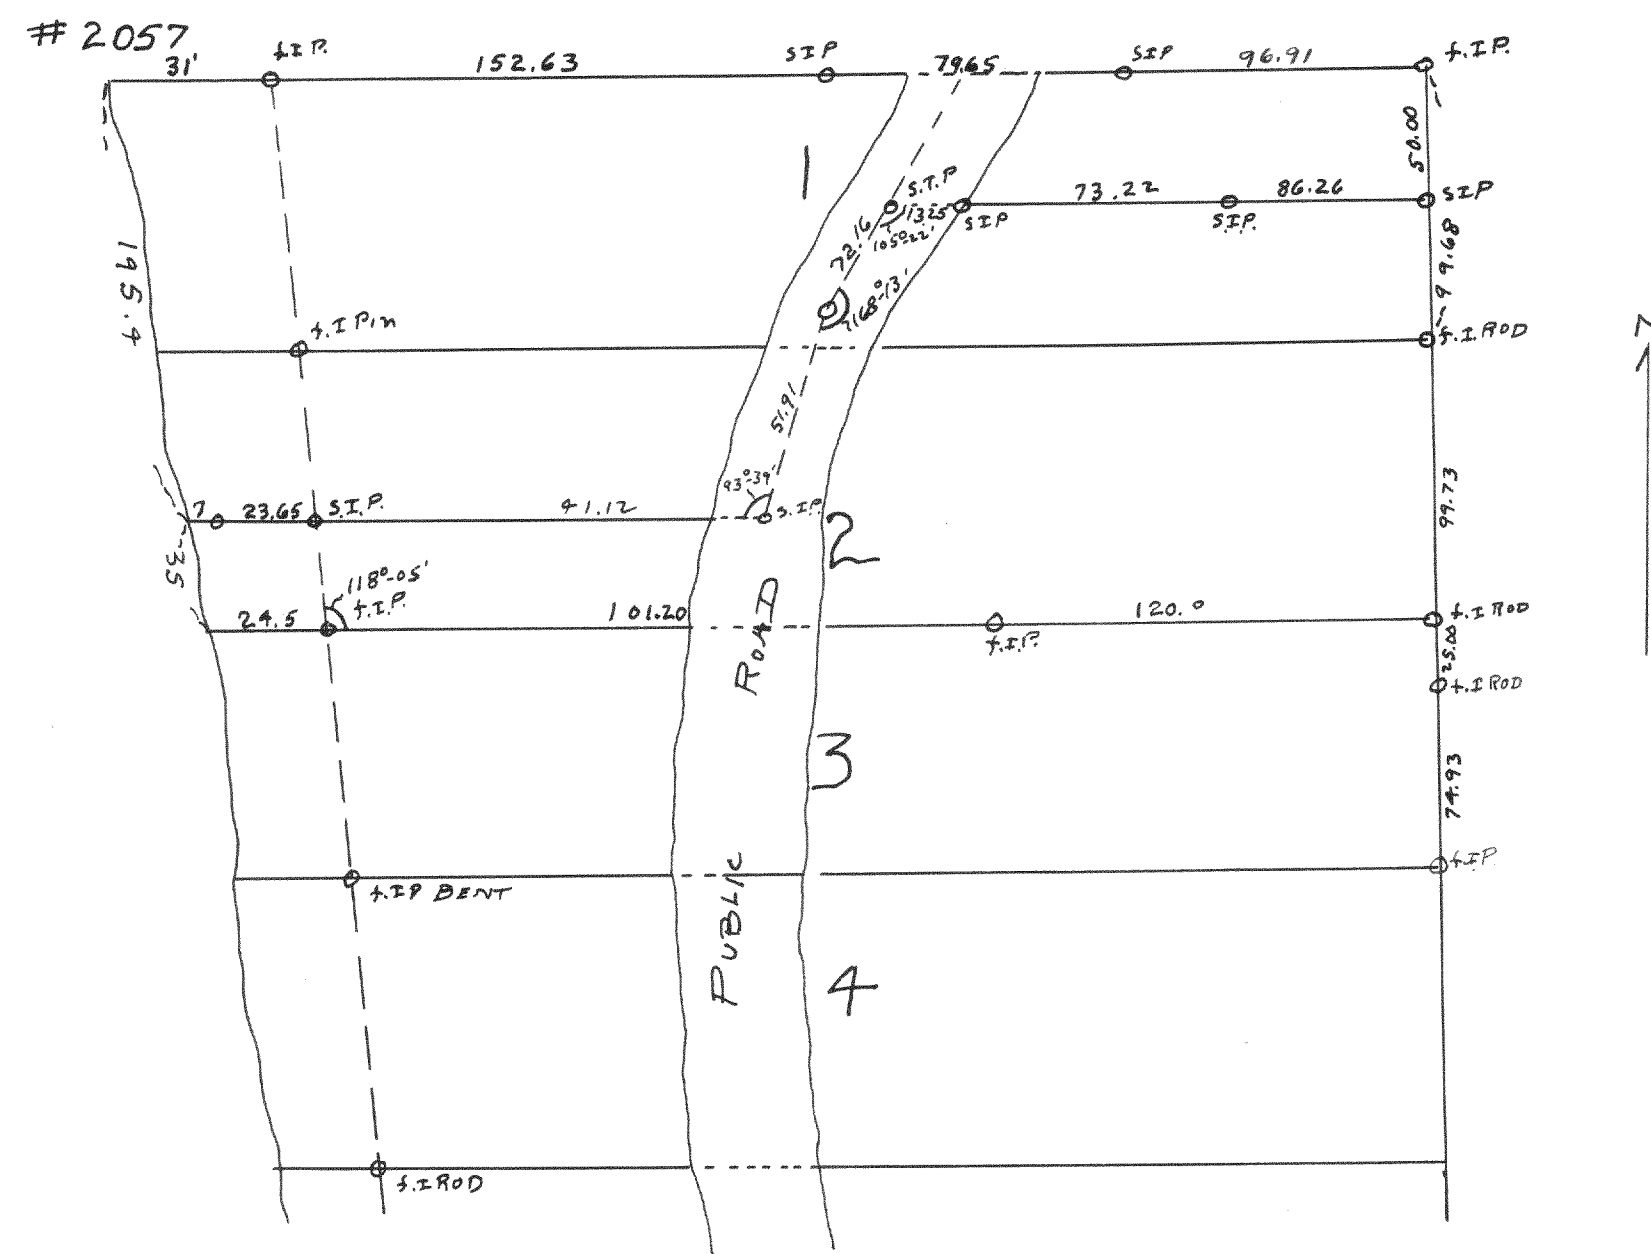

Plot of survey of the division of lots 1 & 2 in Sunset Park
Subdivision located in Section 13 T4N R17E Walworth County
May 28, 1949
Lloyd I Jensen *sd*
County Surveyor

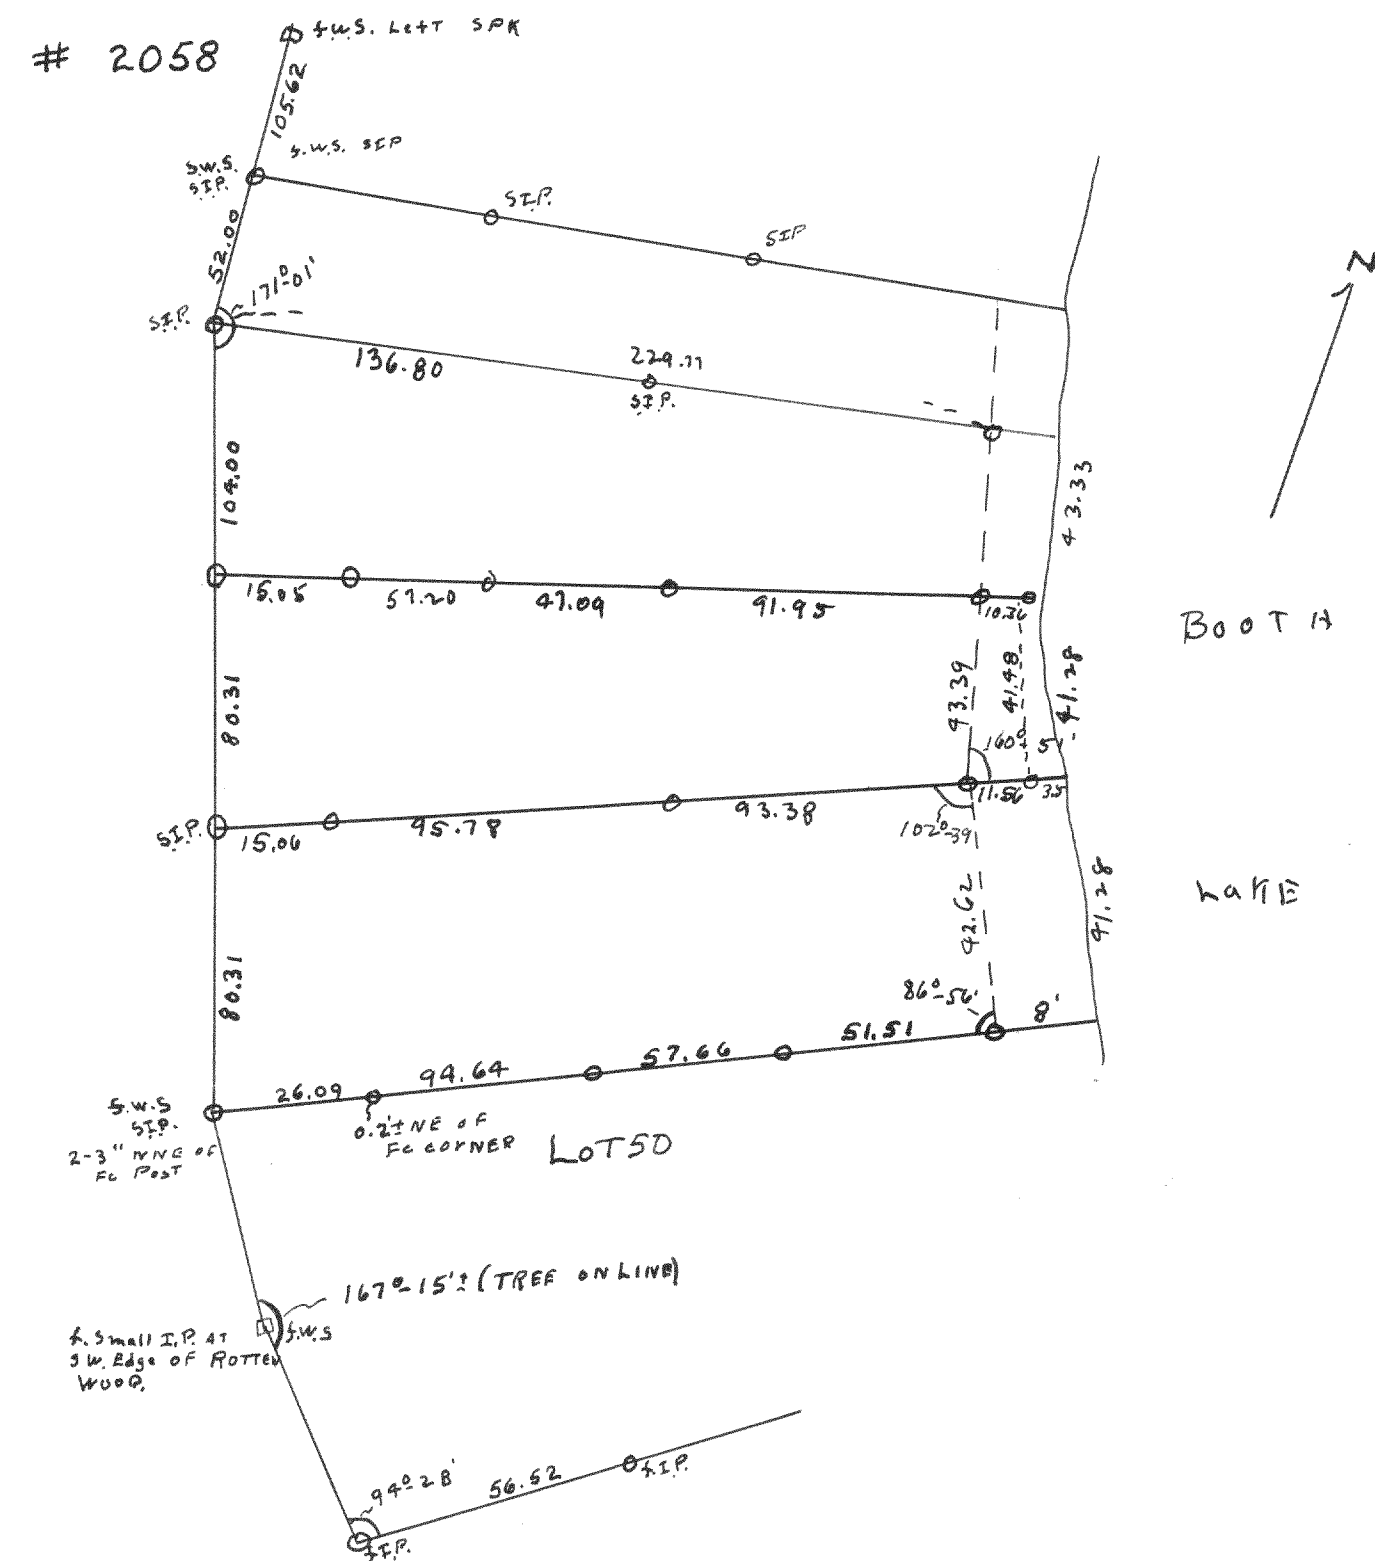

Plot of survey of land between lots 46 & 50 Booth Lake Heights
located in Section 24, T4N R17E Walworth County
July 27, 1949
Lloyd I Jensen *sd*
County Surveyor