



#2065

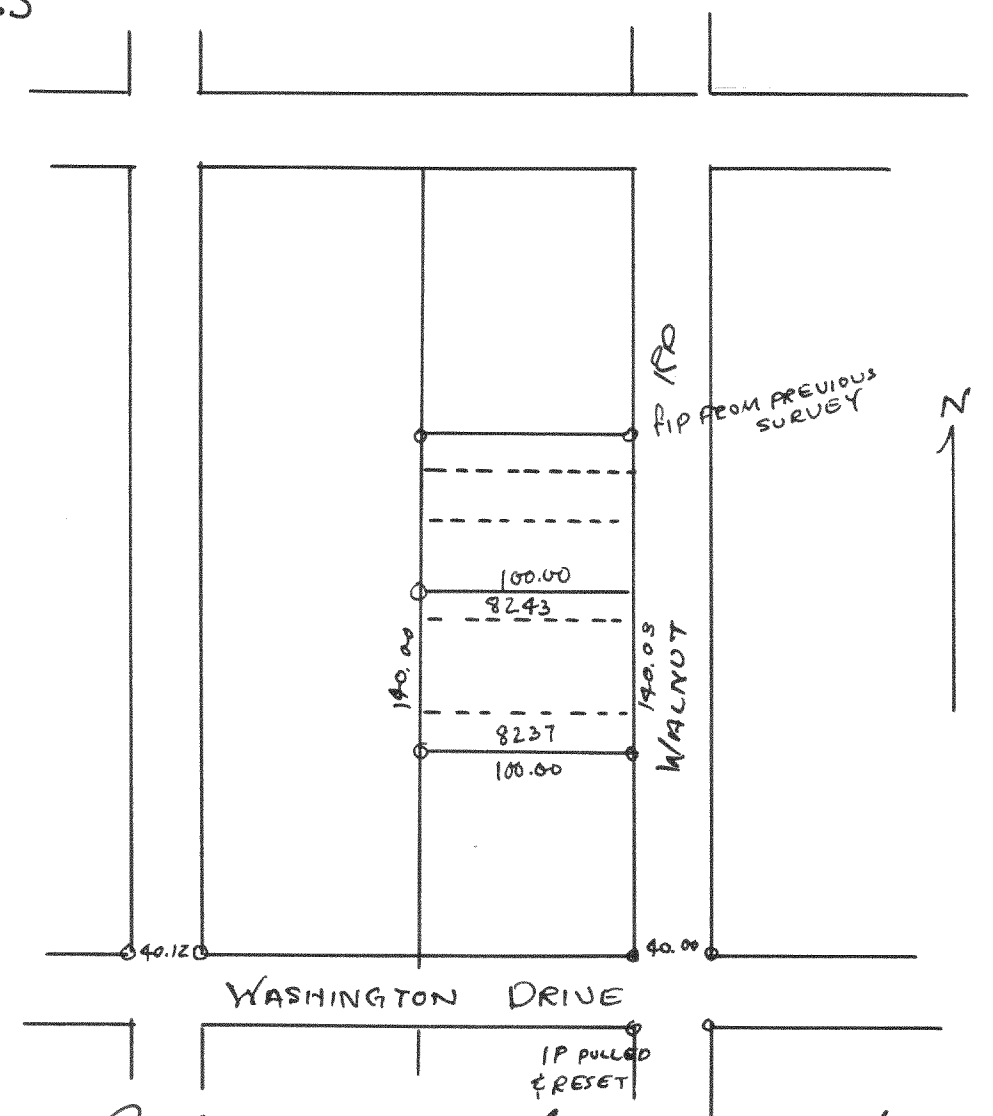


Plat of survey of lots 8237-8243 Lake Como Beach Subd.
located in Section 21 & 22 T2N R17E
April 18, 1949
Floyd S. Jensen
County Surveyor

#2067

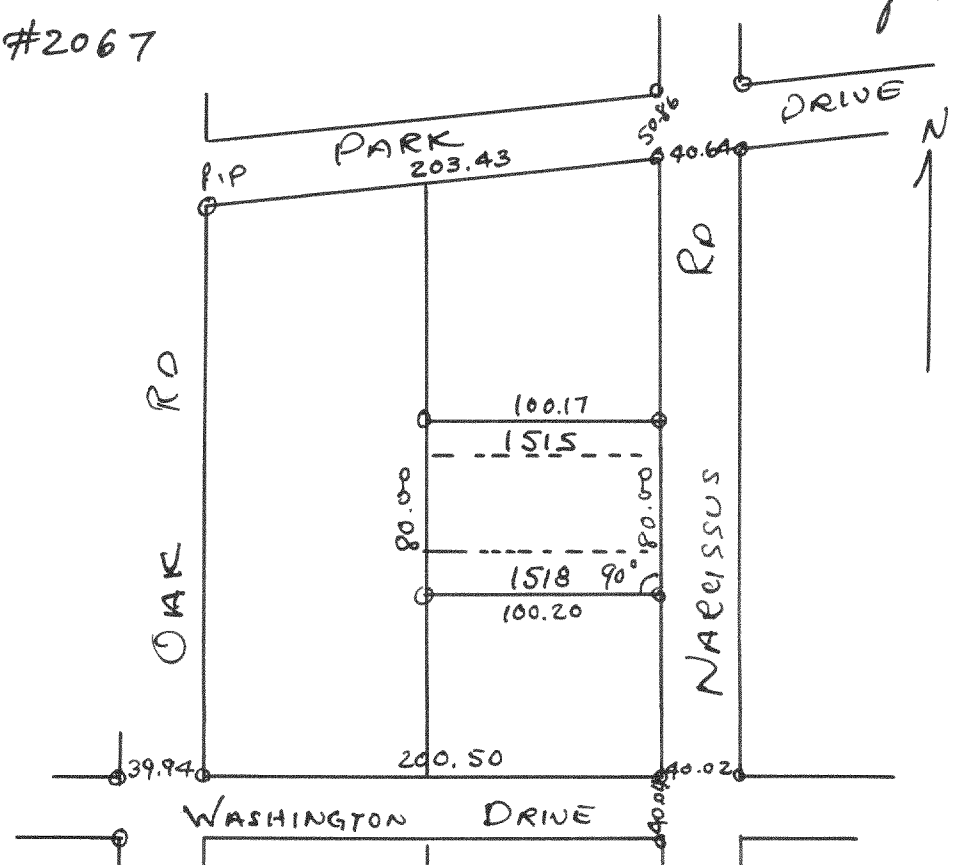


Plat of survey of lots 1515-1518 Lake Como Beach Subd.
June 2, 1949
Floyd S. Jensen
County Surveyor

#2066

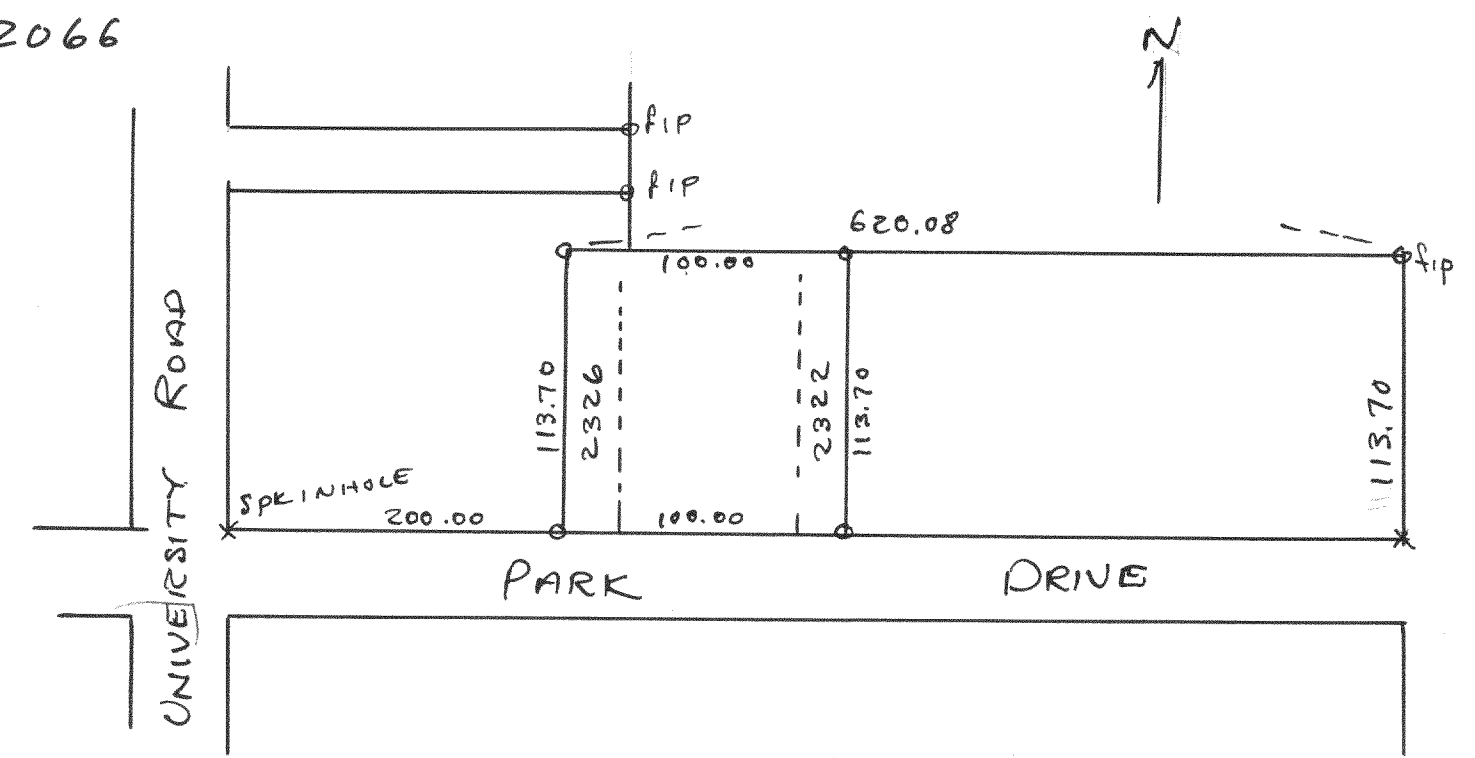

Plat of survey of lots 2322-2326 Lake Como Beach Subd.
located in Sec 21 & 22 T2N R17E Walworth County, Wis.
May 11, 1949
Floyd S. Jensen
County Surveyor

#2068

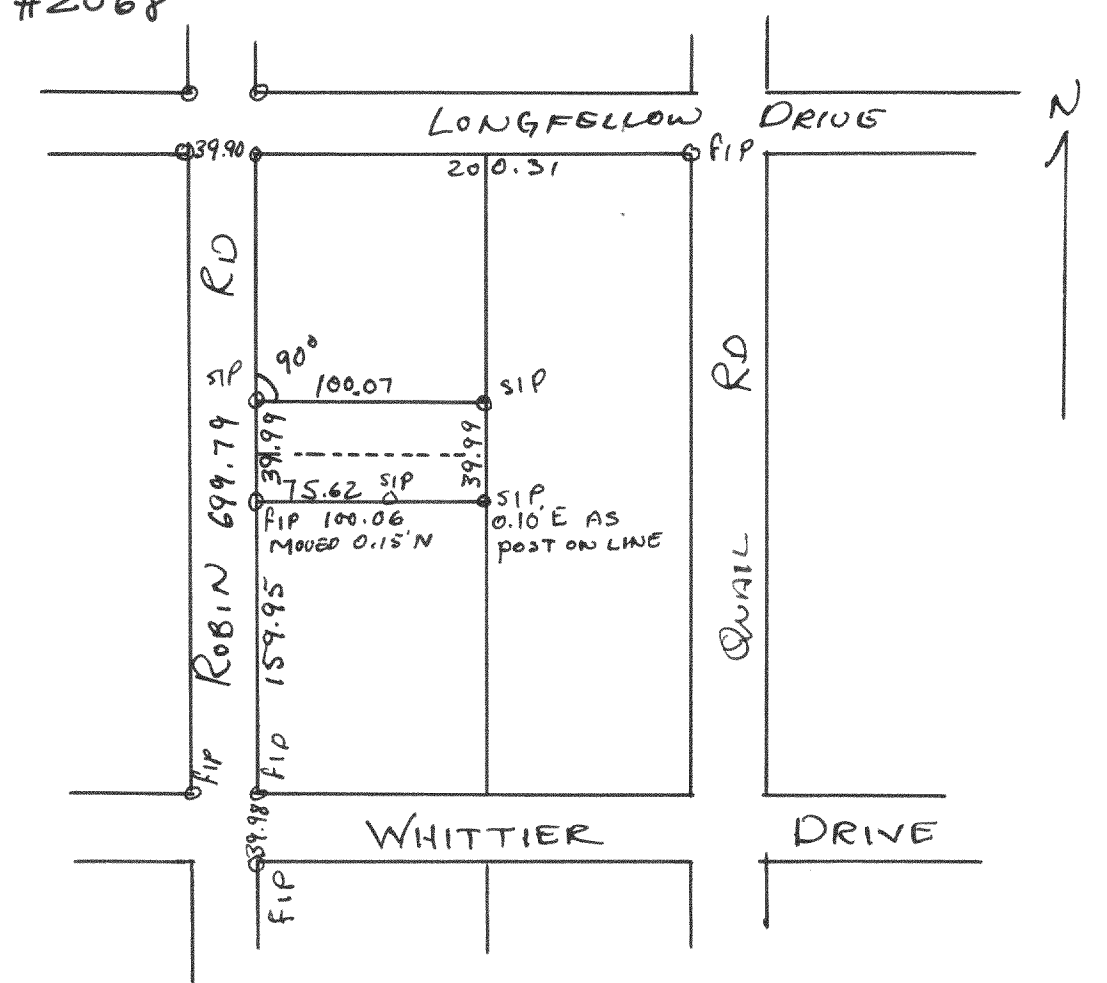

Plat of survey of lots 8159 & 8160 Lake Como Beach Subd located
in Sec 21 & 22 T2N R17E
1949
Floyd S. Jensen
County Surveyor