



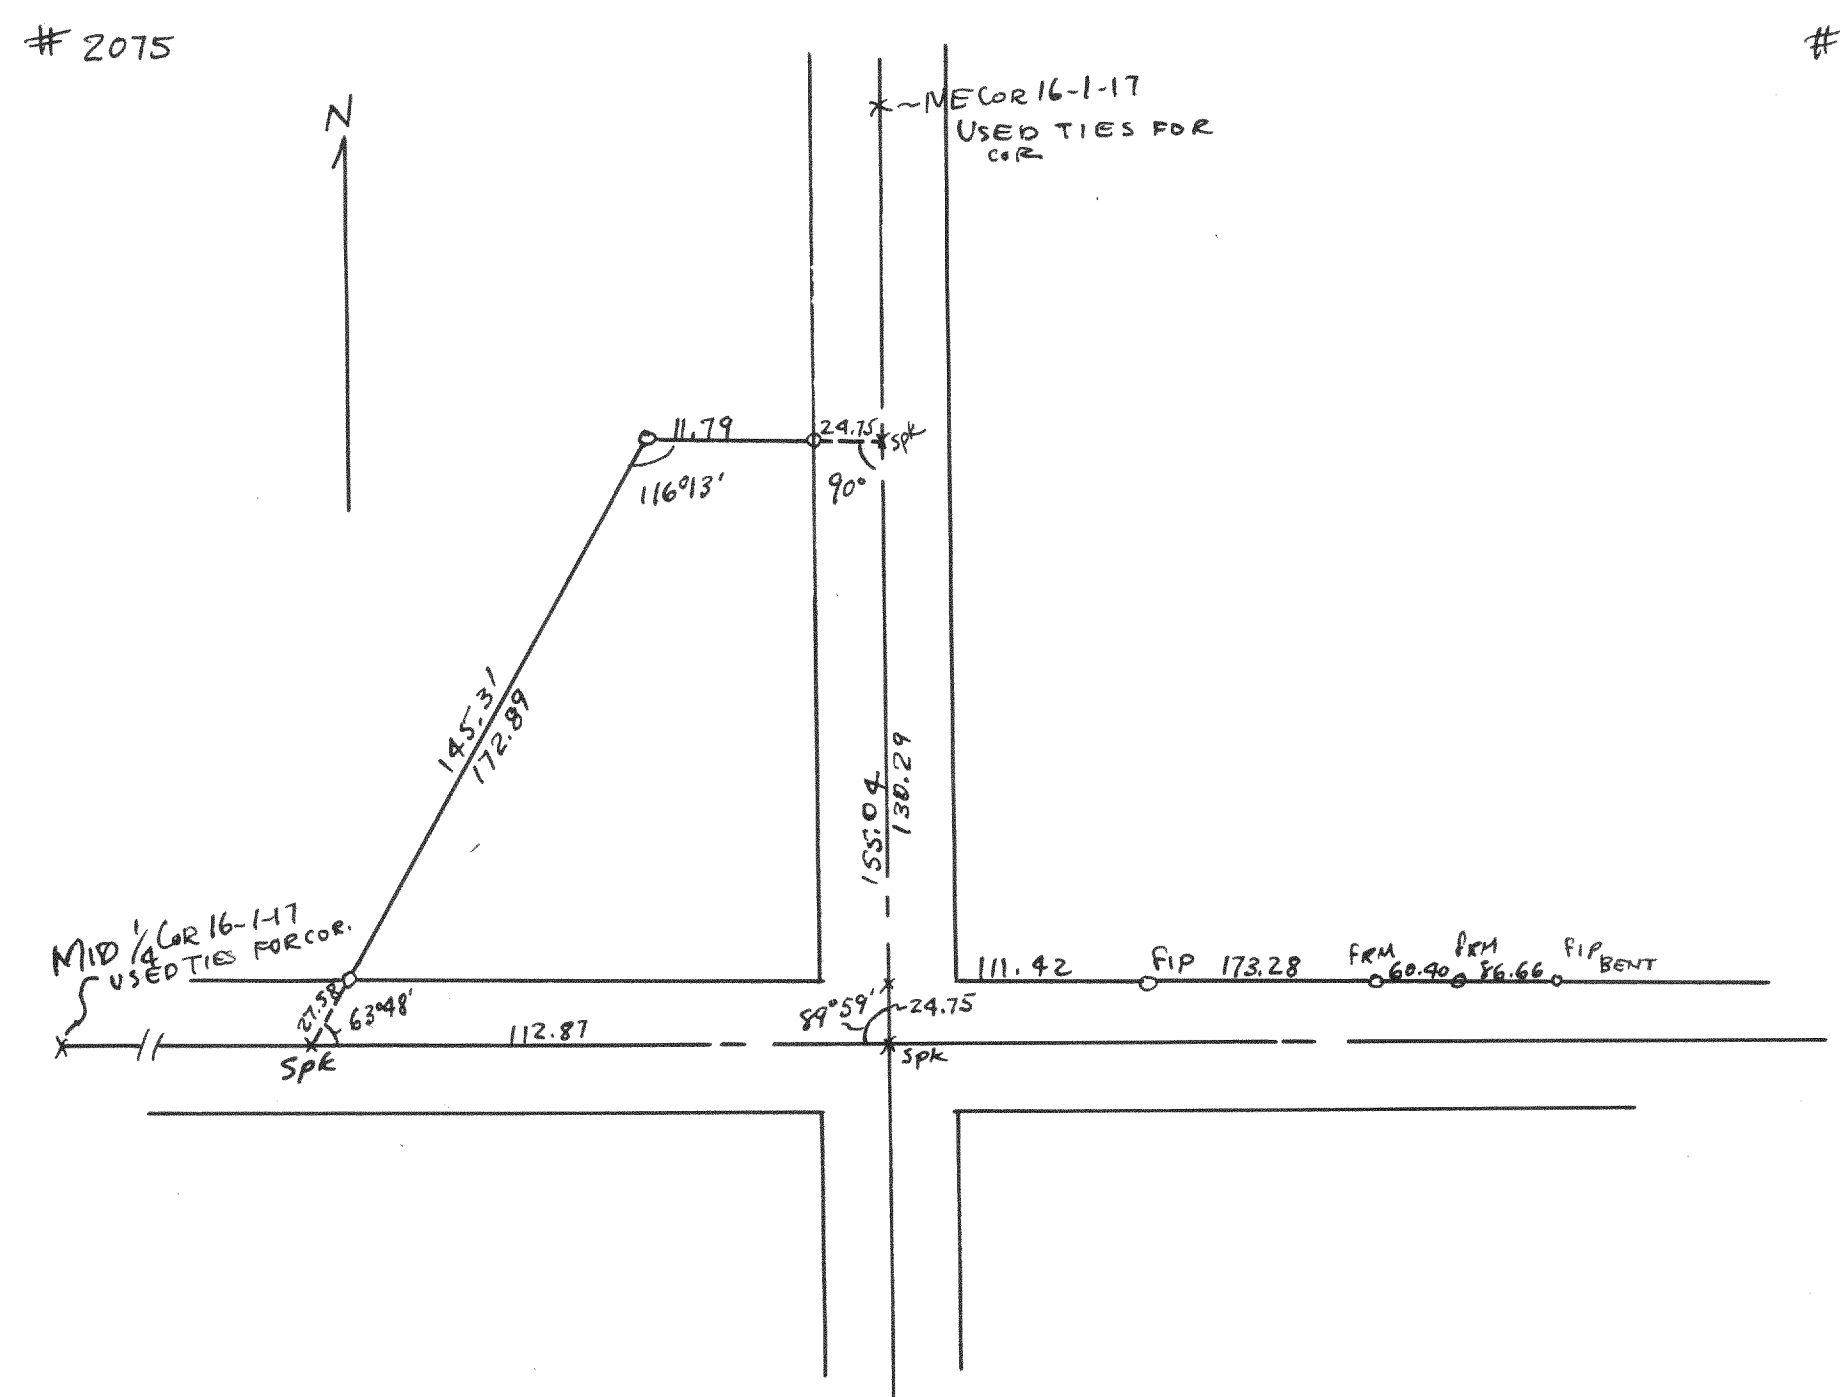

Plat of survey of a parcel of land located in the NE 1/4 of Sec. 16
T1N R17E of Walworth Cty., Wisc.
June 24, 1949
Lloyd L. Jensen
County Surveyor

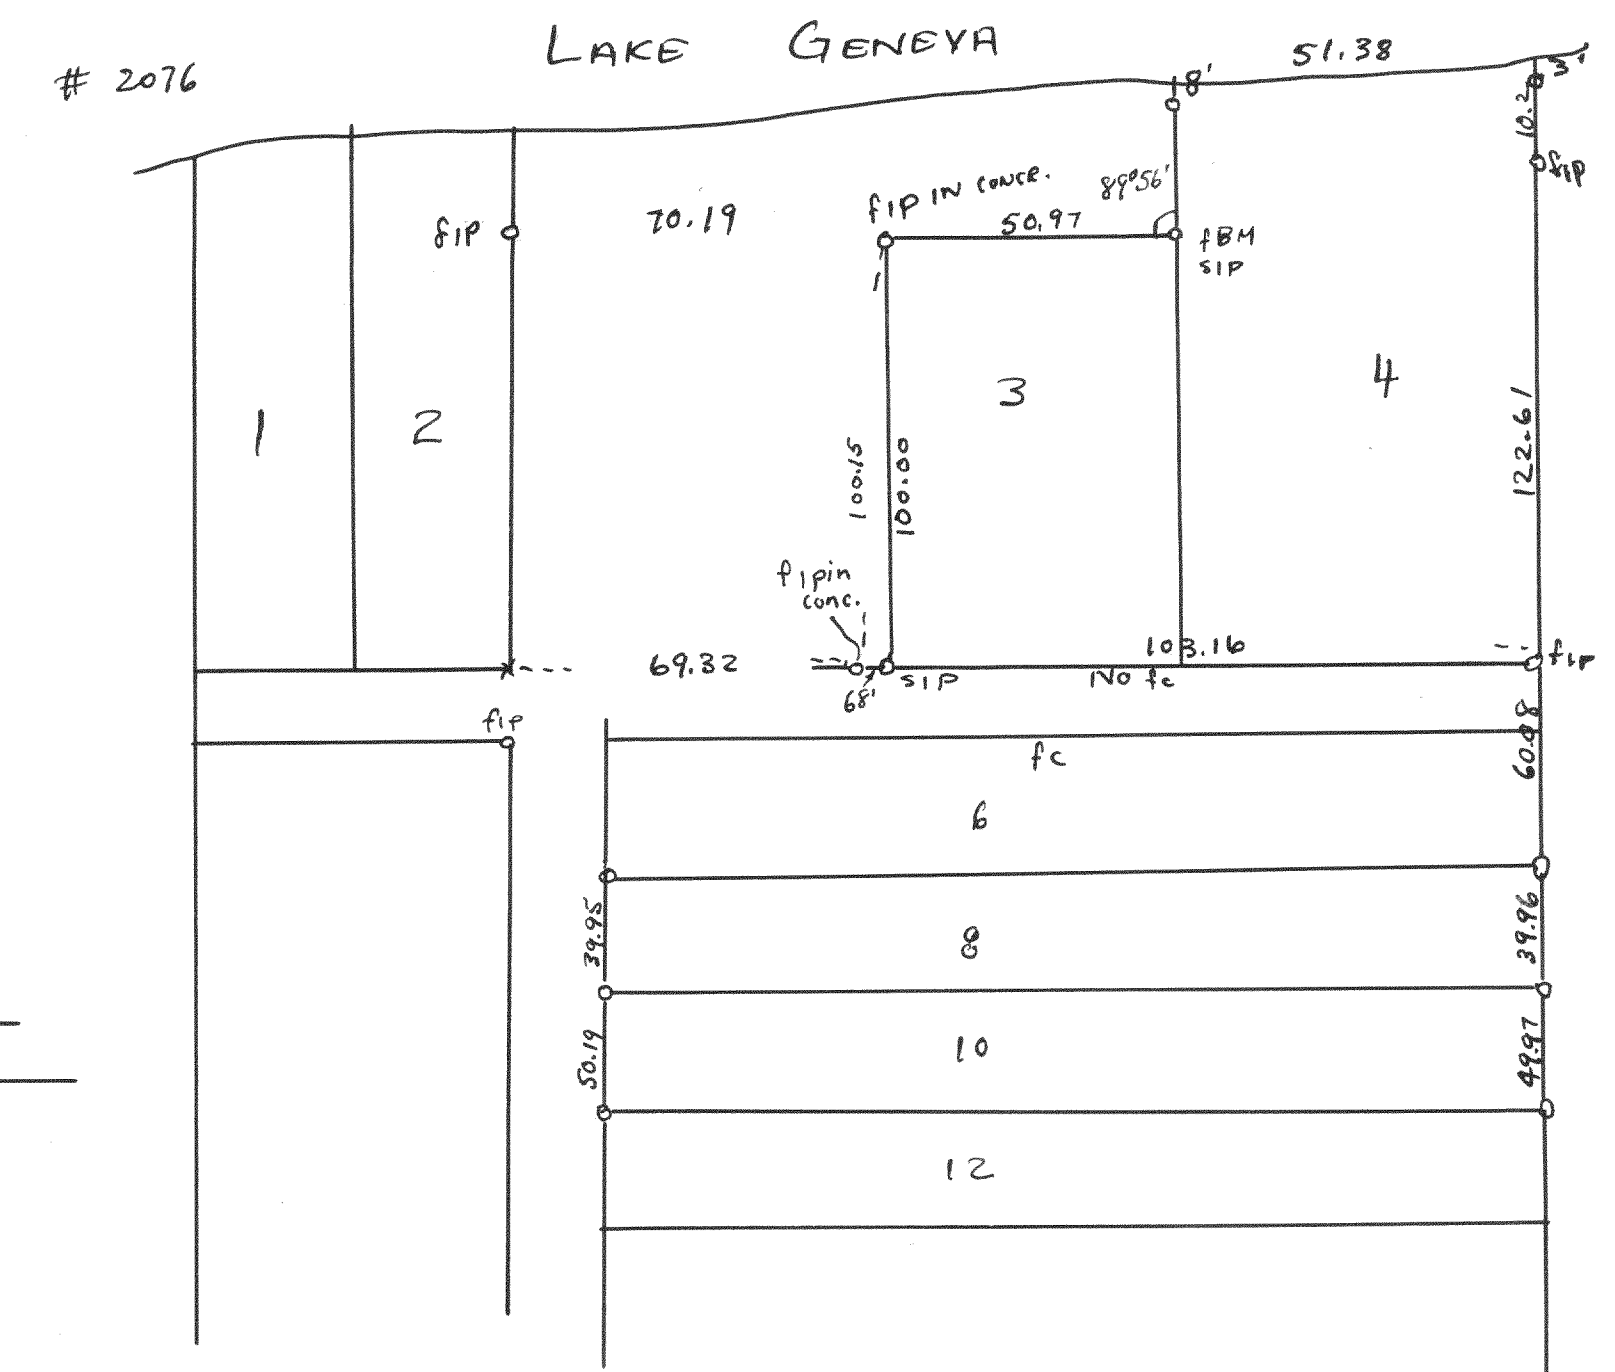

Plat of survey of lots 3 & 4 of Shore Haven Subd.
located in the NE 1/4 Sec. 18 T1N R17E Walworth, Wisc.
June 26, 1949
Lloyd L. Jensen
County Surveyor