



*2094

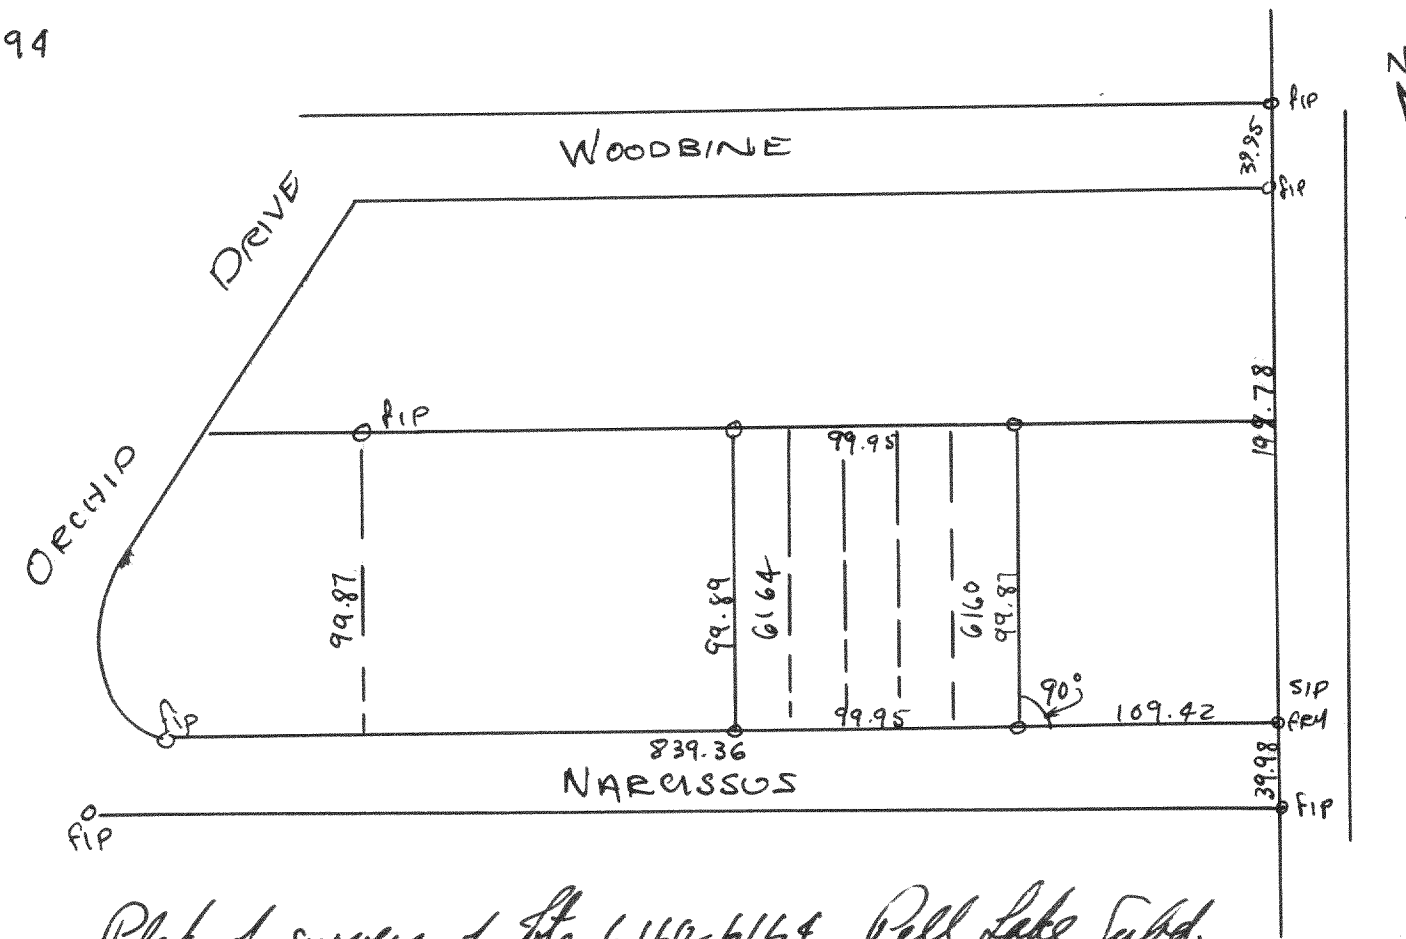

Plat of survey of Lts 6160-6164 Bell Lake Subd.
TINITE, Walworth Co., Wisconsin
Aug 30, 1949
Floyd S. Jensen
County Surveyor

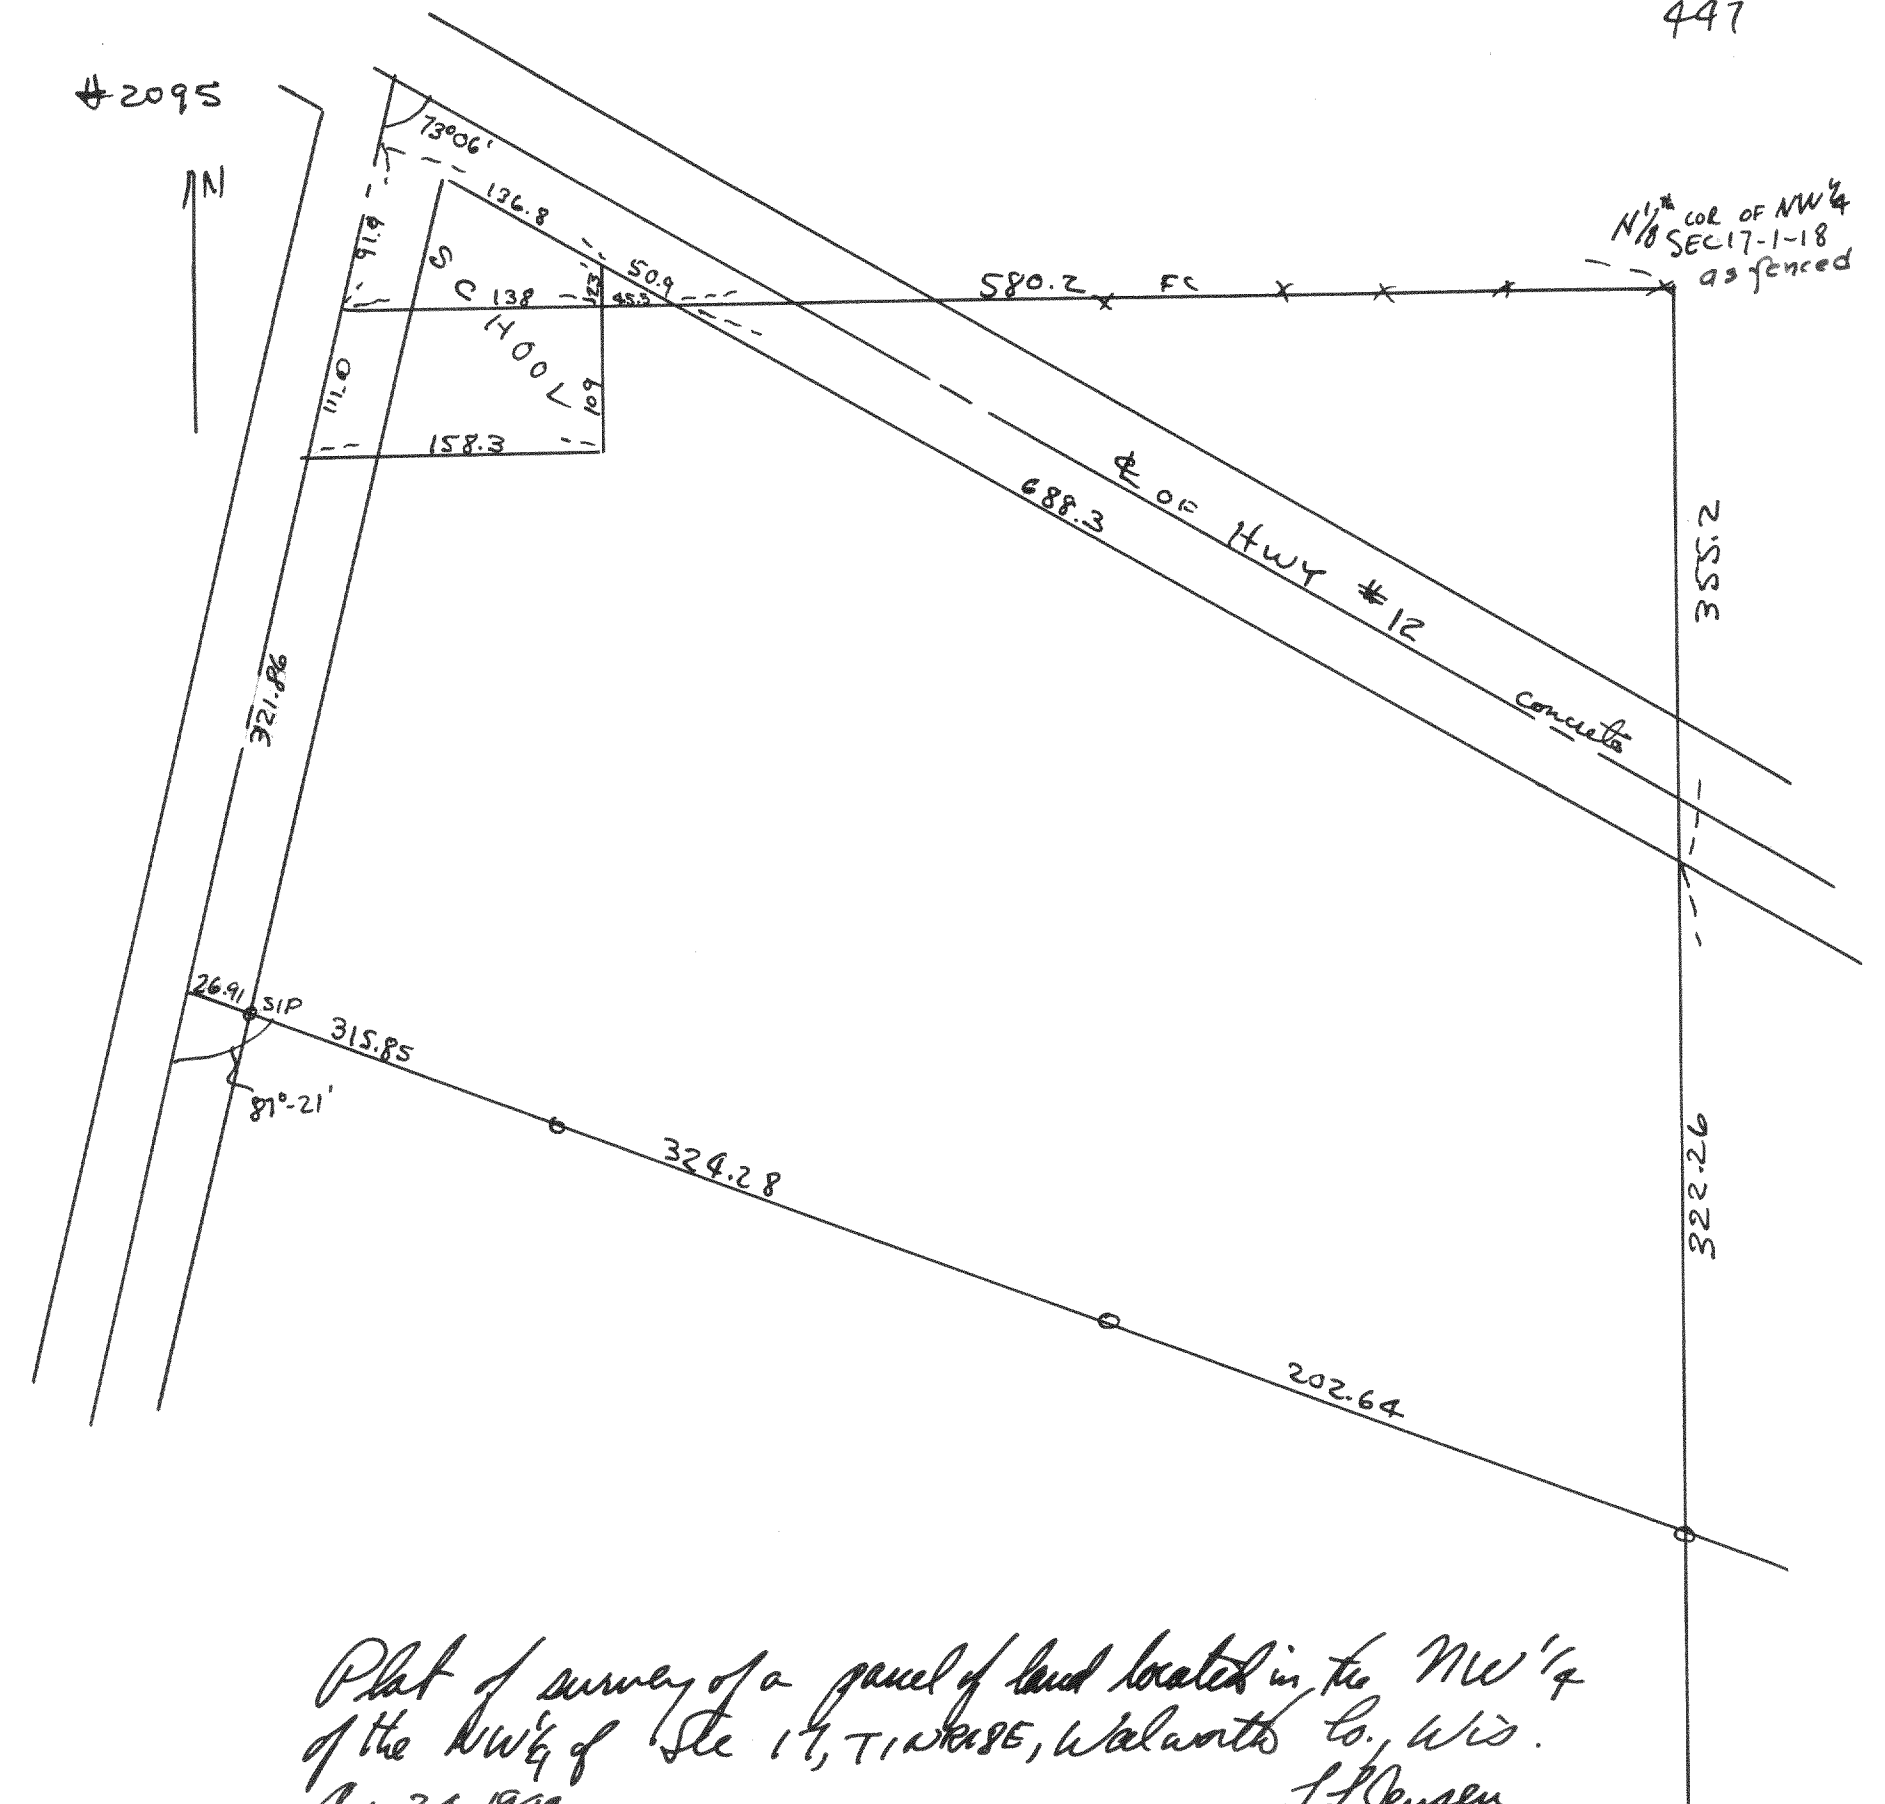

Plat of survey of a parcel of land located in the NW 1/4
of the NW 1/4 of Sec 17, T12N R8E, Walworth Co., Wis.
Aug 24, 1949
L. Jensen
County Surveyor