



#2116

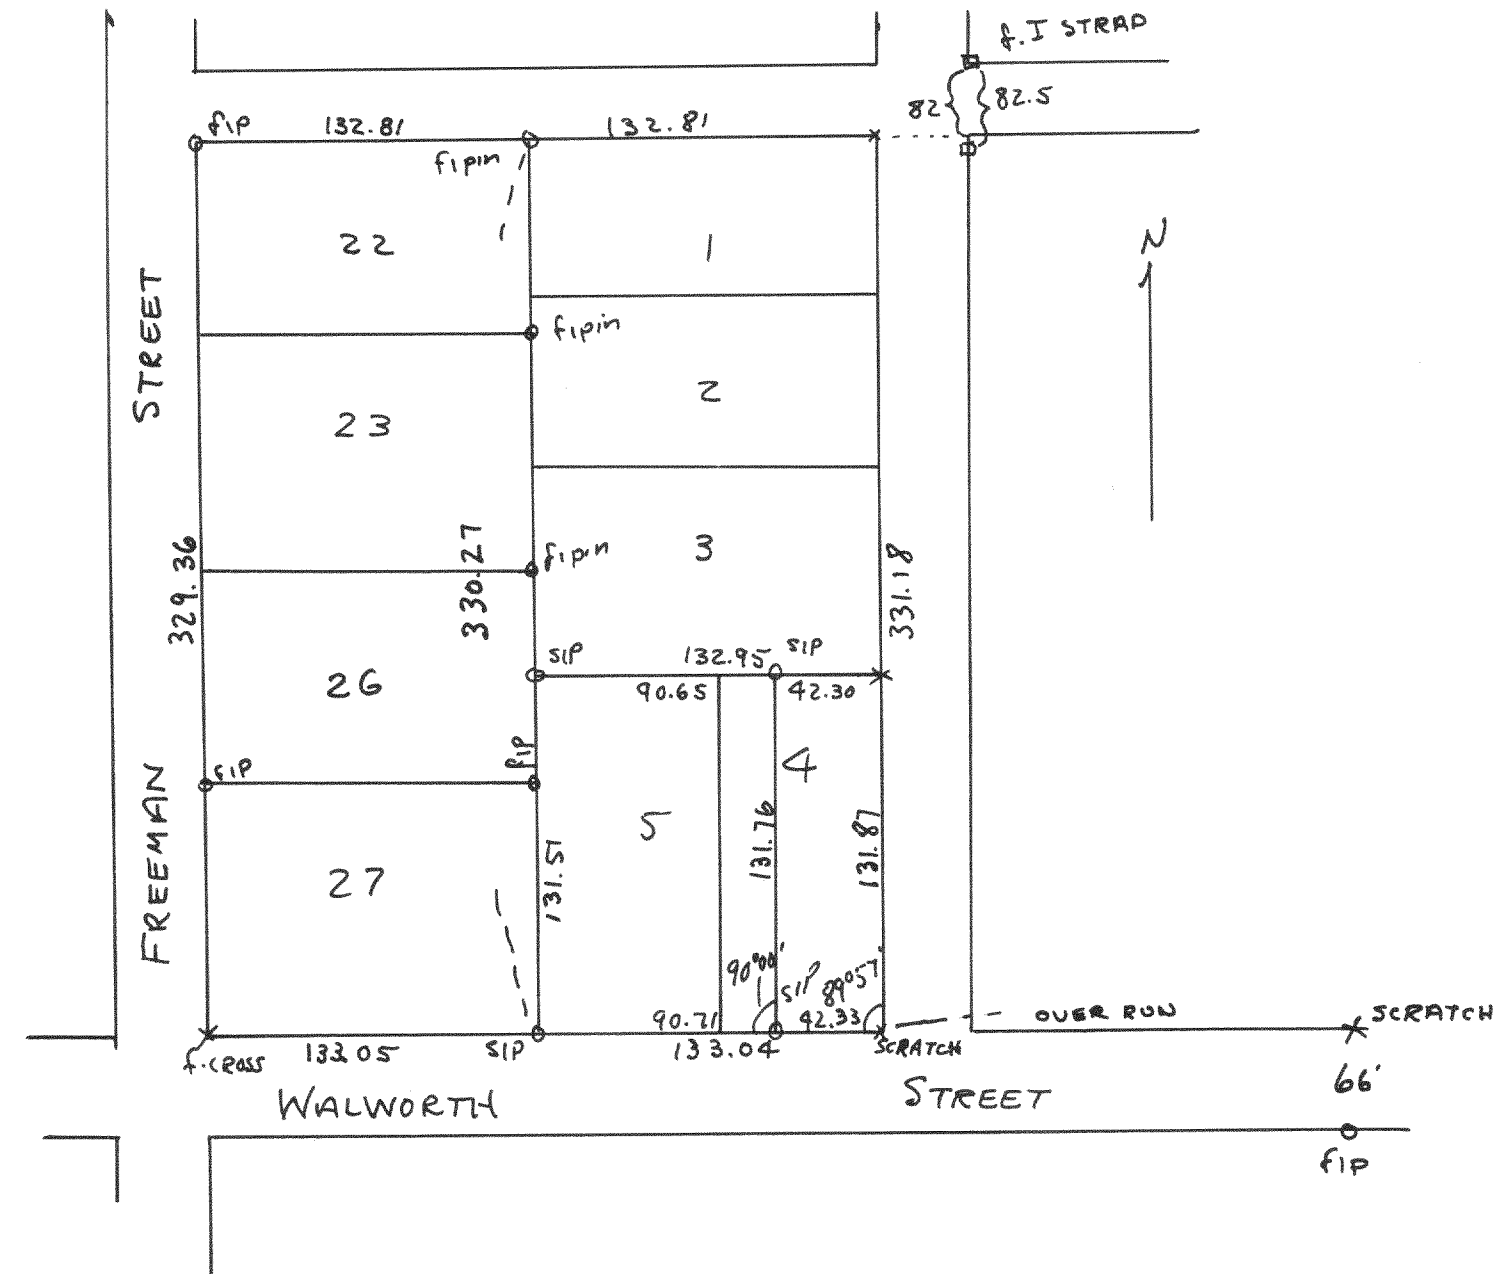

Plat of survey of part of lots 4 & 5 of Block 8 of
Freeman's 2nd Add. to Seneca City, Walworth County, Wis.
1949

Lloyd L. Jensen
County Surveyor

#2117

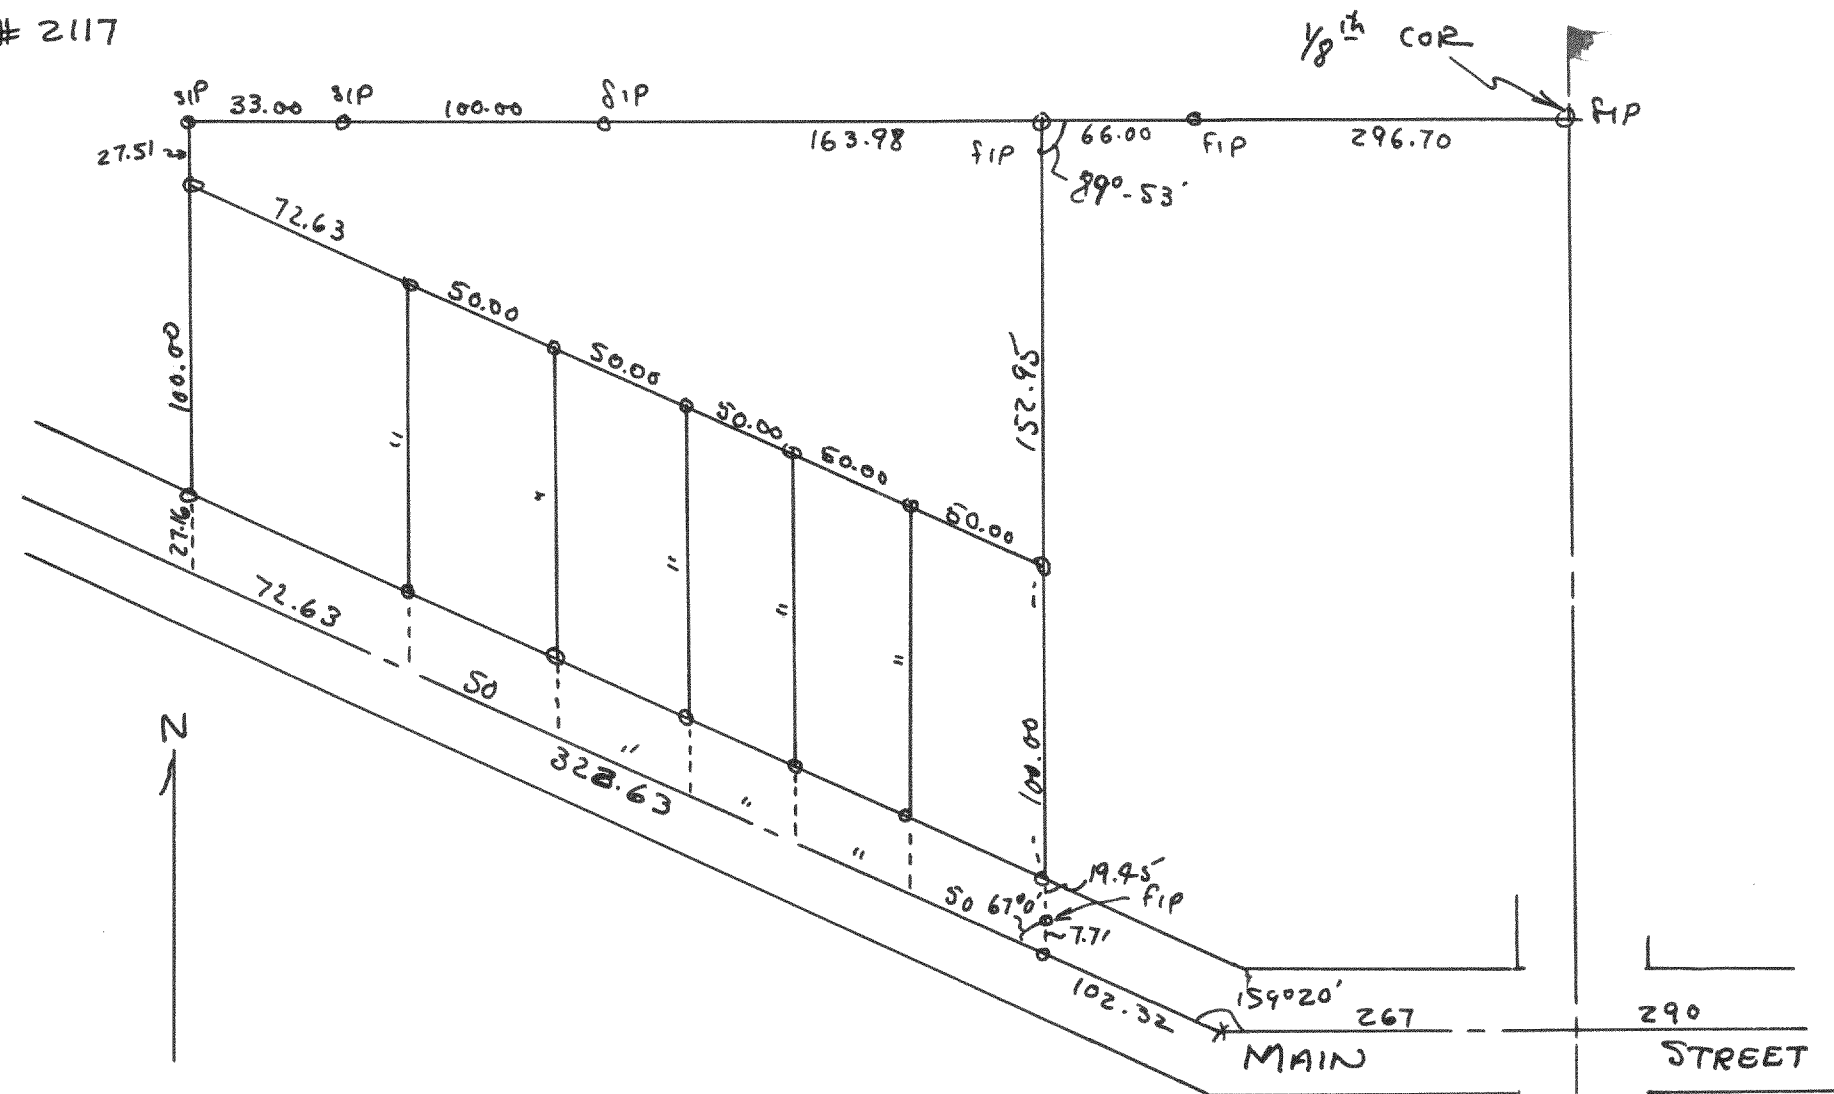

S 1/4 cor. Sec. 35-1-167

Plat of survey of parcels of land located in the SW 1/4
of Sec 35, T.1N.10E in the Village of Seneca City of Wal. Co., Wis.
Jan 4, 1950

Lloyd L. Jensen
County Surveyor