


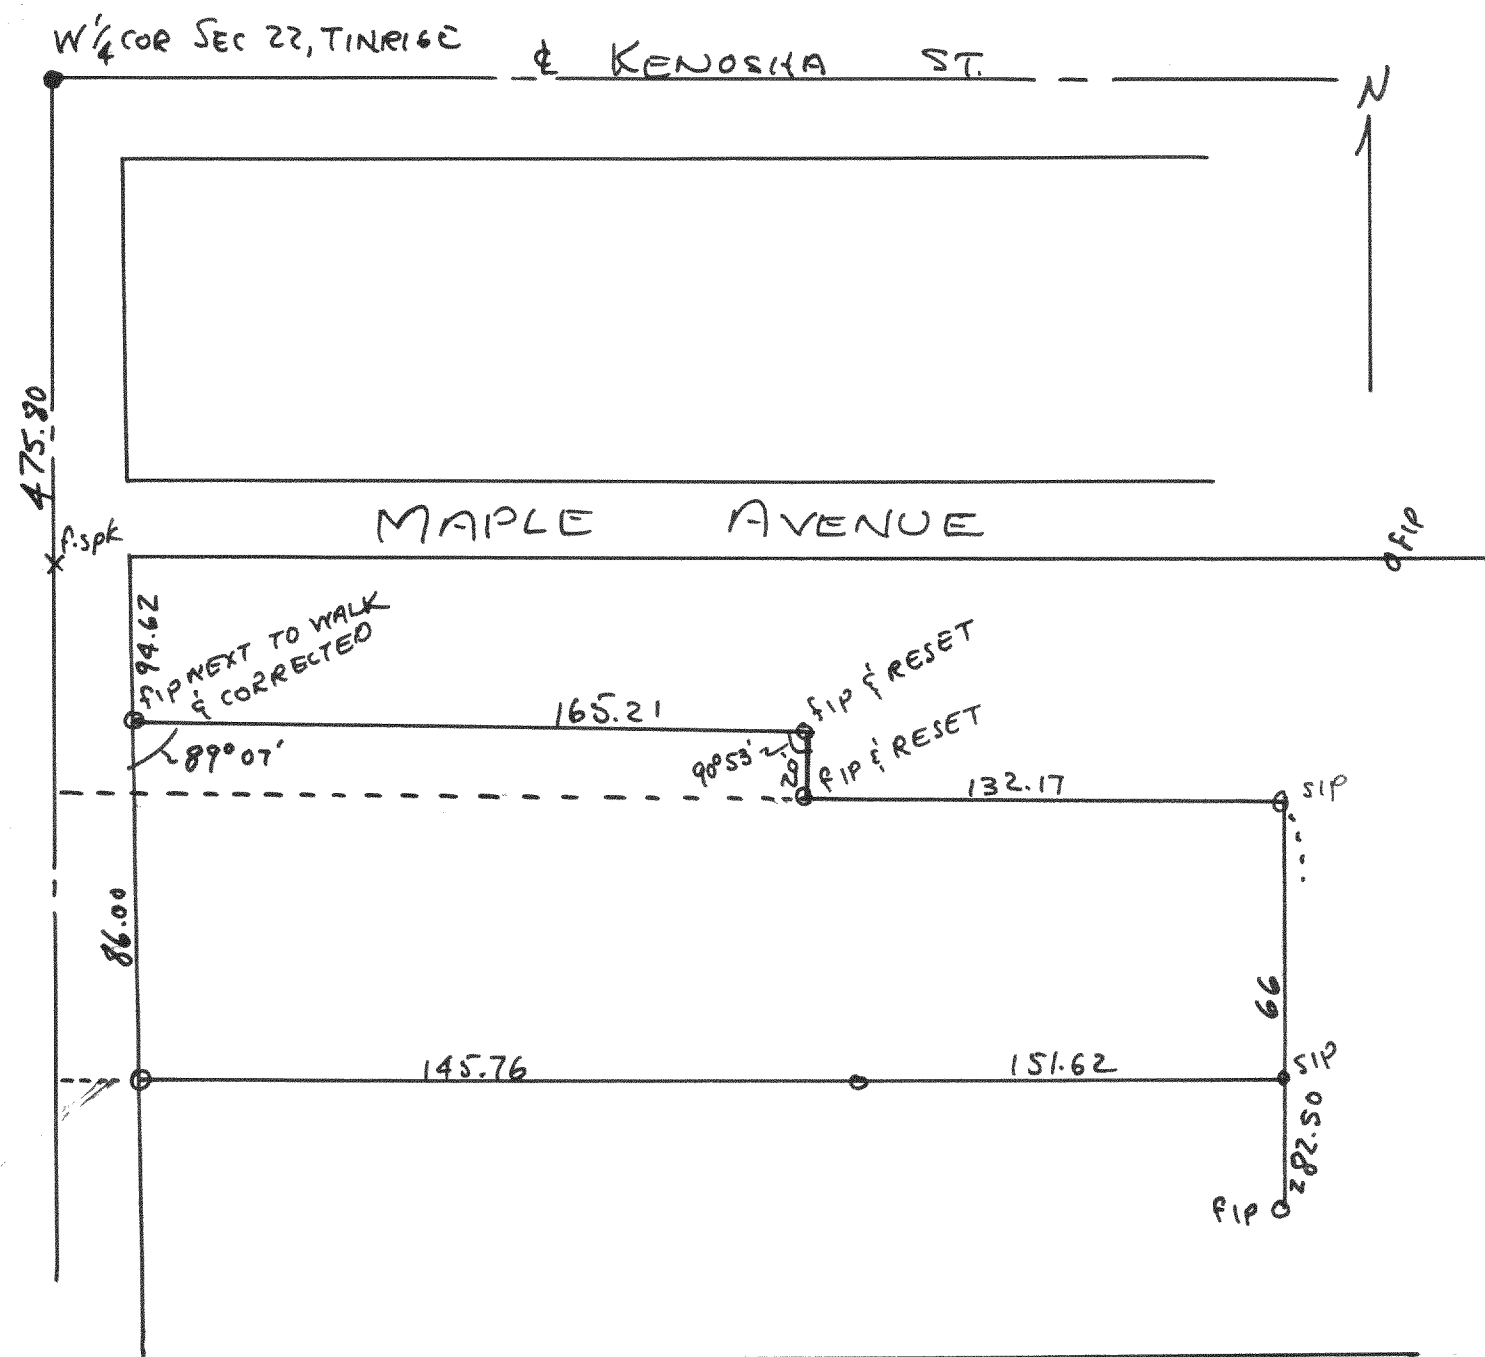

Plat of survey of O.L. 232-233 & part of H 34 of Charles Addition,
Village of Walworth, Walworth Co., Wis.
Dec 14, 1949
Floyd S. Jensen
County Surveyor

Plat of survey of Lot 3 Blk 1 of C.L. Douglas Addition,
Village of Fontana, Walworth Co., Wisconsin
1949
Hoyd L. Jensen
County Surveyor