


#2132

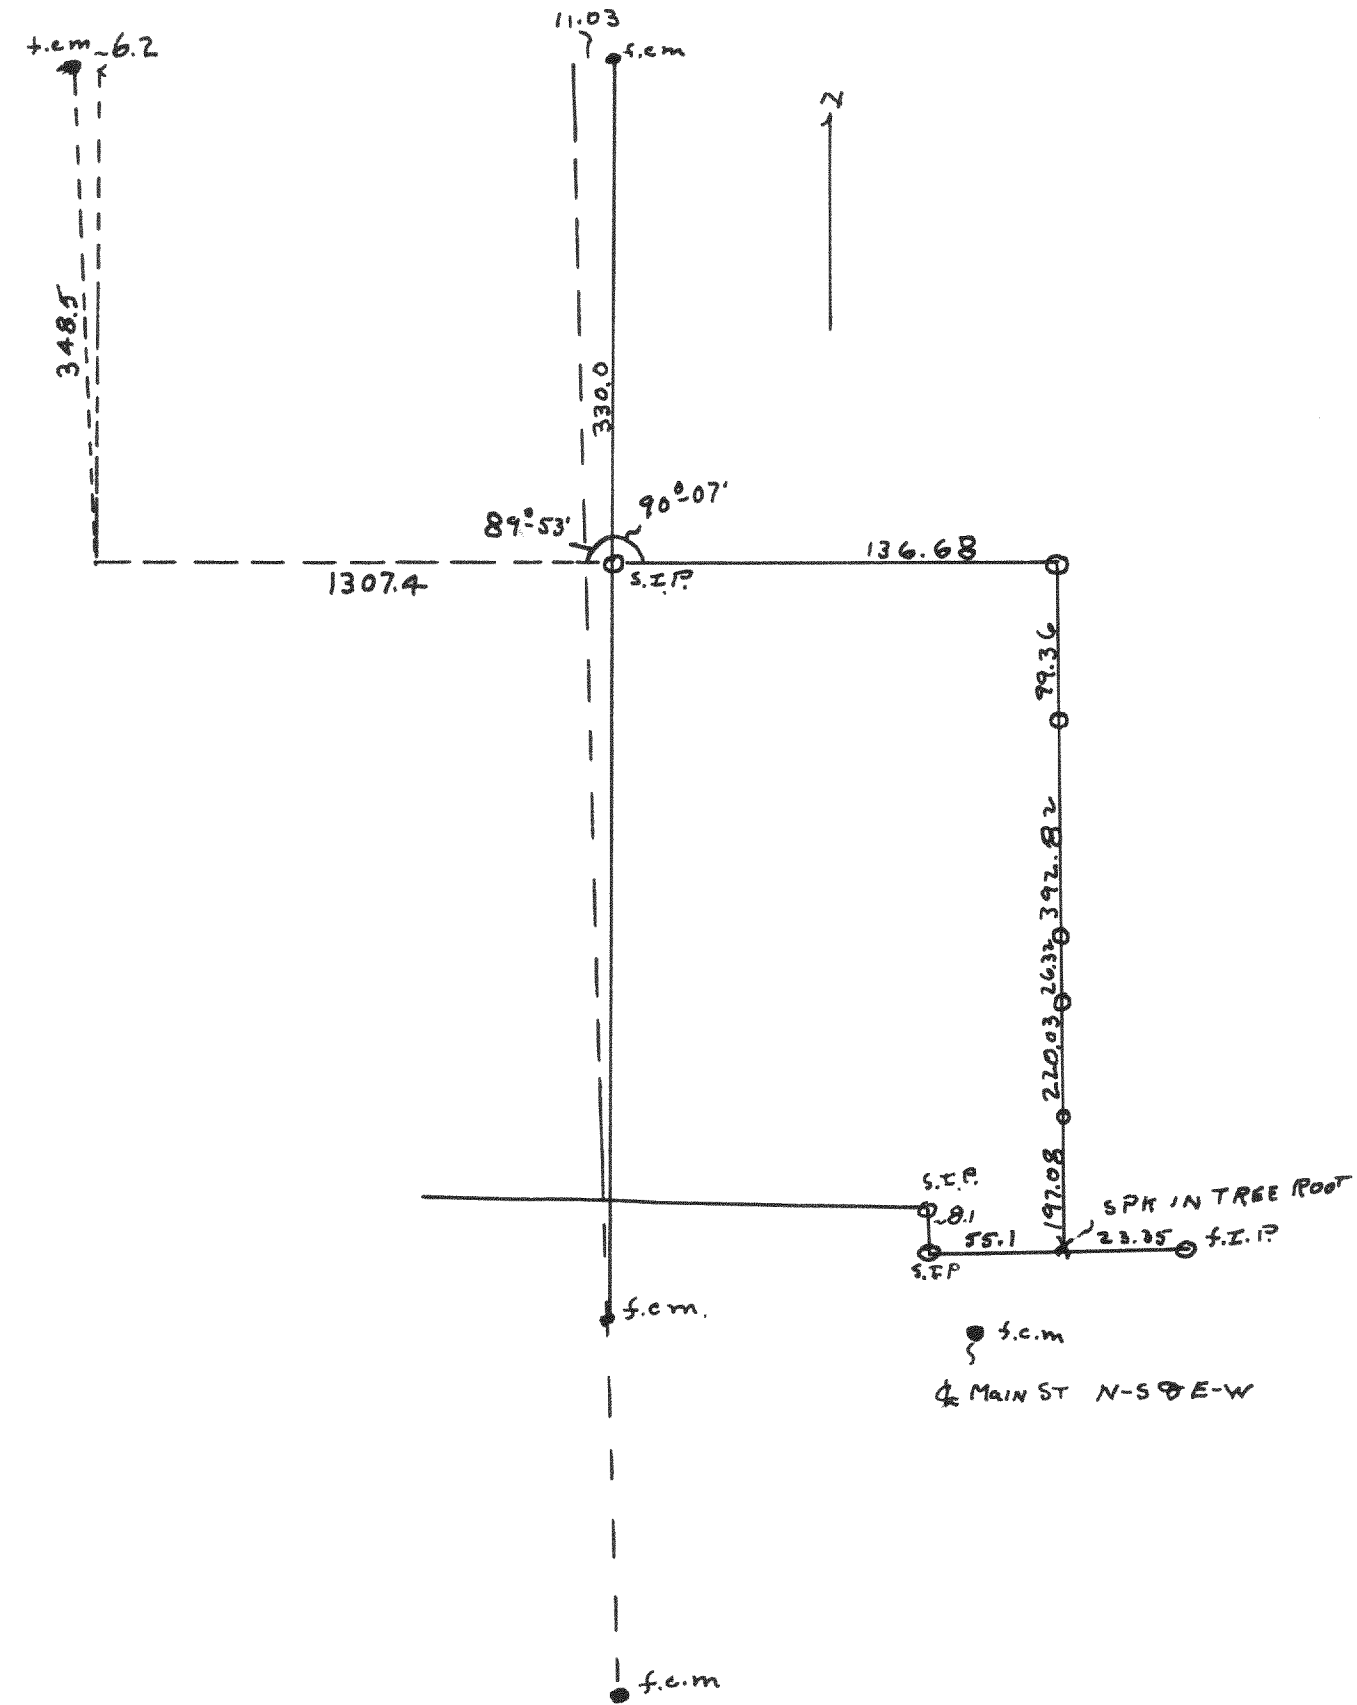


Plot of survey of O.L. 16 in the Village of Fontana, Walworth County

1949

Lloyd E Jensen *sd*
County Surveyor

#2133

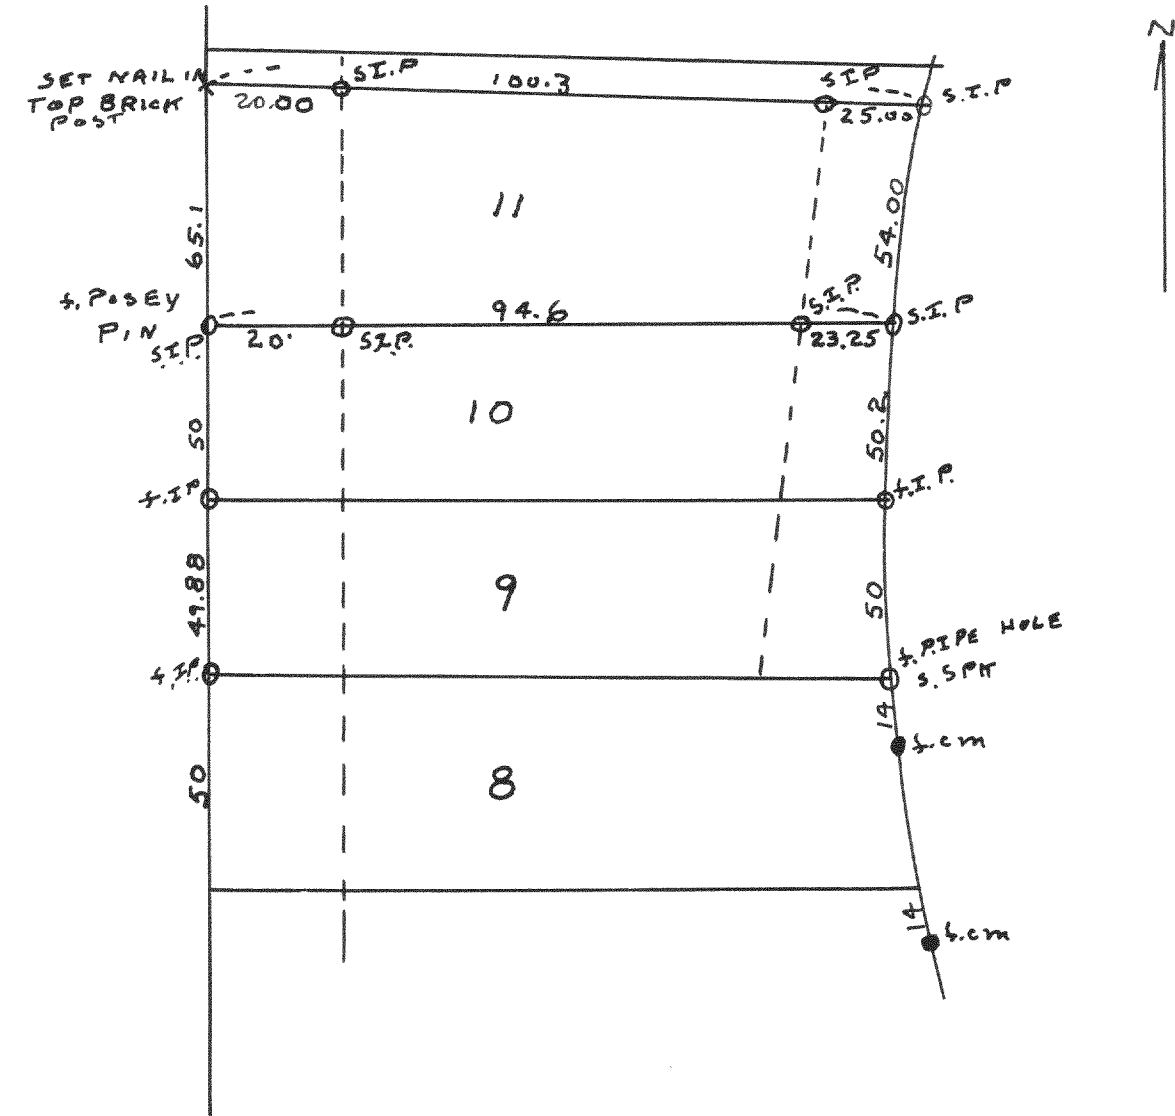

Plot of survey of lot 11 Block 1 Indian Hills Subdivision
Village of Fontana, Walworth County.

April 1949

Lloyd E Jensen *sd*
County Surveyor