



2167

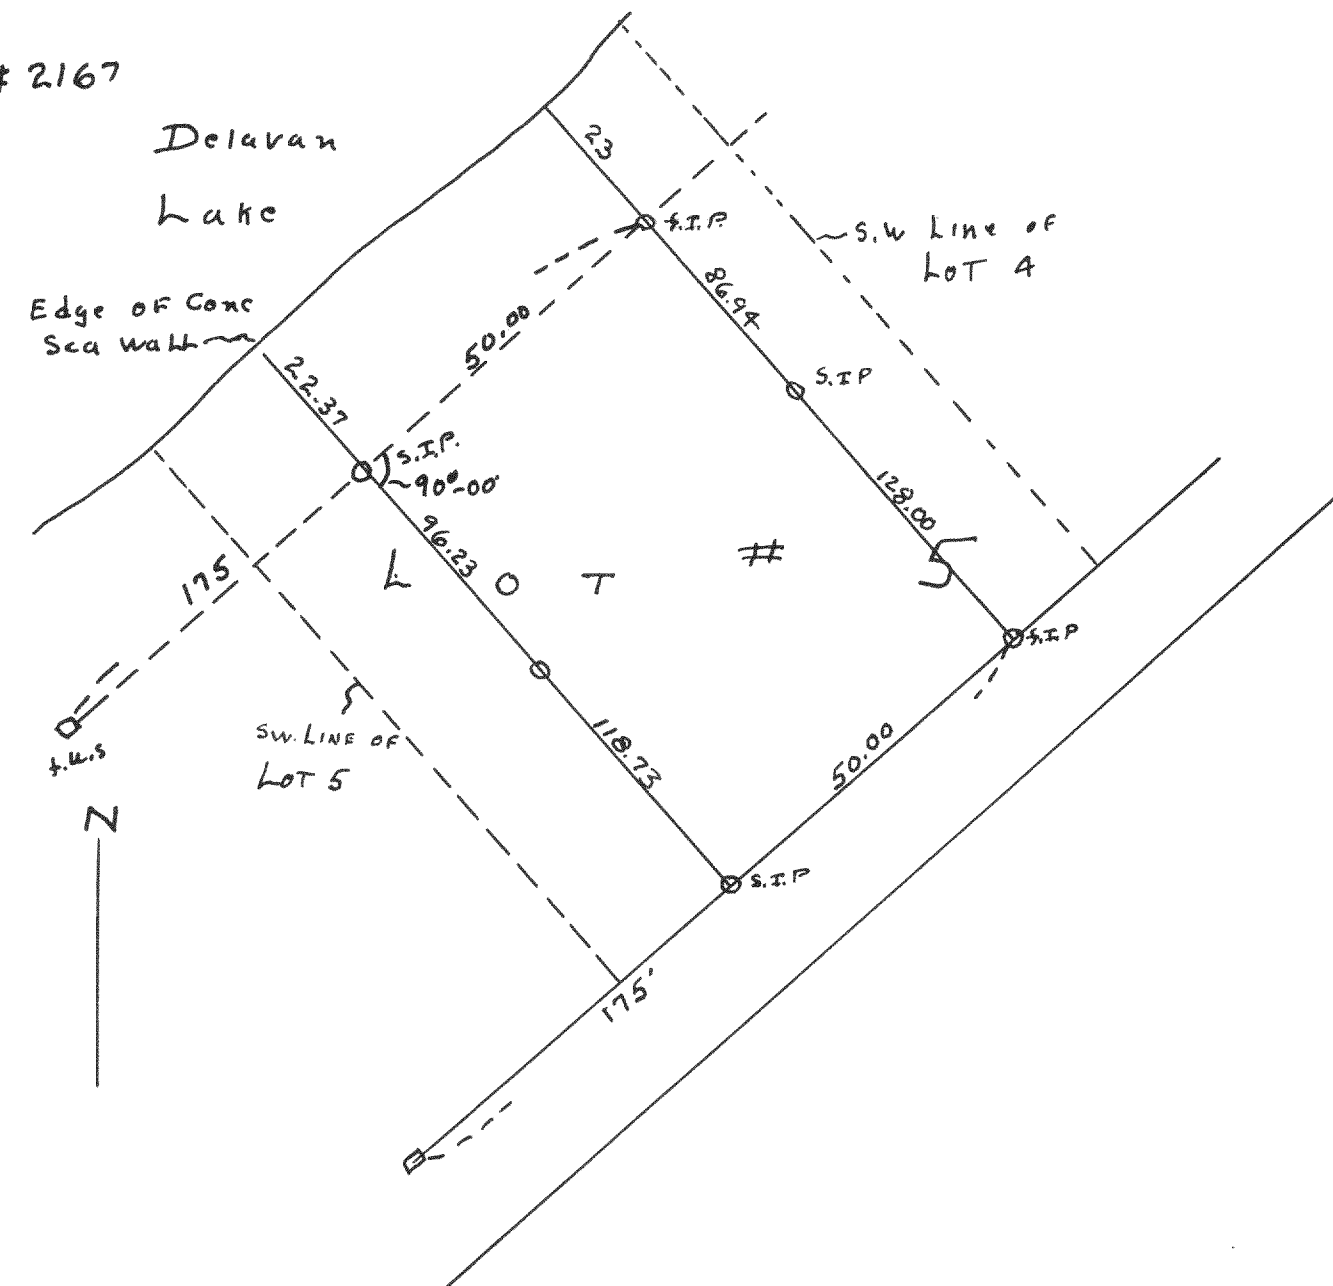

Plot of survey of part of lot 5 of Harrington
subdivision located in section 27 T 2 N R 16 E Malworth Co
July 25, 1949
Floyd & Jensen ^{SD}
County Surveyor

2168

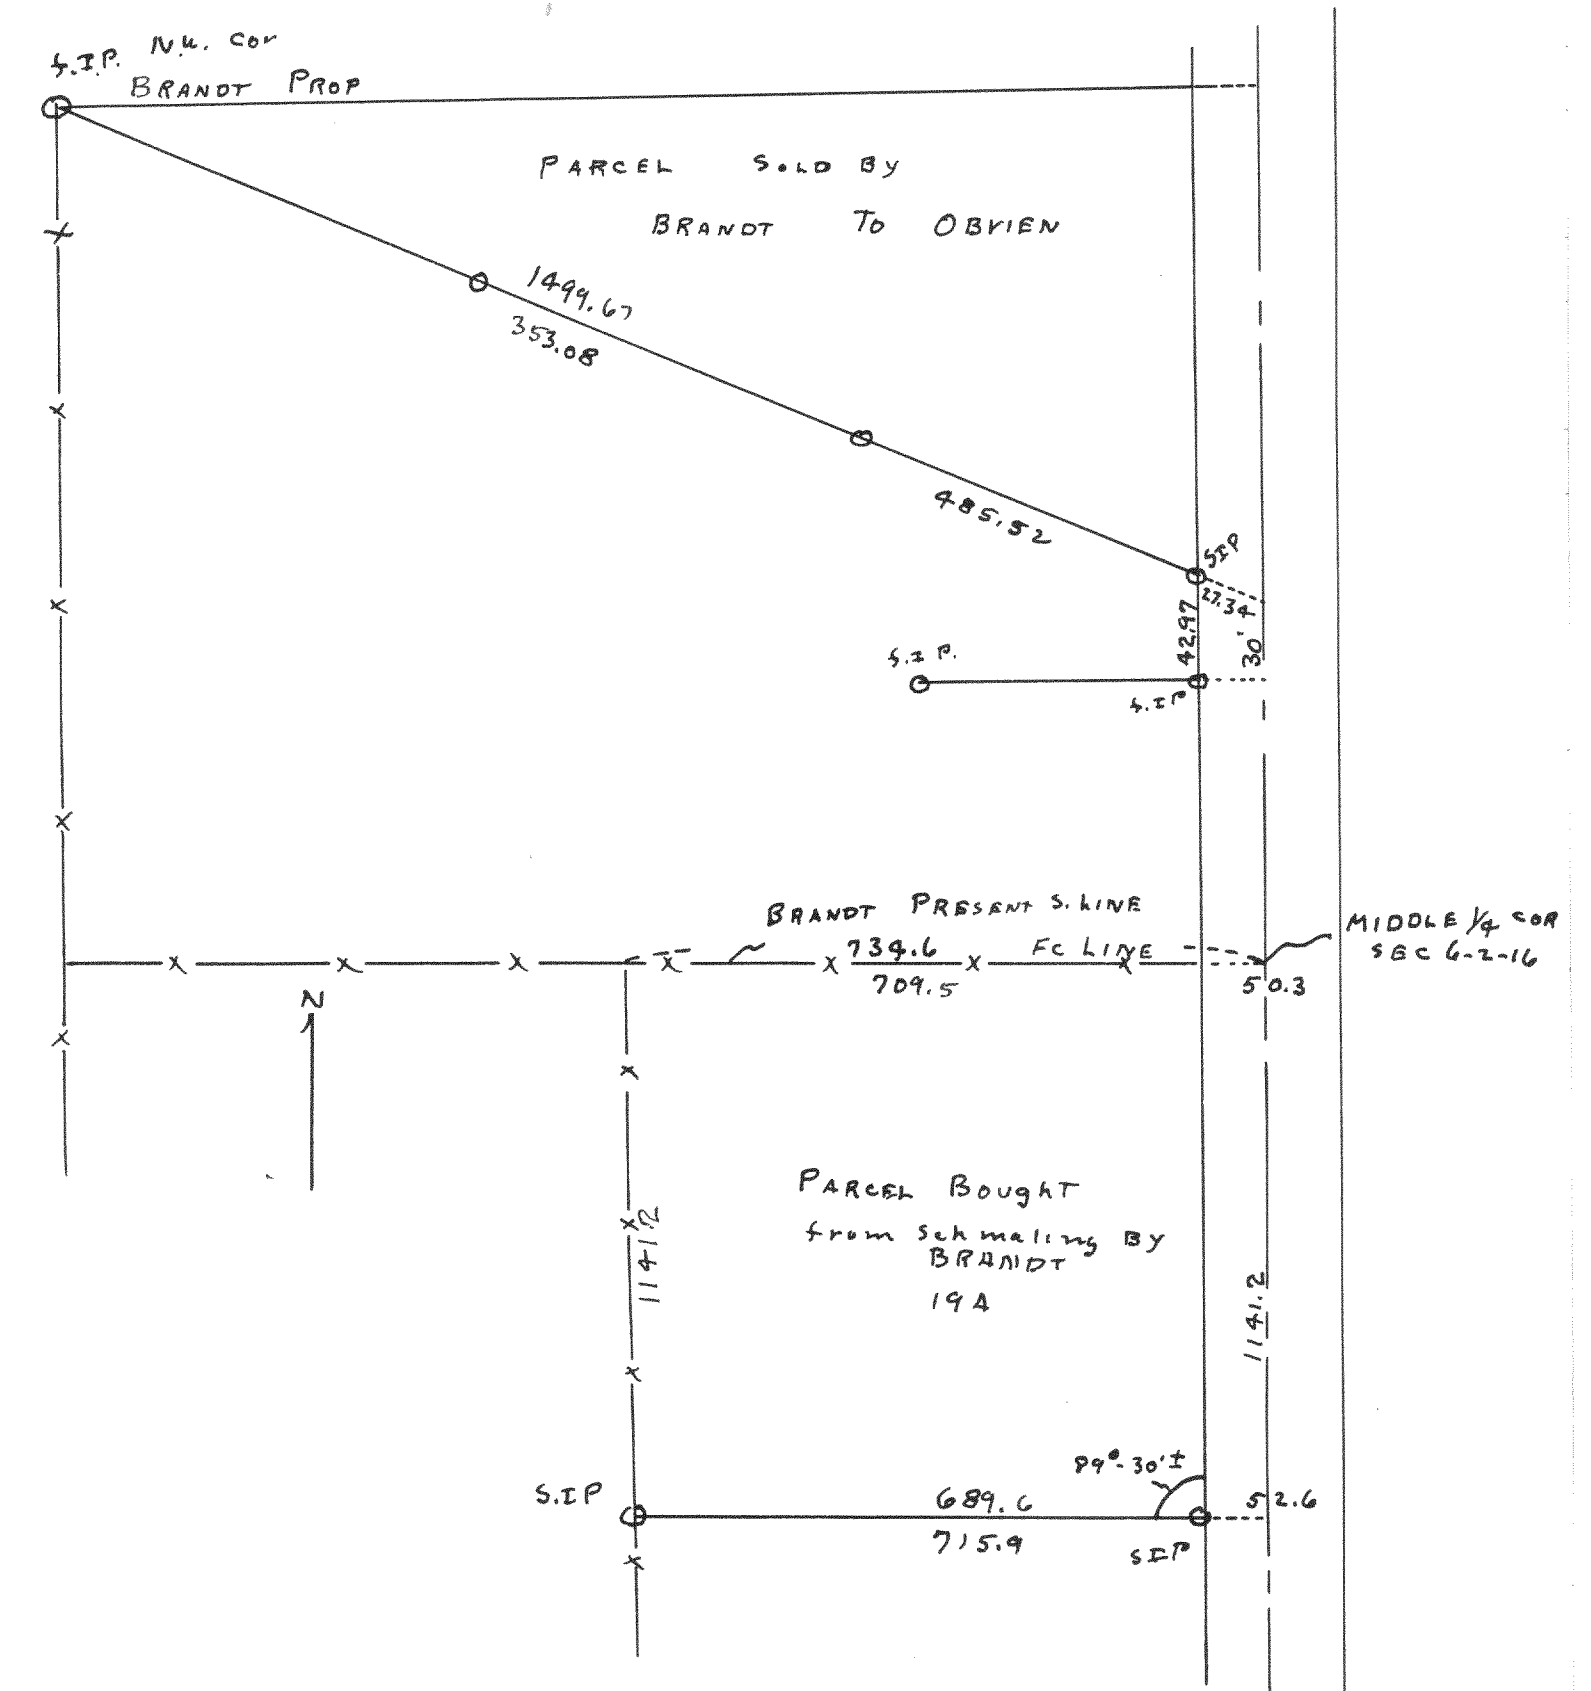

Plot of survey of parcel of land located in section 6 T 2 N R 16 E
Malworth County
Aug 29, 1949
Floyd & Jensen ^{SD}
County Surveyor