



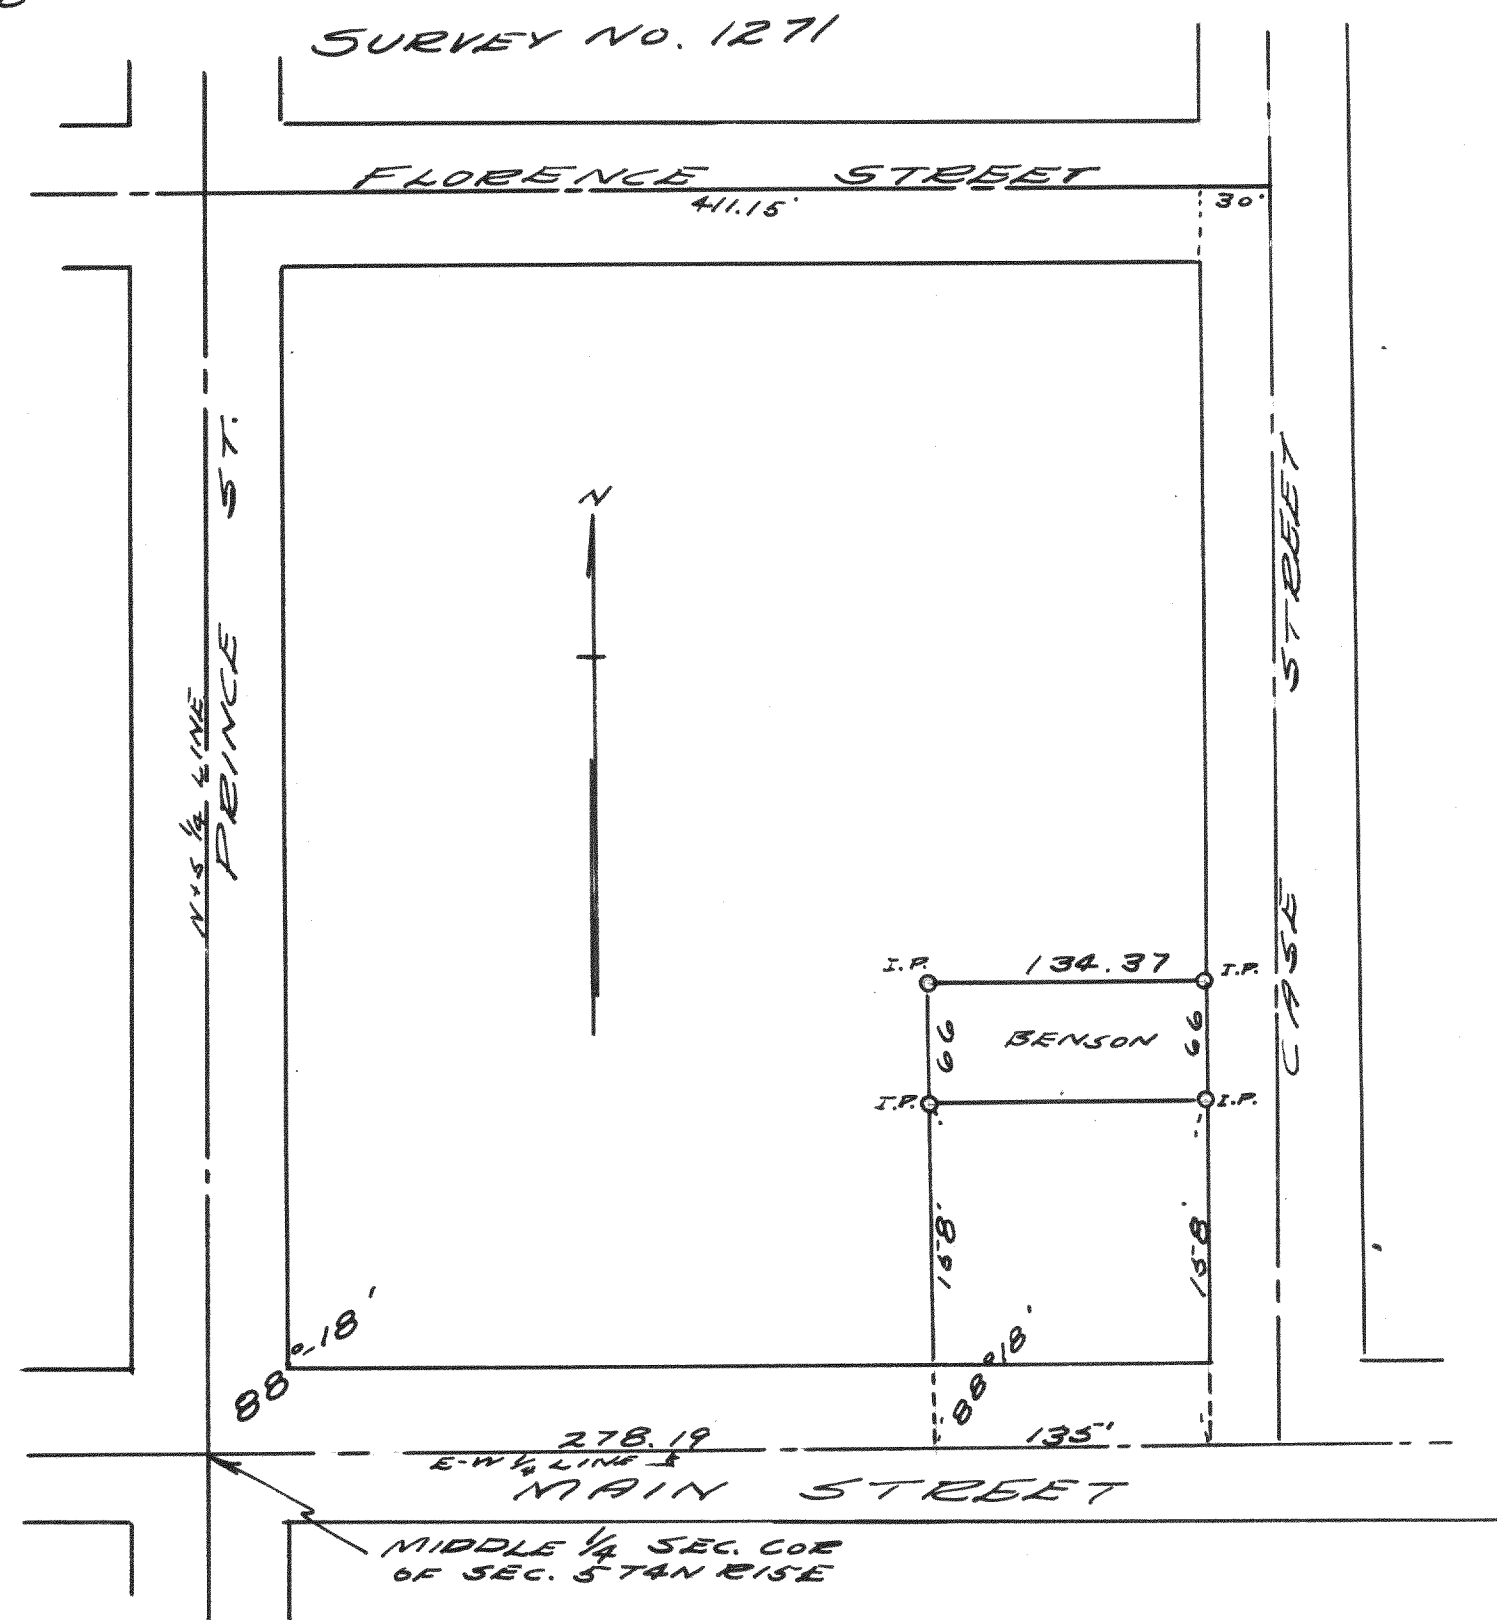

PLAT OF SURVEY OF LAND LOCATED IN THE
NORTHWEST $\frac{1}{4}$ OF SECTION 5 T4N R15E, IN
THE CITY OF WHITEWATER, WALWORTH CO.
WISCONSIN
APRIL, 1941

Lloyd L. Jensen
R.E.G.

SURVEY NO. 1272

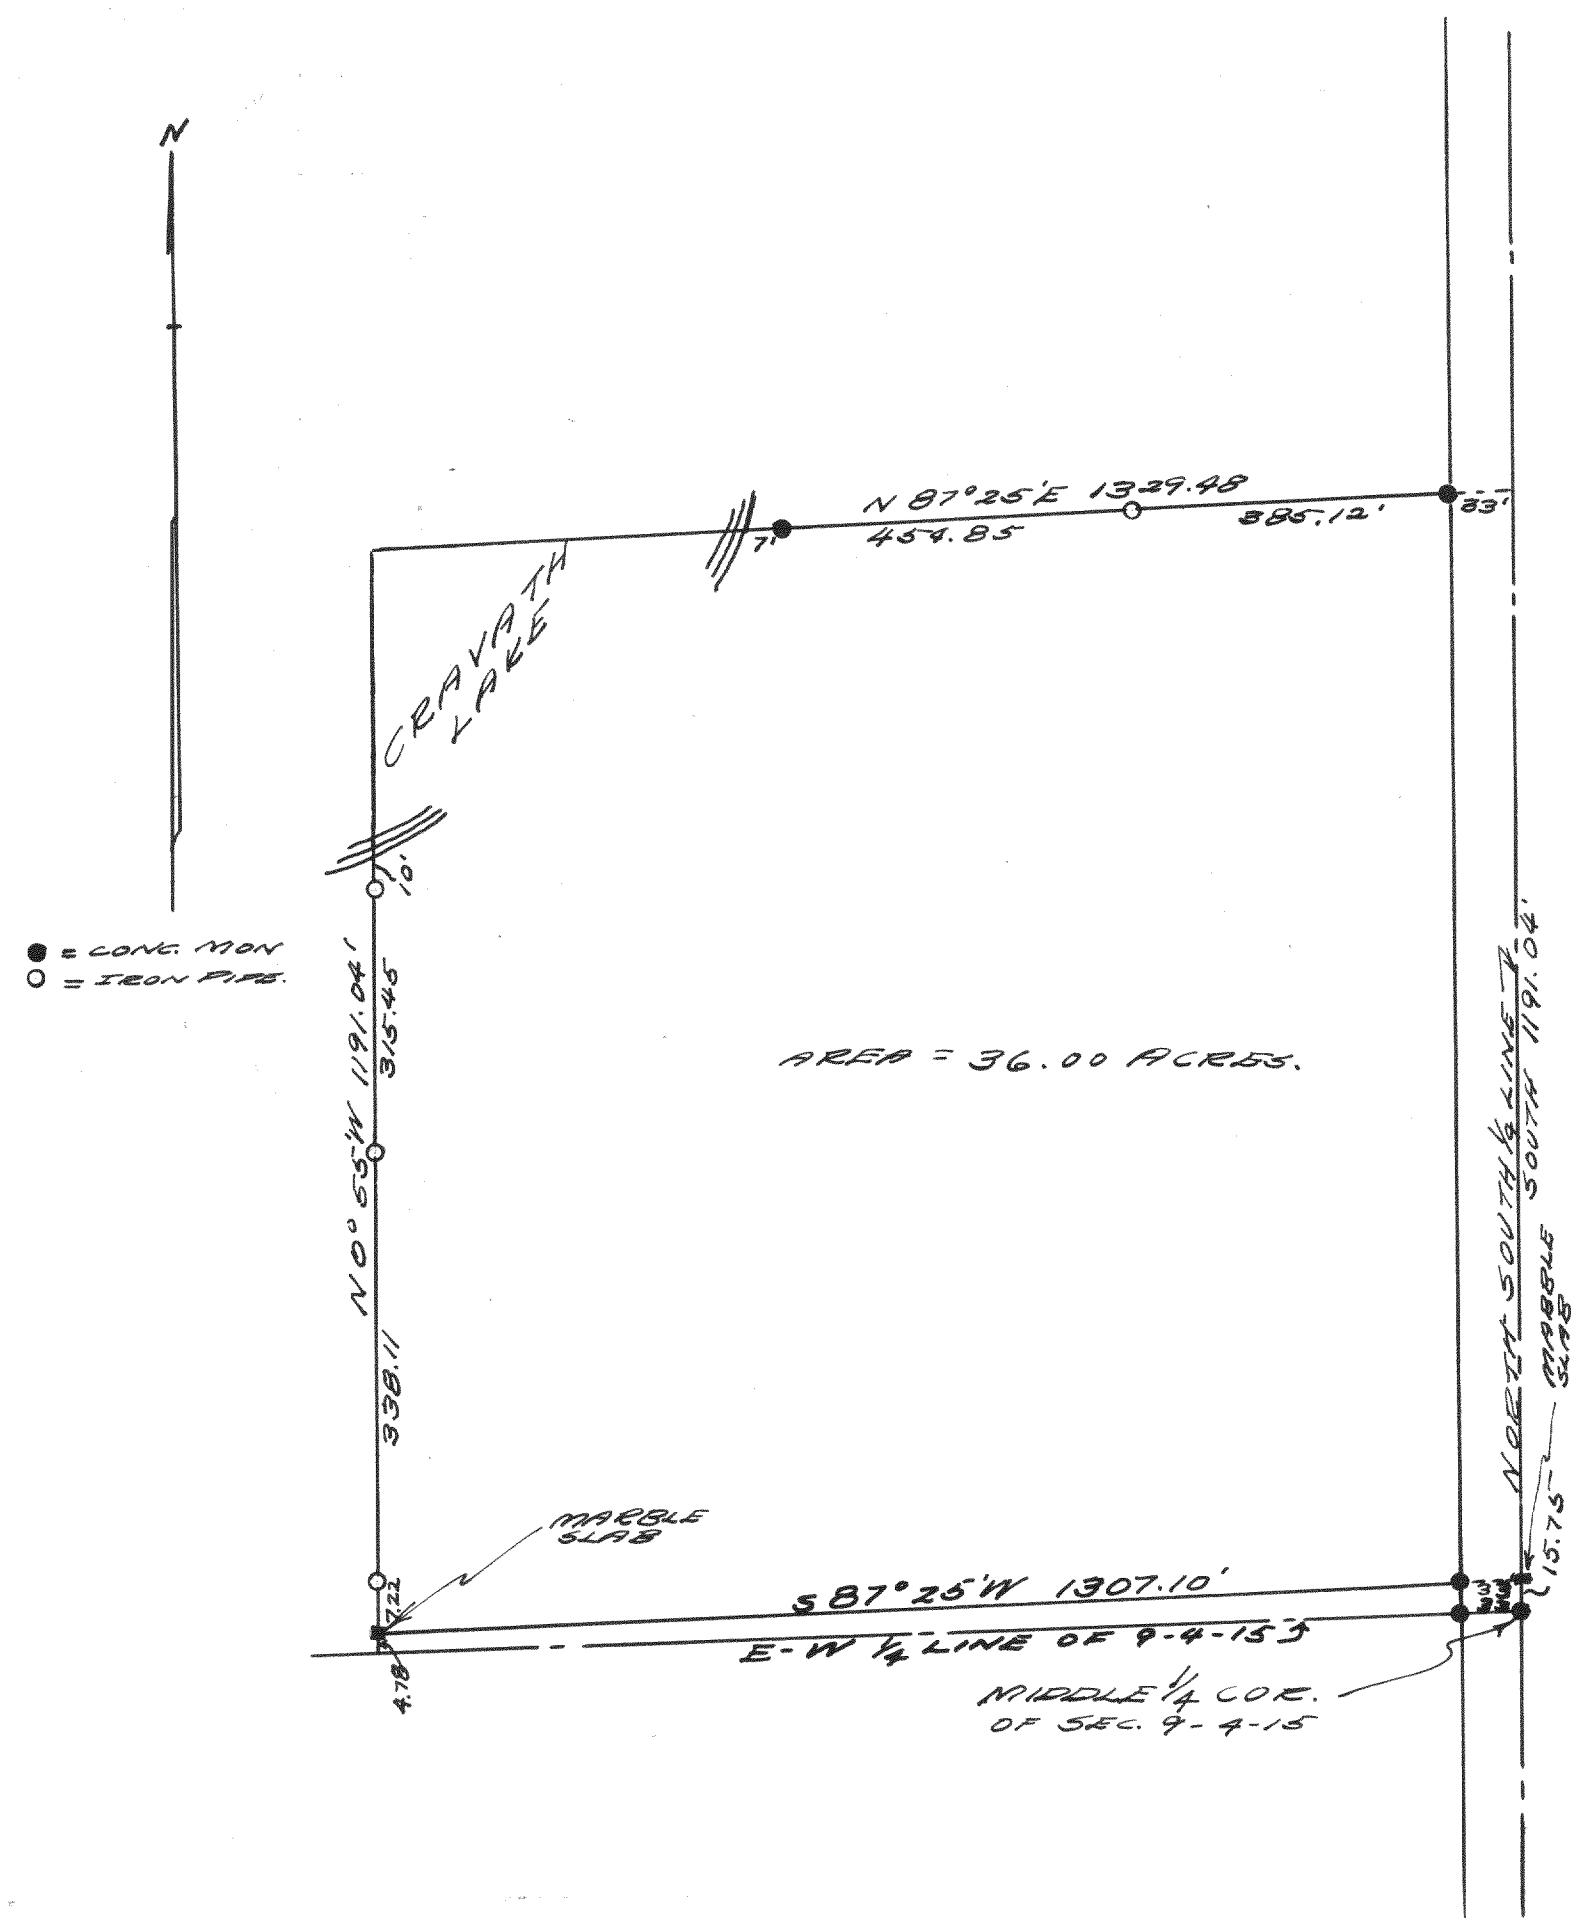

PLAT OF SURVEY OF LAND LOCATED IN THE
NORTHWEST $\frac{1}{4}$ OF SECTION 9 T4N R15E, IN
THE CITY OF WHITEWATER, WALWORTH CO.,
WISCONSIN.
JULY 25, 1941

Lloyd L. Jensen
R.E.G.