



2209

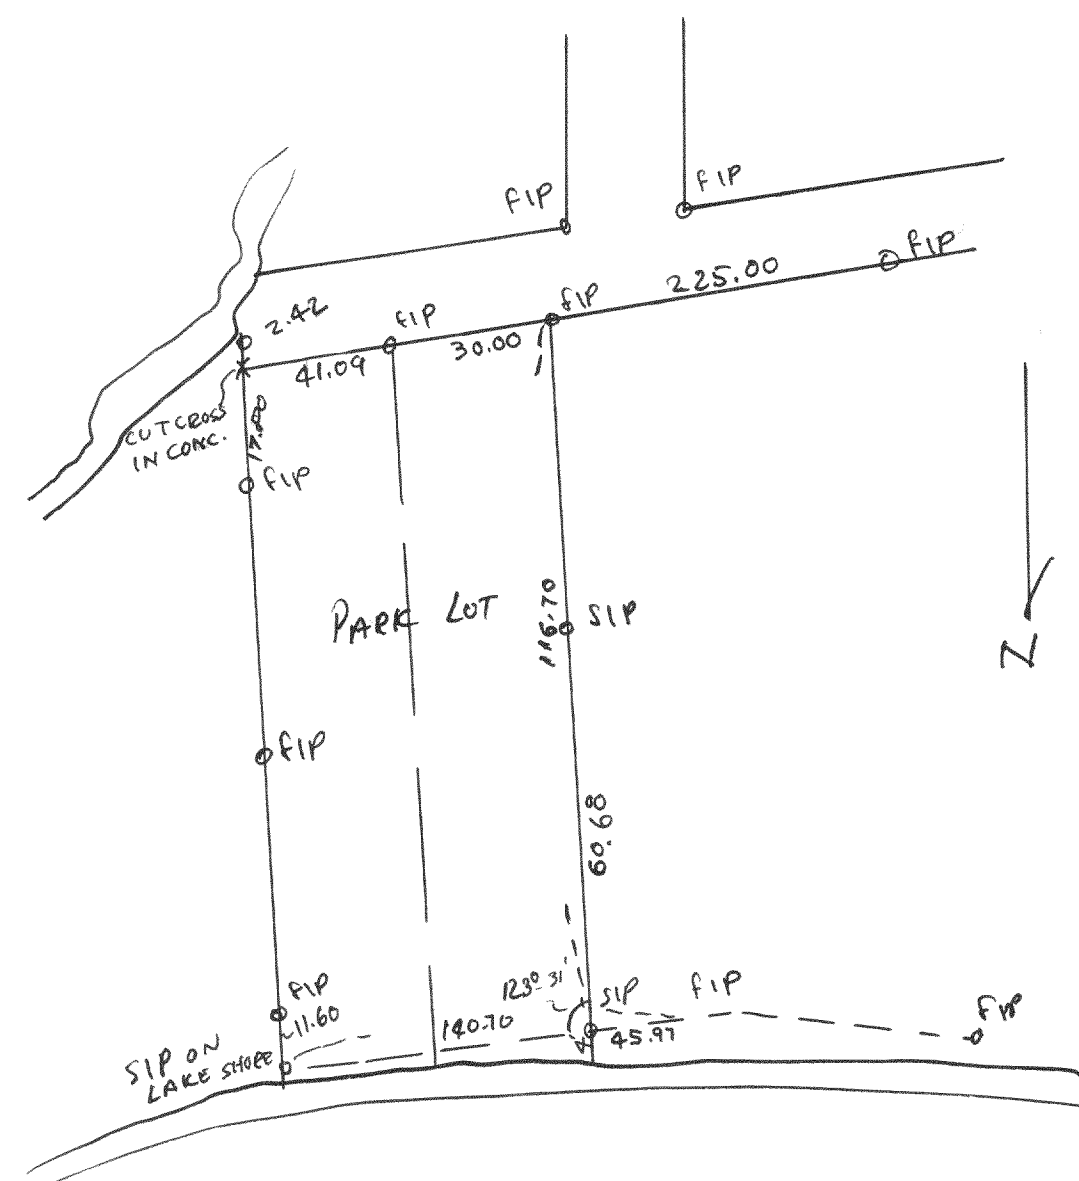

Plat of survey of the Community Park South shore
Mans, located in Sec 32, T2N R16E of Walworth County, Wis.
Aug. 4, 1950
Lloyd L. Jensen
County Surveyor

2210

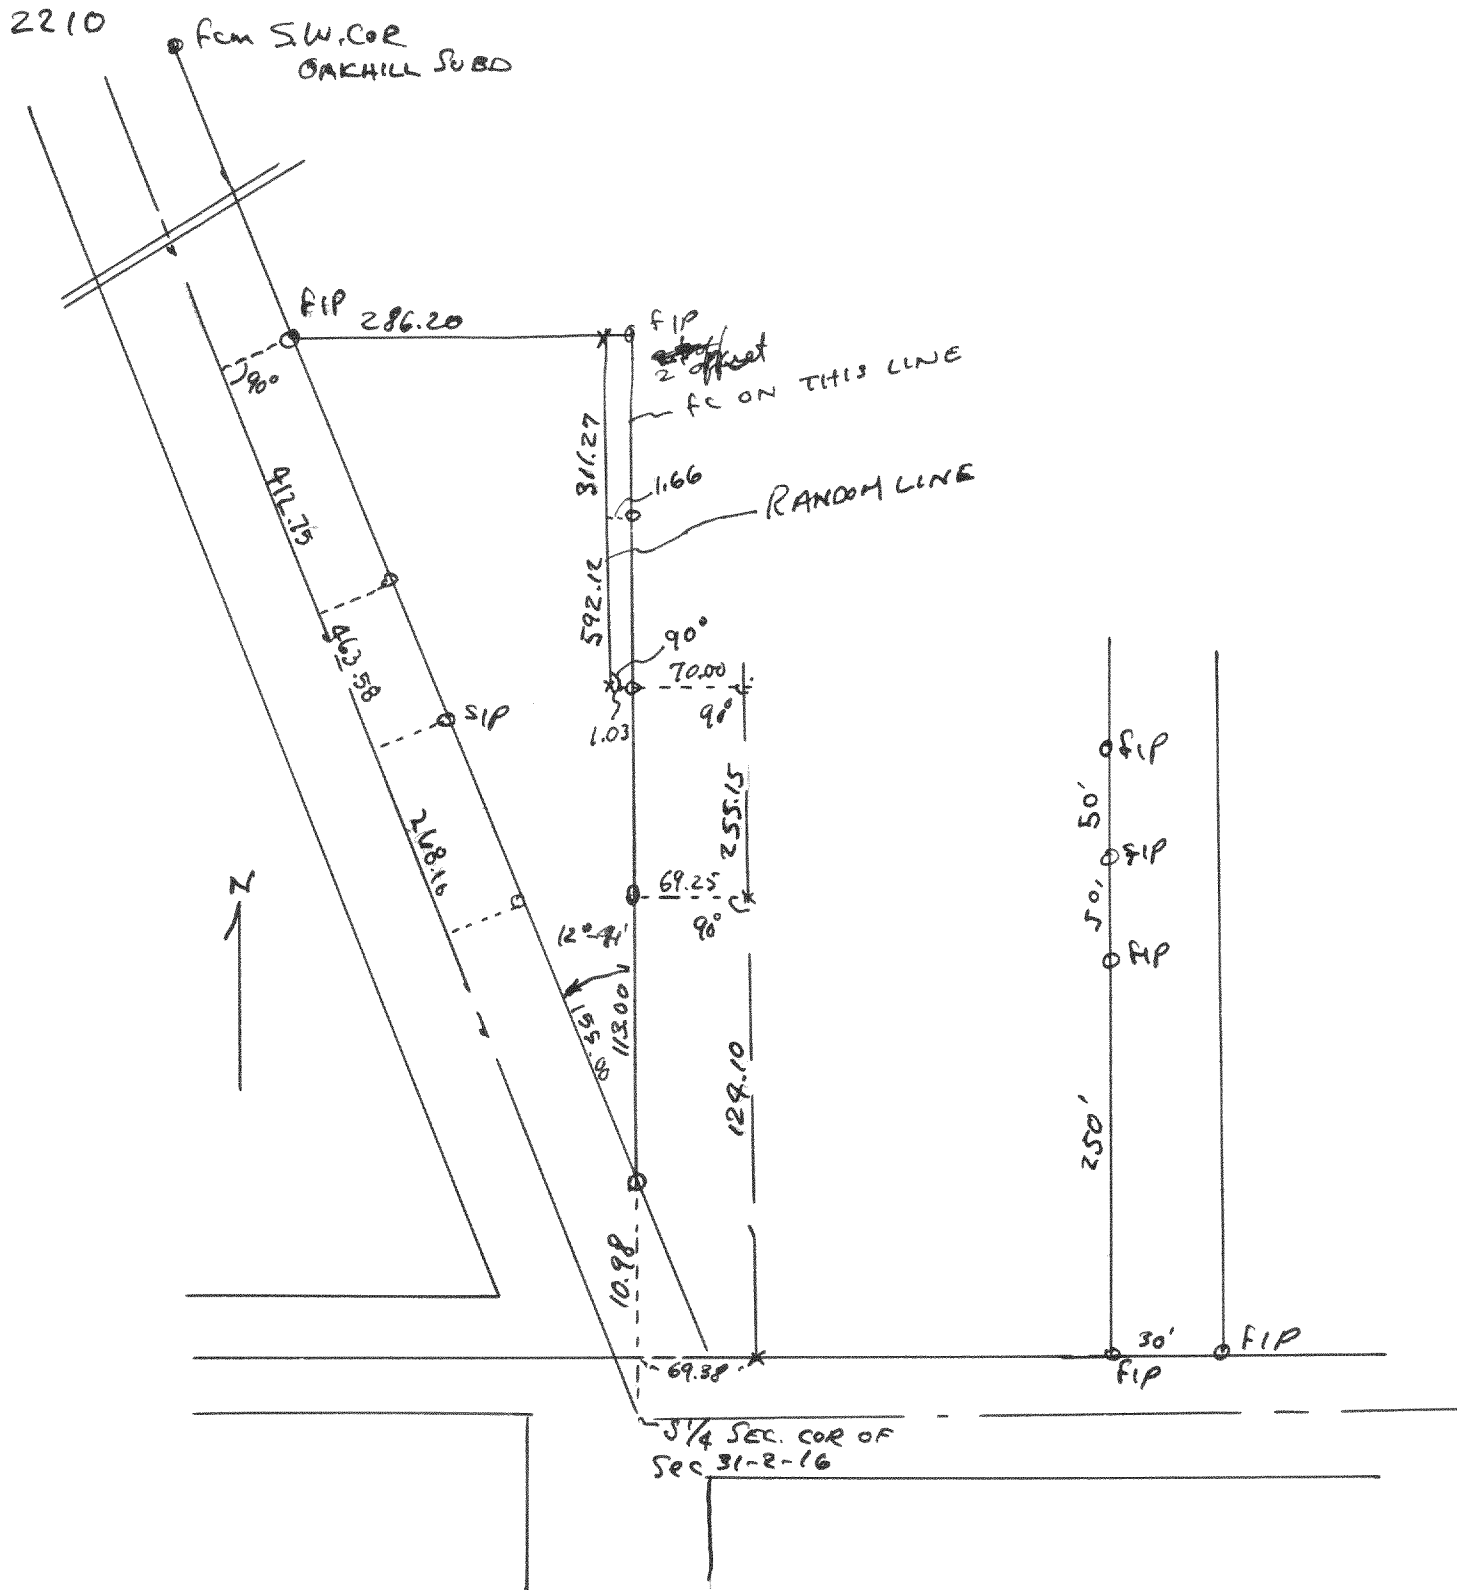

Plat of survey of Kruge property located in the SW 1/4 of Sec 31, T2N R16E,
of Walworth County, Wis.
Aug 8, 1950
Lloyd L. Jensen
County Surveyor