



2216 A

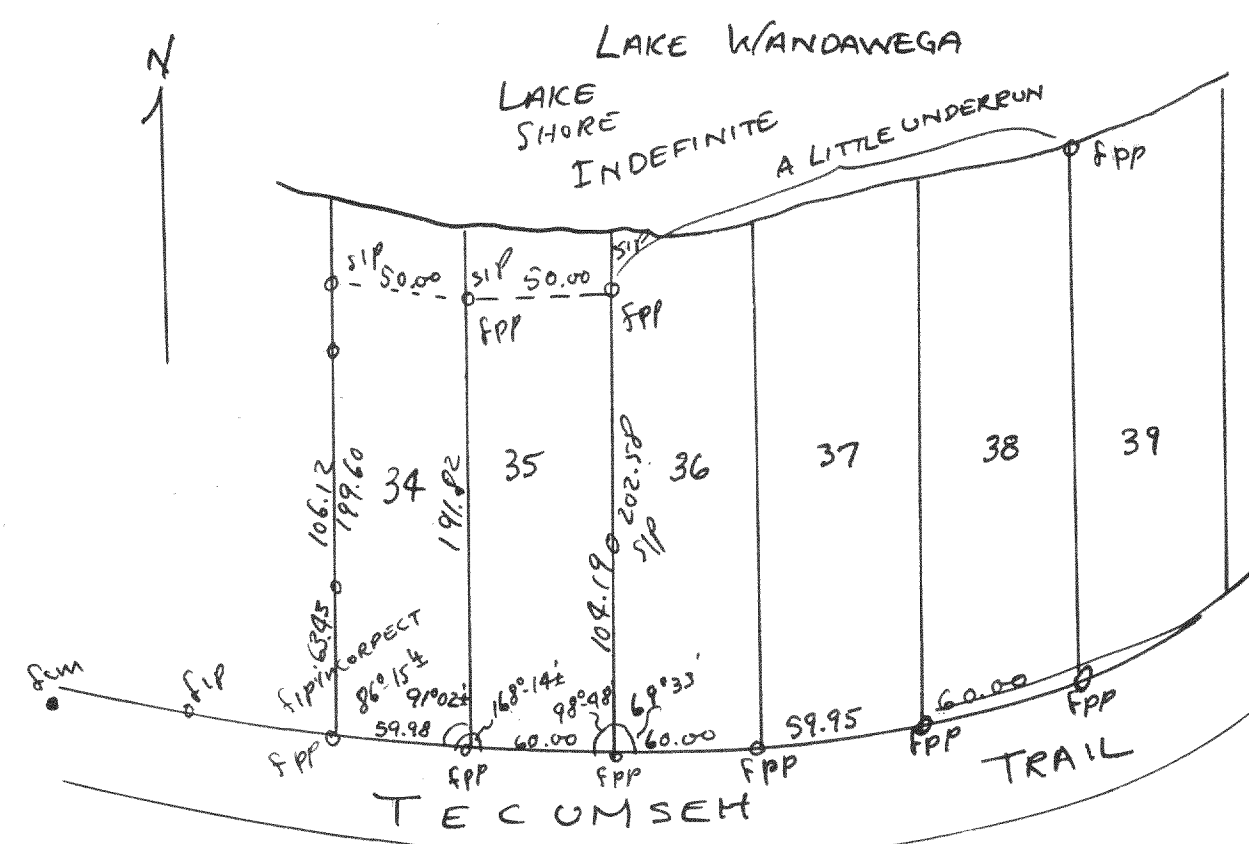


Survey of Lot 34 of Vandawega Highlands, Block I located
in Section 11 & 12, T3N R16E, Walworth Co., Wis.
May 20, 1950

2217

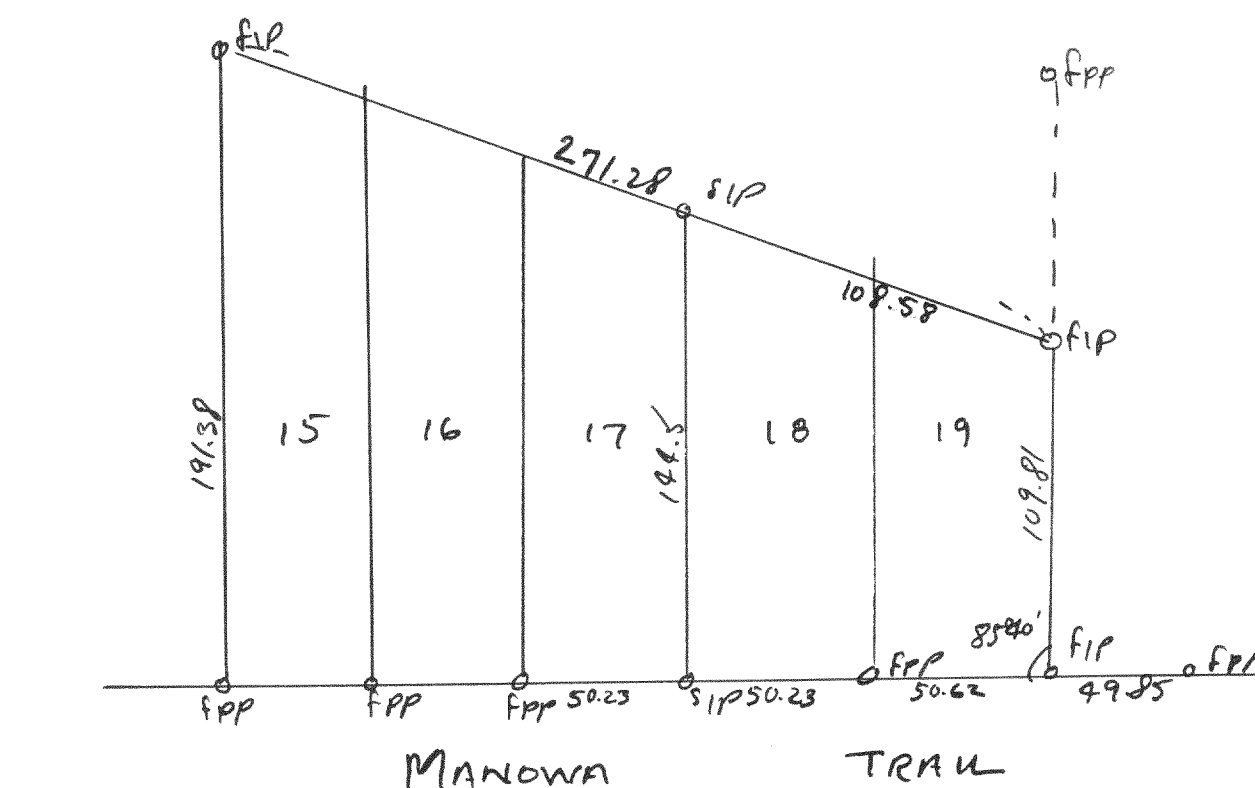

Plat of survey of Lot 18 & 19 Block I of Vandawega Highlands
located in Section 11 & 12, T3N R16E of Walworth Co., Wis.
May 29, 1950
Hoyd L. Jensen
County Surveyor

2218

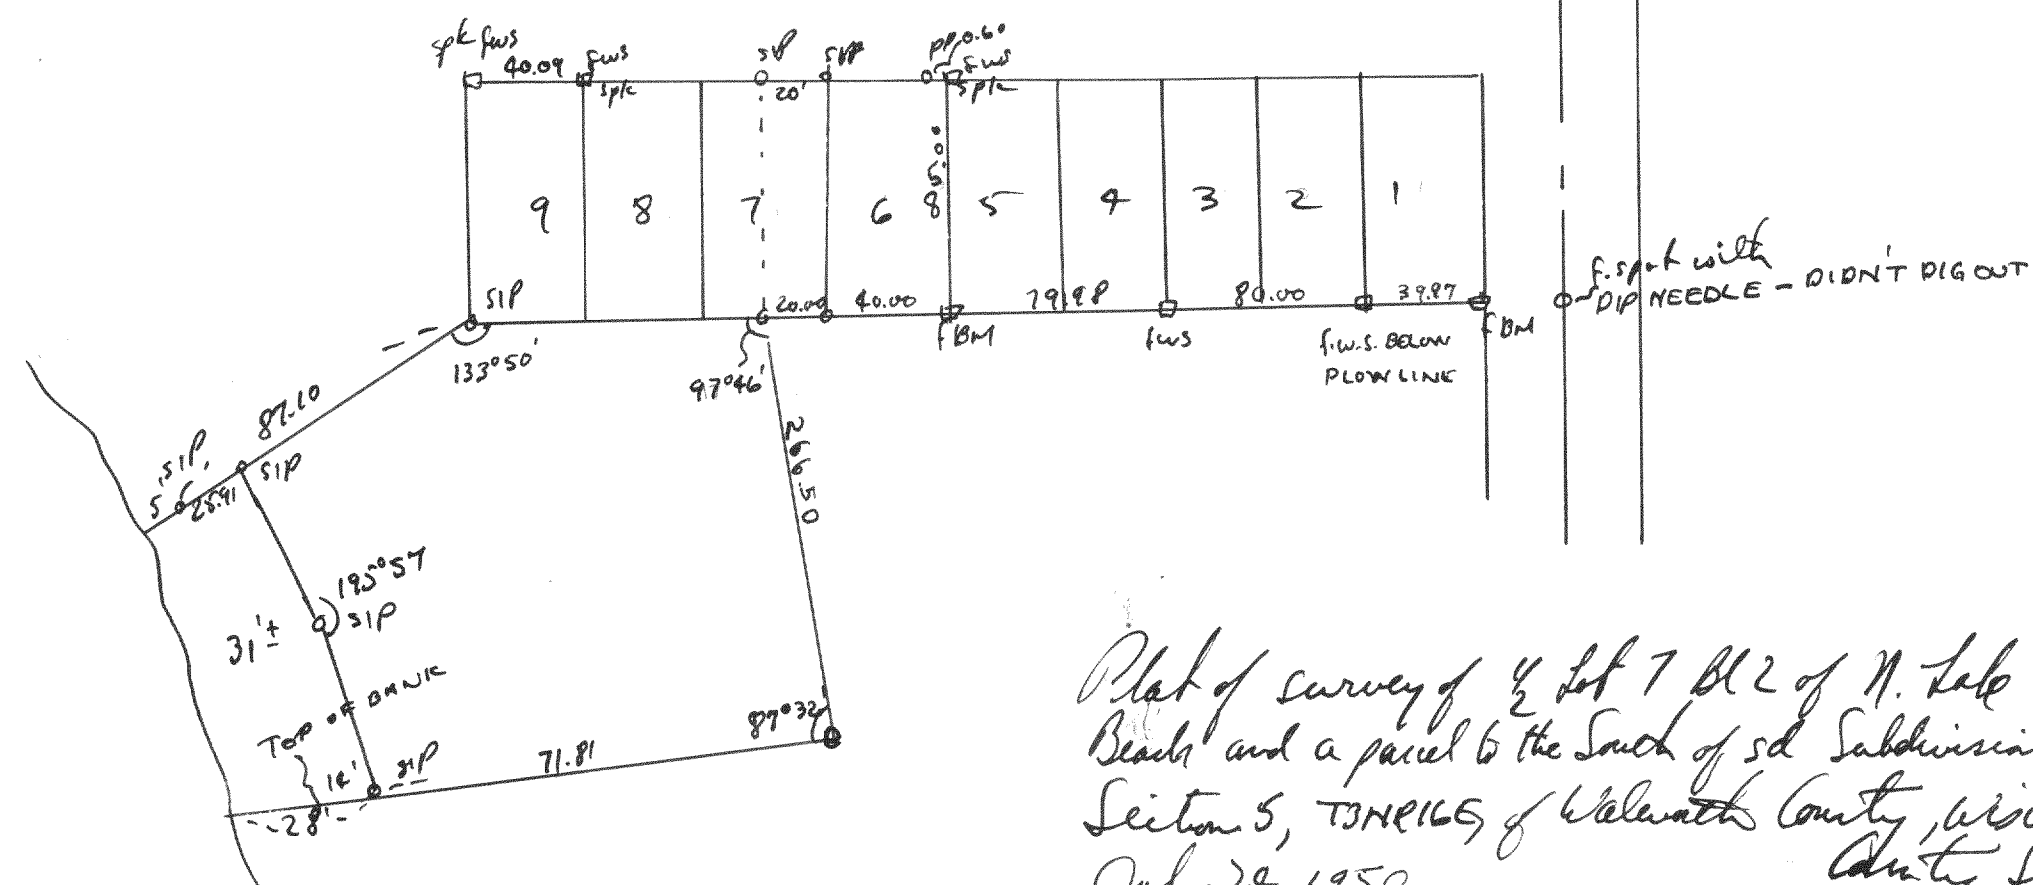

Plat of survey of Lot 7 Bl 2 of N. Lake Evergreen
Beach and a parcel to the South of sd Subdivision located in
Section 5, T3N R16E of Walworth County, Wisconsin
July 24, 1950
Hoyd L. Jensen
County Surveyor