



#2219

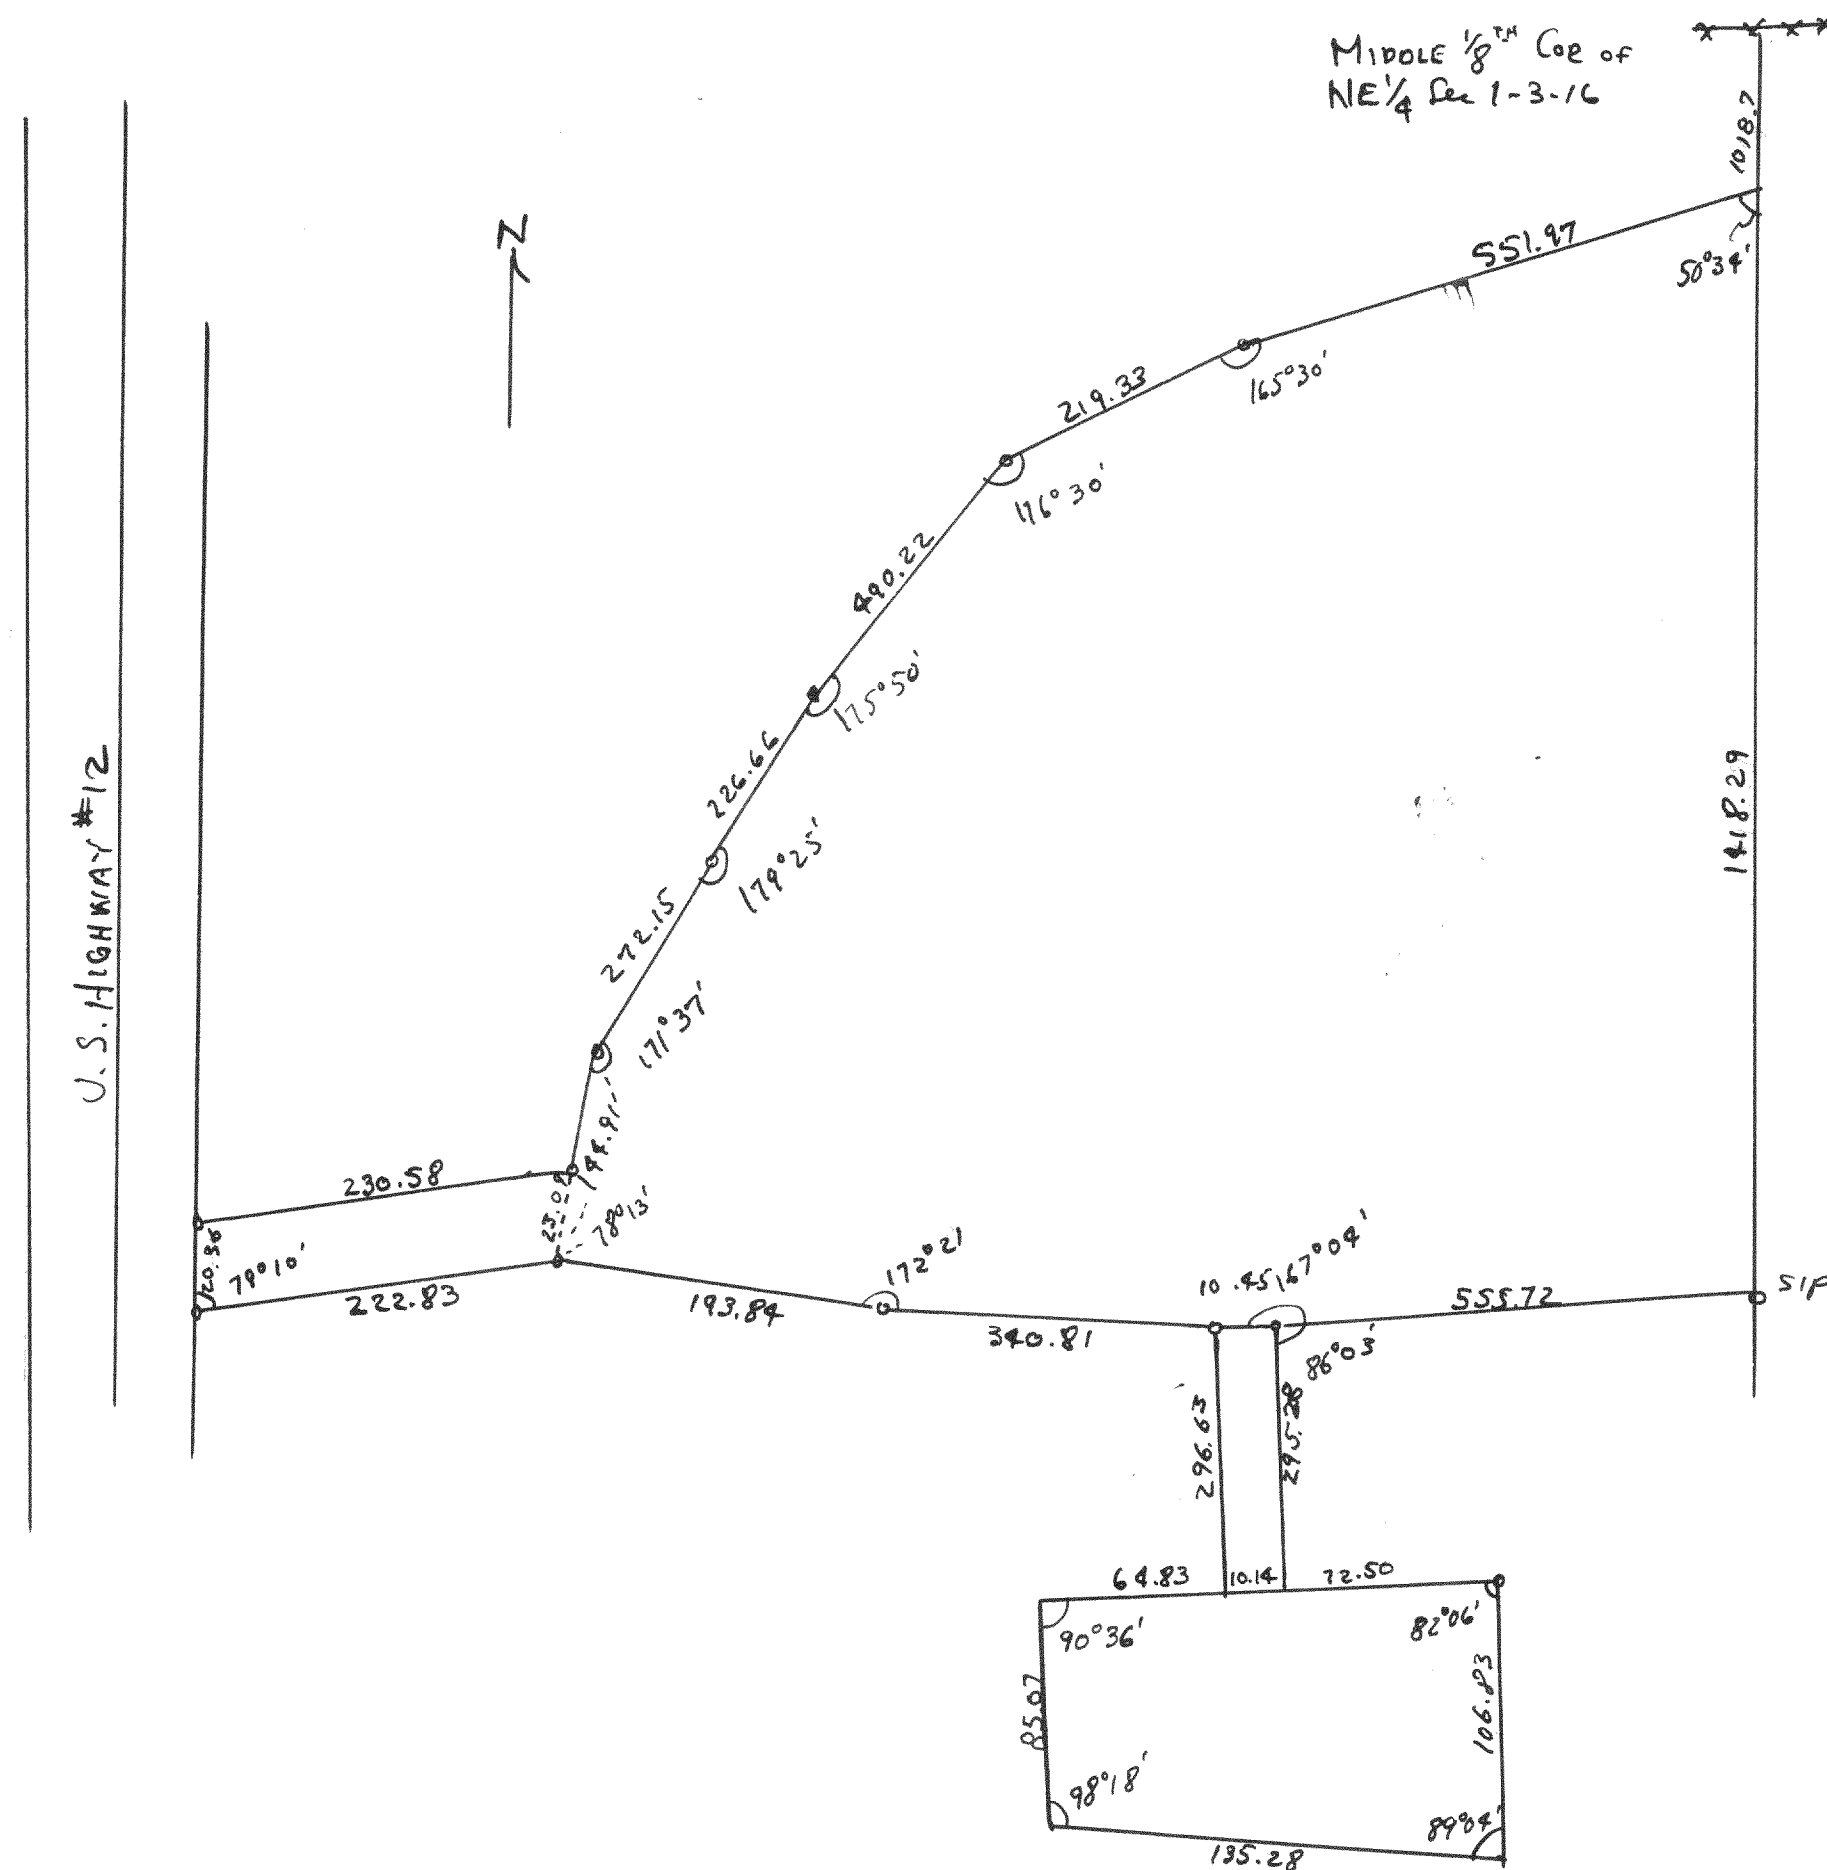

Plot of survey of Mann Bros Sand Pit located in Sec 1, T3N R16E,
of Walworth County Wisconsin
July 26, 1958

Lloyd S. Jensen
County Surveyor

#2220

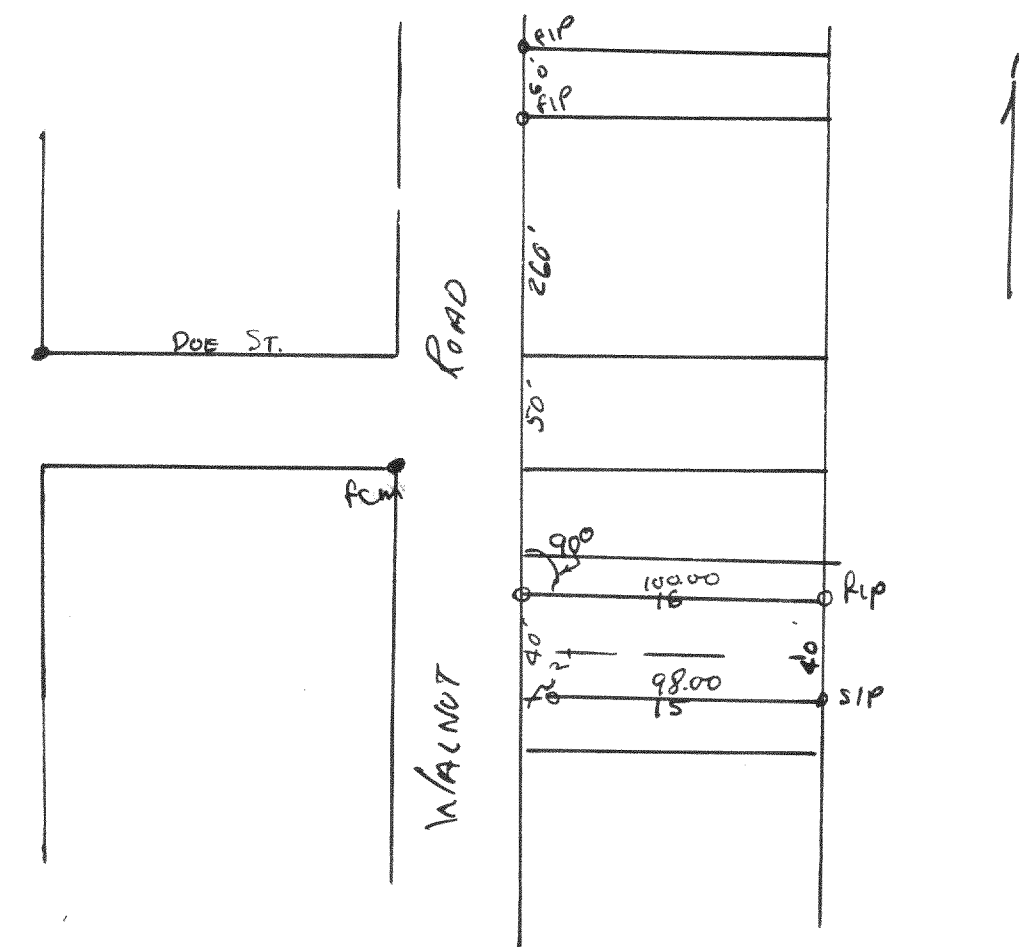

Plot of survey of N $\frac{1}{2}$ Lot 15 & S $\frac{1}{2}$ Lot 16,
Block 63 of Intake Subdivision located in Section
11, T3N R16E of Walworth County, Wisconsin
Sept 21, 1958
Lloyd S. Jensen
County Surveyor