



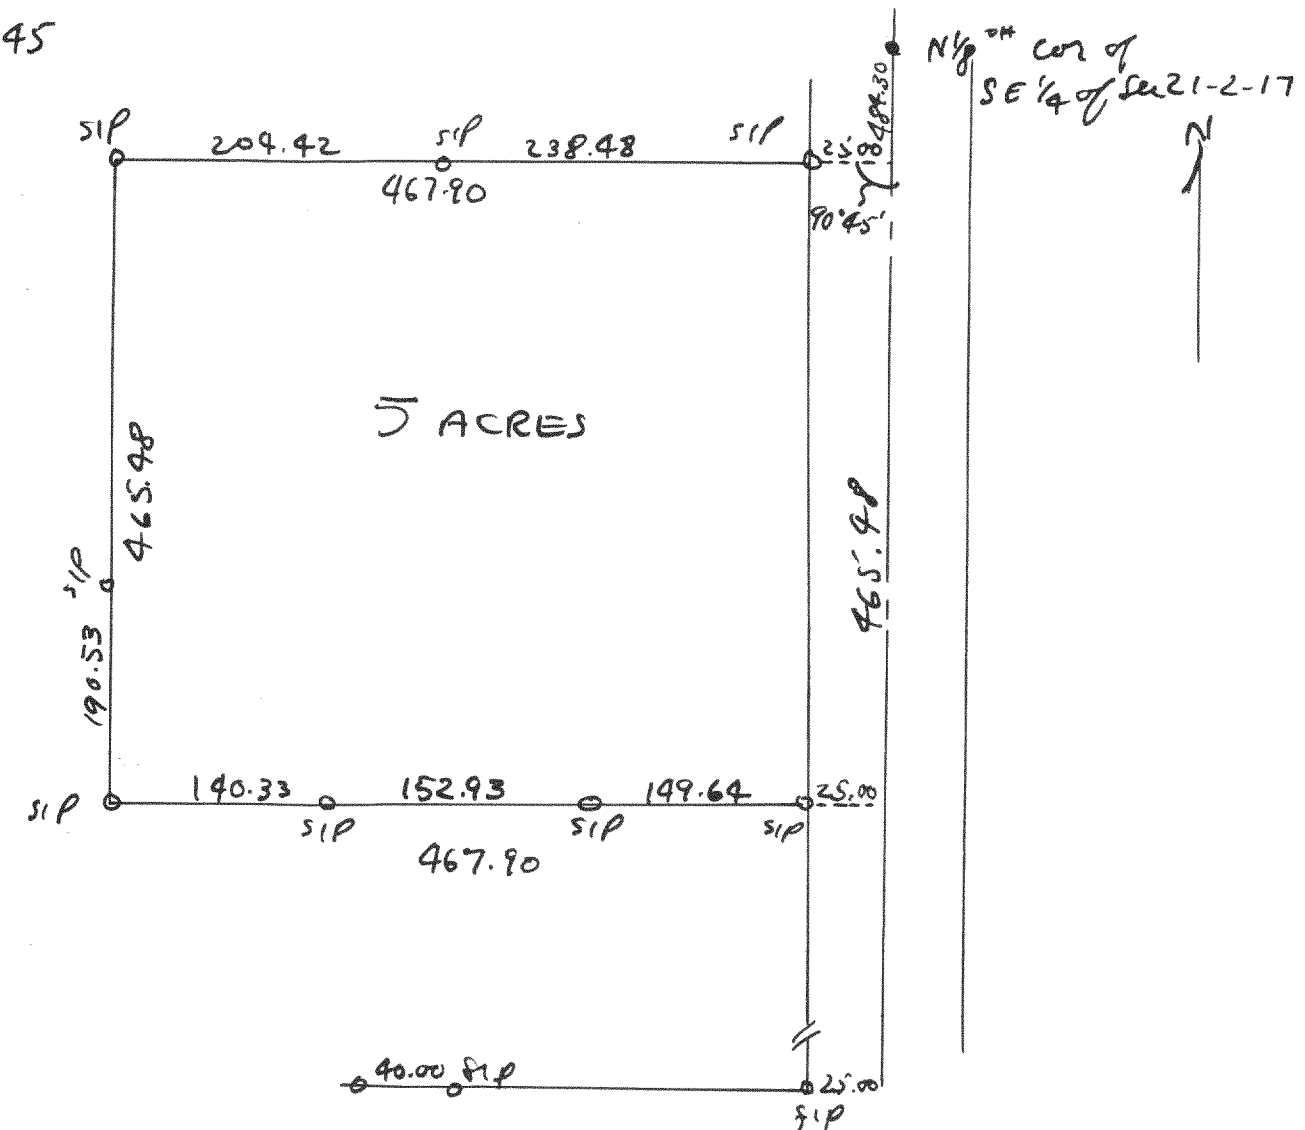

Plat of survey of the same parcel for Cuno School located in
the SE 4 of Sec 21 T2N R1E of Walworth County, Wis.
May 10, 1950
Hoyd L. Jensen
County Surveyor

[illegible]

Plat of survey of Lots 10157-10159 Lake Como
Beach Subd located in Sec 21 & 22
T2N R17E of Walworth County, Wis.
May 12, 1950
Floyd L. Jensen
County Surveyor

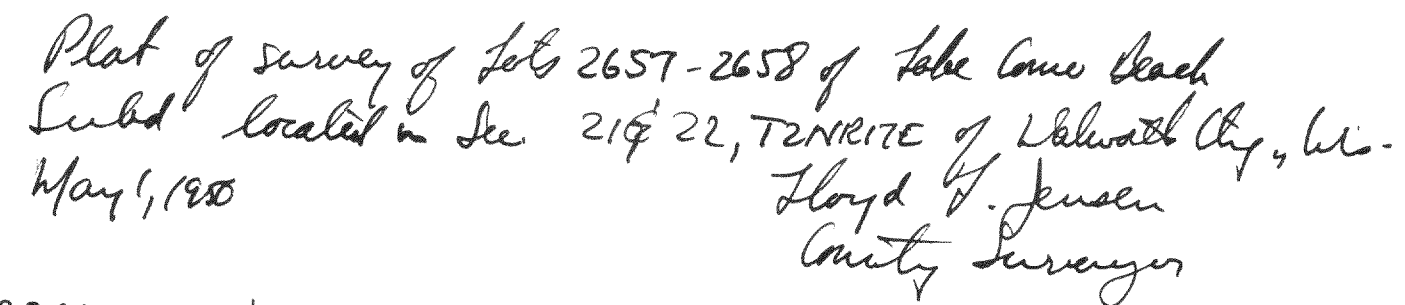

Hand-drawn site plan of a rectangular lot. The lot is bounded by a street to the north and a street to the south. The lot is divided into two main sections by a vertical line. The left section is labeled "100.00" for its width and "788.97" for its depth. The right section is labeled "100.00" for its width and "110.00" for its depth. The total width of the lot is "200.00". The total depth of the lot is "898.97". The lot is labeled "Lincoln" at the bottom. The lot is divided into two main sections by a vertical line. The left section is labeled "100.00" for its width and "788.97" for its depth. The right section is labeled "100.00" for its width and "110.00" for its depth. The total width of the lot is "200.00". The total depth of the lot is "898.97". The lot is labeled "Lincoln" at the bottom. The lot is divided into two main sections by a vertical line. The left section is labeled "100.00" for its width and "788.97" for its depth. The right section is labeled "100.00" for its width and "110.00" for its depth. The total width of the lot is "200.00". The total depth of the lot is "898.97". The lot is labeled "Lincoln" at the bottom.

Plat of Survey of Lots 6598-6599 of
Lake Cowardin Subel located in Sec.
21 & 22, T2N R17E of Wabasha County, Wis.
May 31, 1950
Lloyd A. Jensen
County Surveyor