



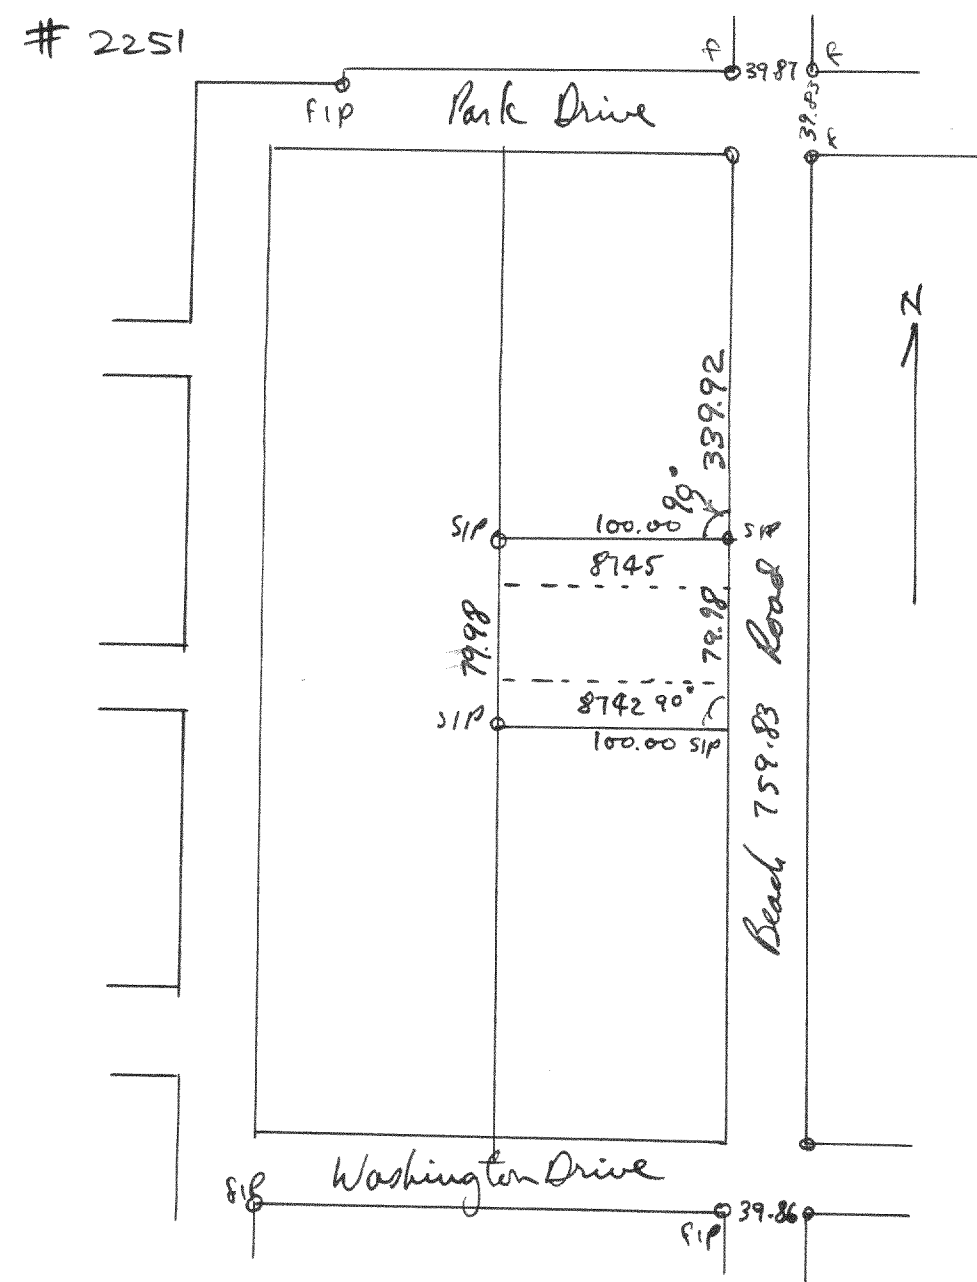

Plat of survey of lots 8742-8745 of Lake Como Beach
 Subd located in Sec 21 & 22 T2N R17E of Walworth
 County, Wisconsin
 Aug 8, 1950

Lloyd S. Jensen
 County Surveyor

2252

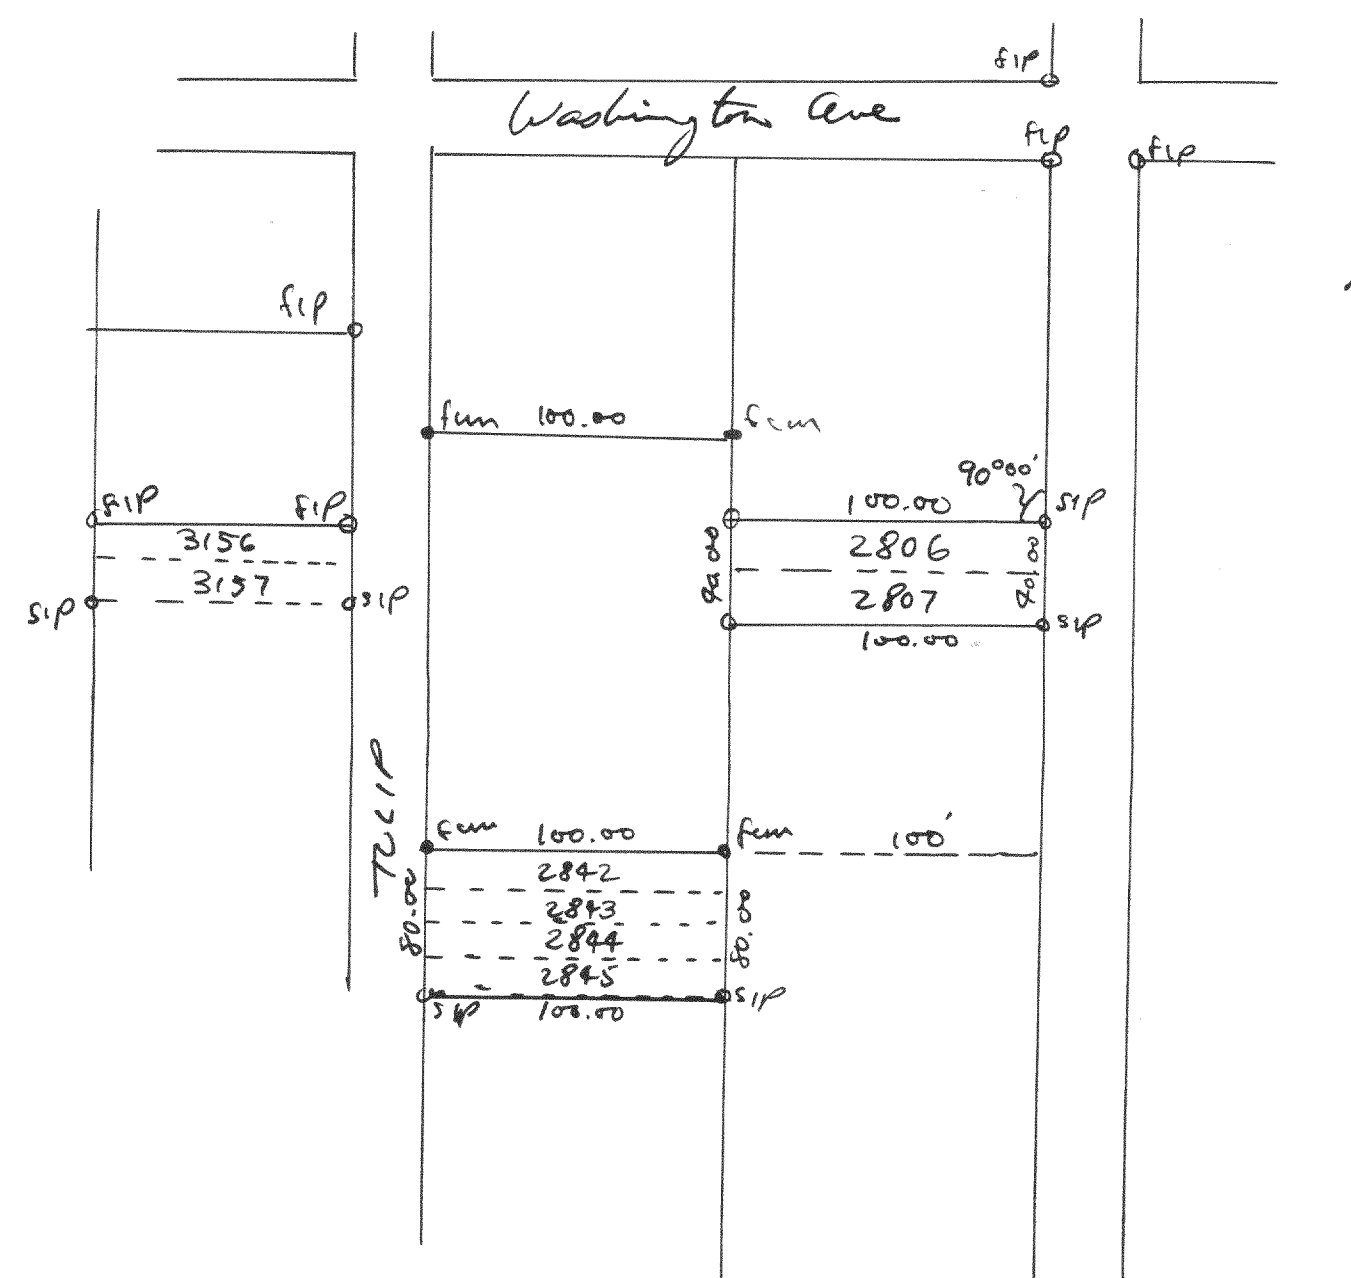

Plat of survey of lots 3156-7, 2842-5, 2806-7, Lake Como Beach
 Subd located in Sec 21 & 22, T2N R17E of Walworth County, Wis.
 Aug 28, 1950

Lloyd S. Jensen
 County Surveyor